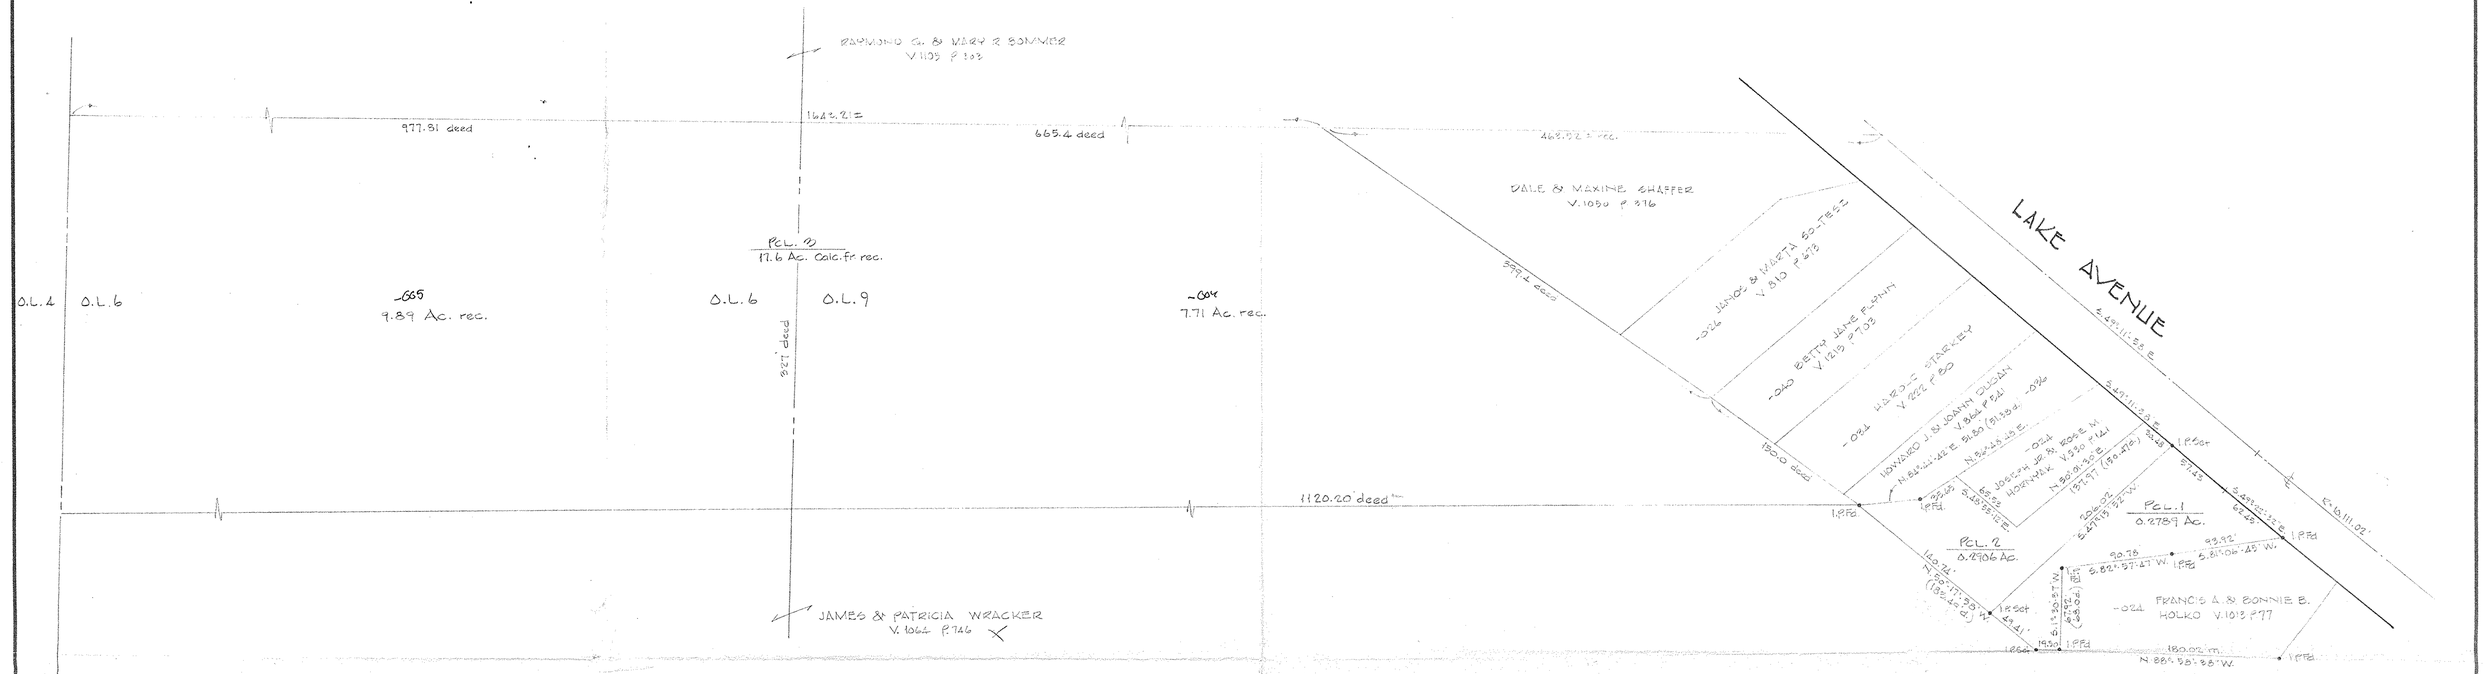


| P.P. NO. 06-23-009-101-005 (024, 051, 052, 028, 038, 039, 040, 024, 038, 004) | |
|---|---|
| SPLIT # 19184 | DATE OF SURVEY |
| MAP PAGE 6-24 | |
| SURVEYOR RODGER G. SIMON (LAUNDON-CAHL & ASSOC.) | |

#19184
APPROVED
LORAIN CO.
MAP DEPT.
DATE 10-23-90
PAGE 6-24
BY CAROLYN FRANCIS
VOID AFTER # 19184

DONE DATE
#19184

APPROVED
LORAIN CO.
MAP DEPT.
DATE 11-30-90
PAGE 6-24
BY T. McNair
VOID AFTER 19184

06-23-009-
SURVEY AND SKETCH FOR -101-

ELIZABETH HORNYAK

PART OF O.L. 6 & O.L. 9 BRACE TRACT TOWNSHIP of ELYRIA
COUNTY of LORAIN STATE of OHIO

SCALE 1"=60' APRIL, 1990

LAUNDON • SIMON • CAHL & ASSOC.
ENGINEERS SURVEYORS

STATE OF OHIO
RODGER G. SIMON
5101
REGISTERED
SURVEYOR

APR 10