


**BAGLEY ROAD 50'
(FORMERLY BEREA ROAD)**

**MAP OF SURVEY
FOR
RIDGEFIELD HOMES**

SITUATED IN THE CITY OF NORTH RIDGEVILLE,
COUNTY OF LORAIN AND STATE OF OHIO AND
KNOWN AS BEING PART OF ORIGINAL RIDGEVILLE
TOWNSHIP LOT NUMBER 1.

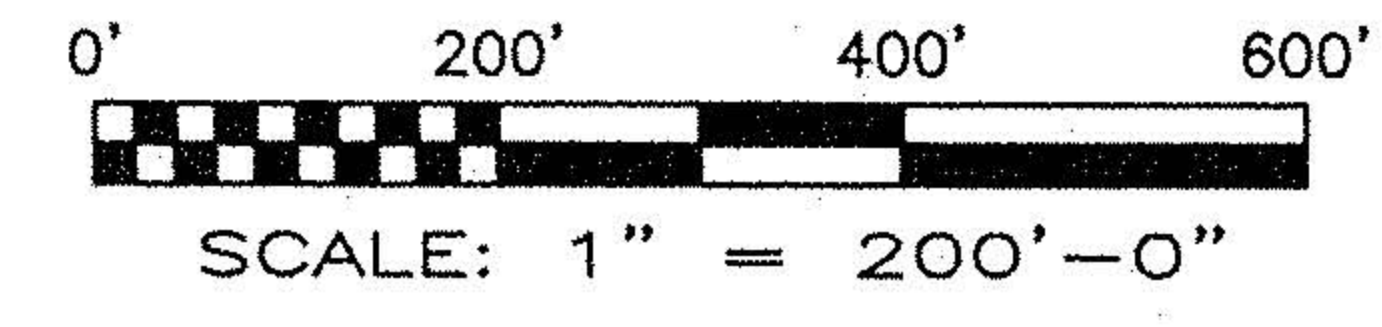

BASED ON A FIELD SURVEY
PERFORMED SEPTEMBER, 2001
OCTOBER 10, 2002

- LEGEND**
- IRON PIN
 - MONUMENT
 - OBSERVED DIMENSION
 - DEED DIMENSION
 - CALCULATED DIMENSION
 - FOUND
 - LORAIN COUNTY DEED RECORDS
 - REBAR
 - ORIGINAL LOT

- PARCEL NO. 07-00-001-000-043 THRU -045
DORIS KIESEL
VOLUME 1219, PAGE 533 L.C.D.R.
- PARCEL NO. 07-00-001-000-046 AND -047
DORIS KIESEL
VOLUME 1219, PAGE 529 L.C.D.R.
- PARCEL NO. 07-00-001-000-038 THRU -041
DORIS KIESEL
VOLUME 1219, PAGE 537 L.C.D.R.
- PARCEL NO. 07-00-001-000-020
LESLIE L. & ROZALIA LACKOFI
VOLUME 958, PAGE 825 L.C.D.R.
- PARCEL NO. 07-00-001-000-029
LESLIE L. & ROZALIA LACKOFI
VOLUME 1365, PAGE 233 L.C.D.R.
- PARCEL NO. 07-00-001-000-027
LAZLO & ISABELLA BARNA
VOLUME 1059, PAGE 869 L.C.D.R.
- PARCEL NO. 07-00-001-000-030
THOMAS & SUSAN DARBY
VOLUME 194, PAGE 451 L.C.D.R.
- PARCEL NO. 07-00-001-000-059
ROBERT HESS
VOLUME 279, PAGE 304 L.C.D.R.
- PARCEL NO. 07-00-001-000-037
PARCEL NO. 07-00-001-102-061
ROBERT HESS
VOLUME 281, PAGE 610 L.C.D.R.
- PARCEL NO. 07-00-001-000-055
ROBERT HESS
VOLUME 1382, PAGE 84 L.C.D.R.

P.P. NO. 7-00-001-162-189-029	
SPLIT # 01235	DATE OF SURVEY Oct 10, 2002
MAP PAGE 700-001-B	
SURVEYOR RICHARD ROY MACKAY.	

No 01235

APPROVED
LORAIN CO.
SEAL DEPT.


DATE 10-23-02

PAGE 7-00-001-B

BY JHAFred

#02-01235

LINE	BEARING	DISTANCE
L1	N 89°05'28" E	24.58'
L2	N 89°54'32" W	52.08'
L3	N 89°05'28" E	19.18'

 

PREPARED BY
MACKAY
Engineering & Surveying Company
7017 Pearl Road, Cleveland, Ohio 44130
(440) 886-4500 (440) 886-4590 Fax



DIMENSIONS SHOWN HEREON ARE EXPRESSED IN FEET AND DECIMAL PARTS THEREOF. BEARINGS ARE TO AN ASSUMED MERIDIAN AND ARE USED TO EXPRESS ANGLES ONLY. MONUMENTS WERE FOUND OR SET AS INDICATED HEREON, ALL OF WHICH I CERTIFY TO BE CORRECT TO THE BEST OF MY ABILITY.

Richard R. Mackay 10 OCT 2002
RICHARD R. MACKAY DATE