P.P. NO.	
07-00-001-000-080, 049, 053	
SPLIT # 13084 13008	DATE OF SURVEY 4.4.79
MAP PAGE 7-00-001-C	
SURVEYOR K.S.A.	

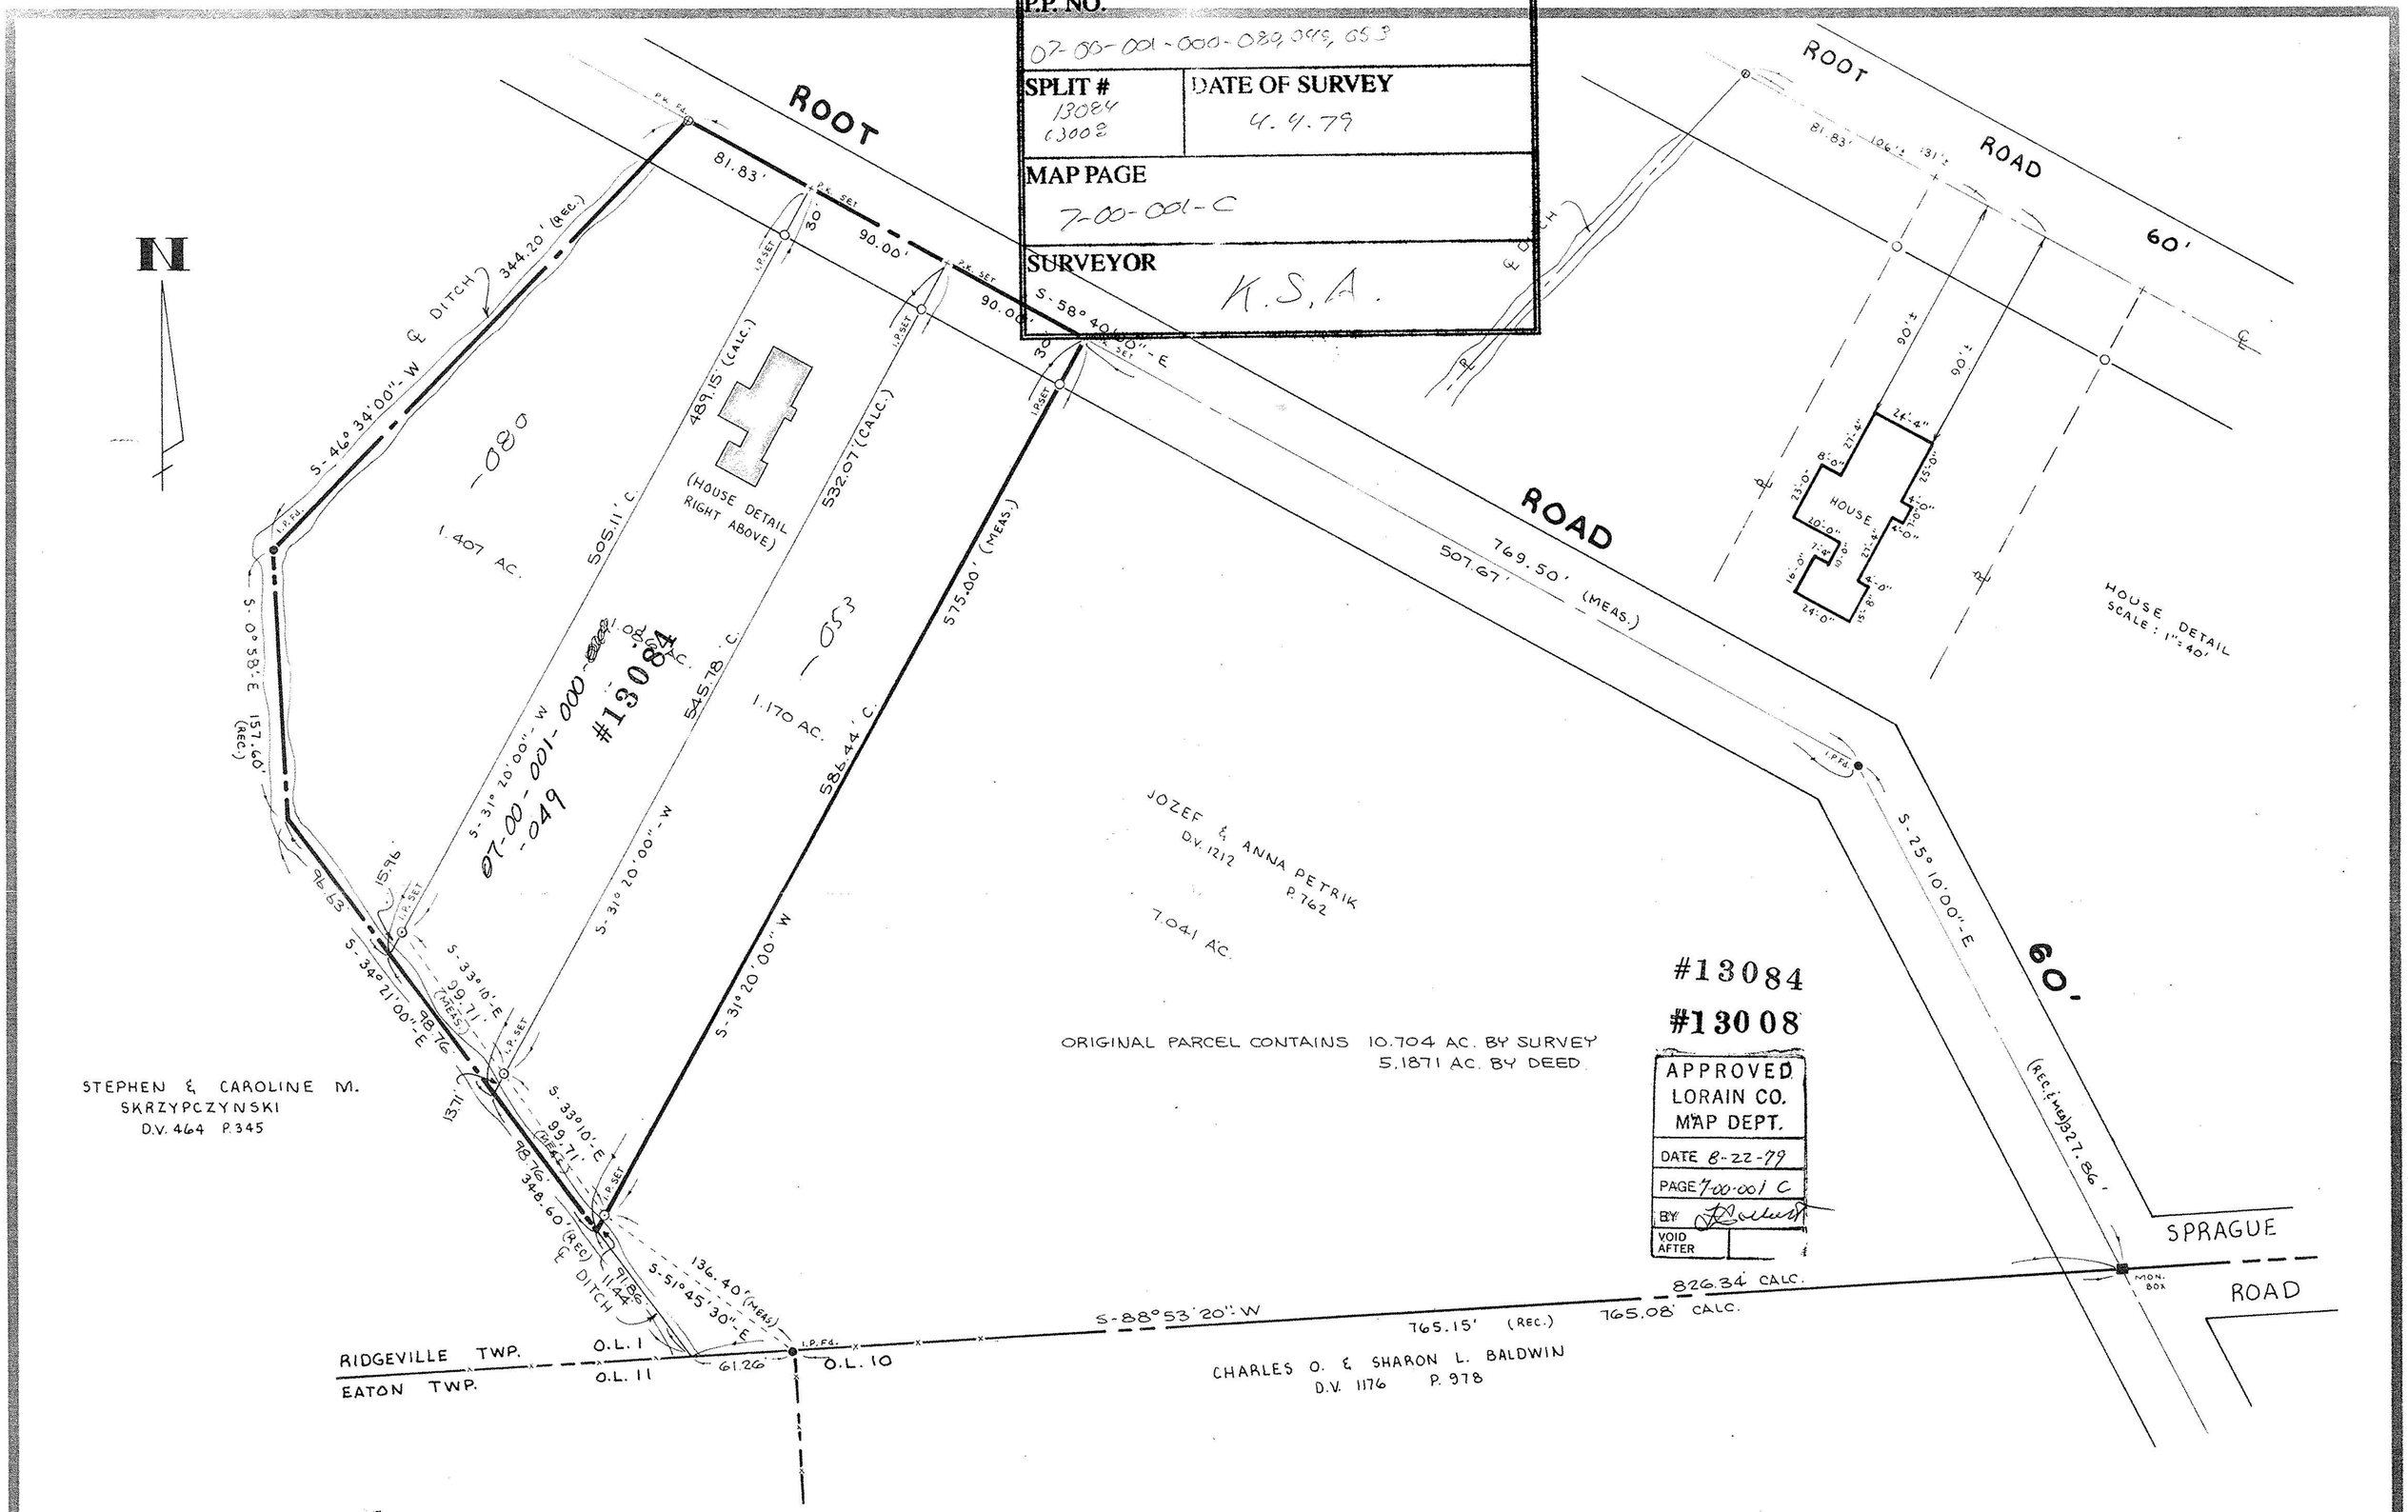

PROJECT

SURVEY MAP

OF PART OF

RIDGEVILLE TOWNSHIP ORIGINAL LOT NO. 1

CITY OF NORTH RIDGEVILLE COUNTY OF LORAIN

STATE OF OHIO

Prepared for: JOE PETRIK

Rev.

Drawn by: P.M.

Checked by:

App. by:

Scale: 1" = 60'

Date: 4·4·79

KLEINOEDER · SCHMIDT and ASSOCIATES

ENGINEERS — SURVEYORS — CONSULTANTS in LAND PLANNING

ELYRIA - NORWALK - MEDINA OHIO

REFERENCES

SHEET NO. of

JOB NO. 79-16