

07-00-001-000

EATON TWP.

RIDGEVILLE TWP.

ON PP

TRIP

ROOT

WABFACE

NOVAEAK

18373

7-11 ACUE RD GO

L 89° 06' 0" W 1778.82 956

1307.58

450.78

90

90

1307.58

450.78

90

90

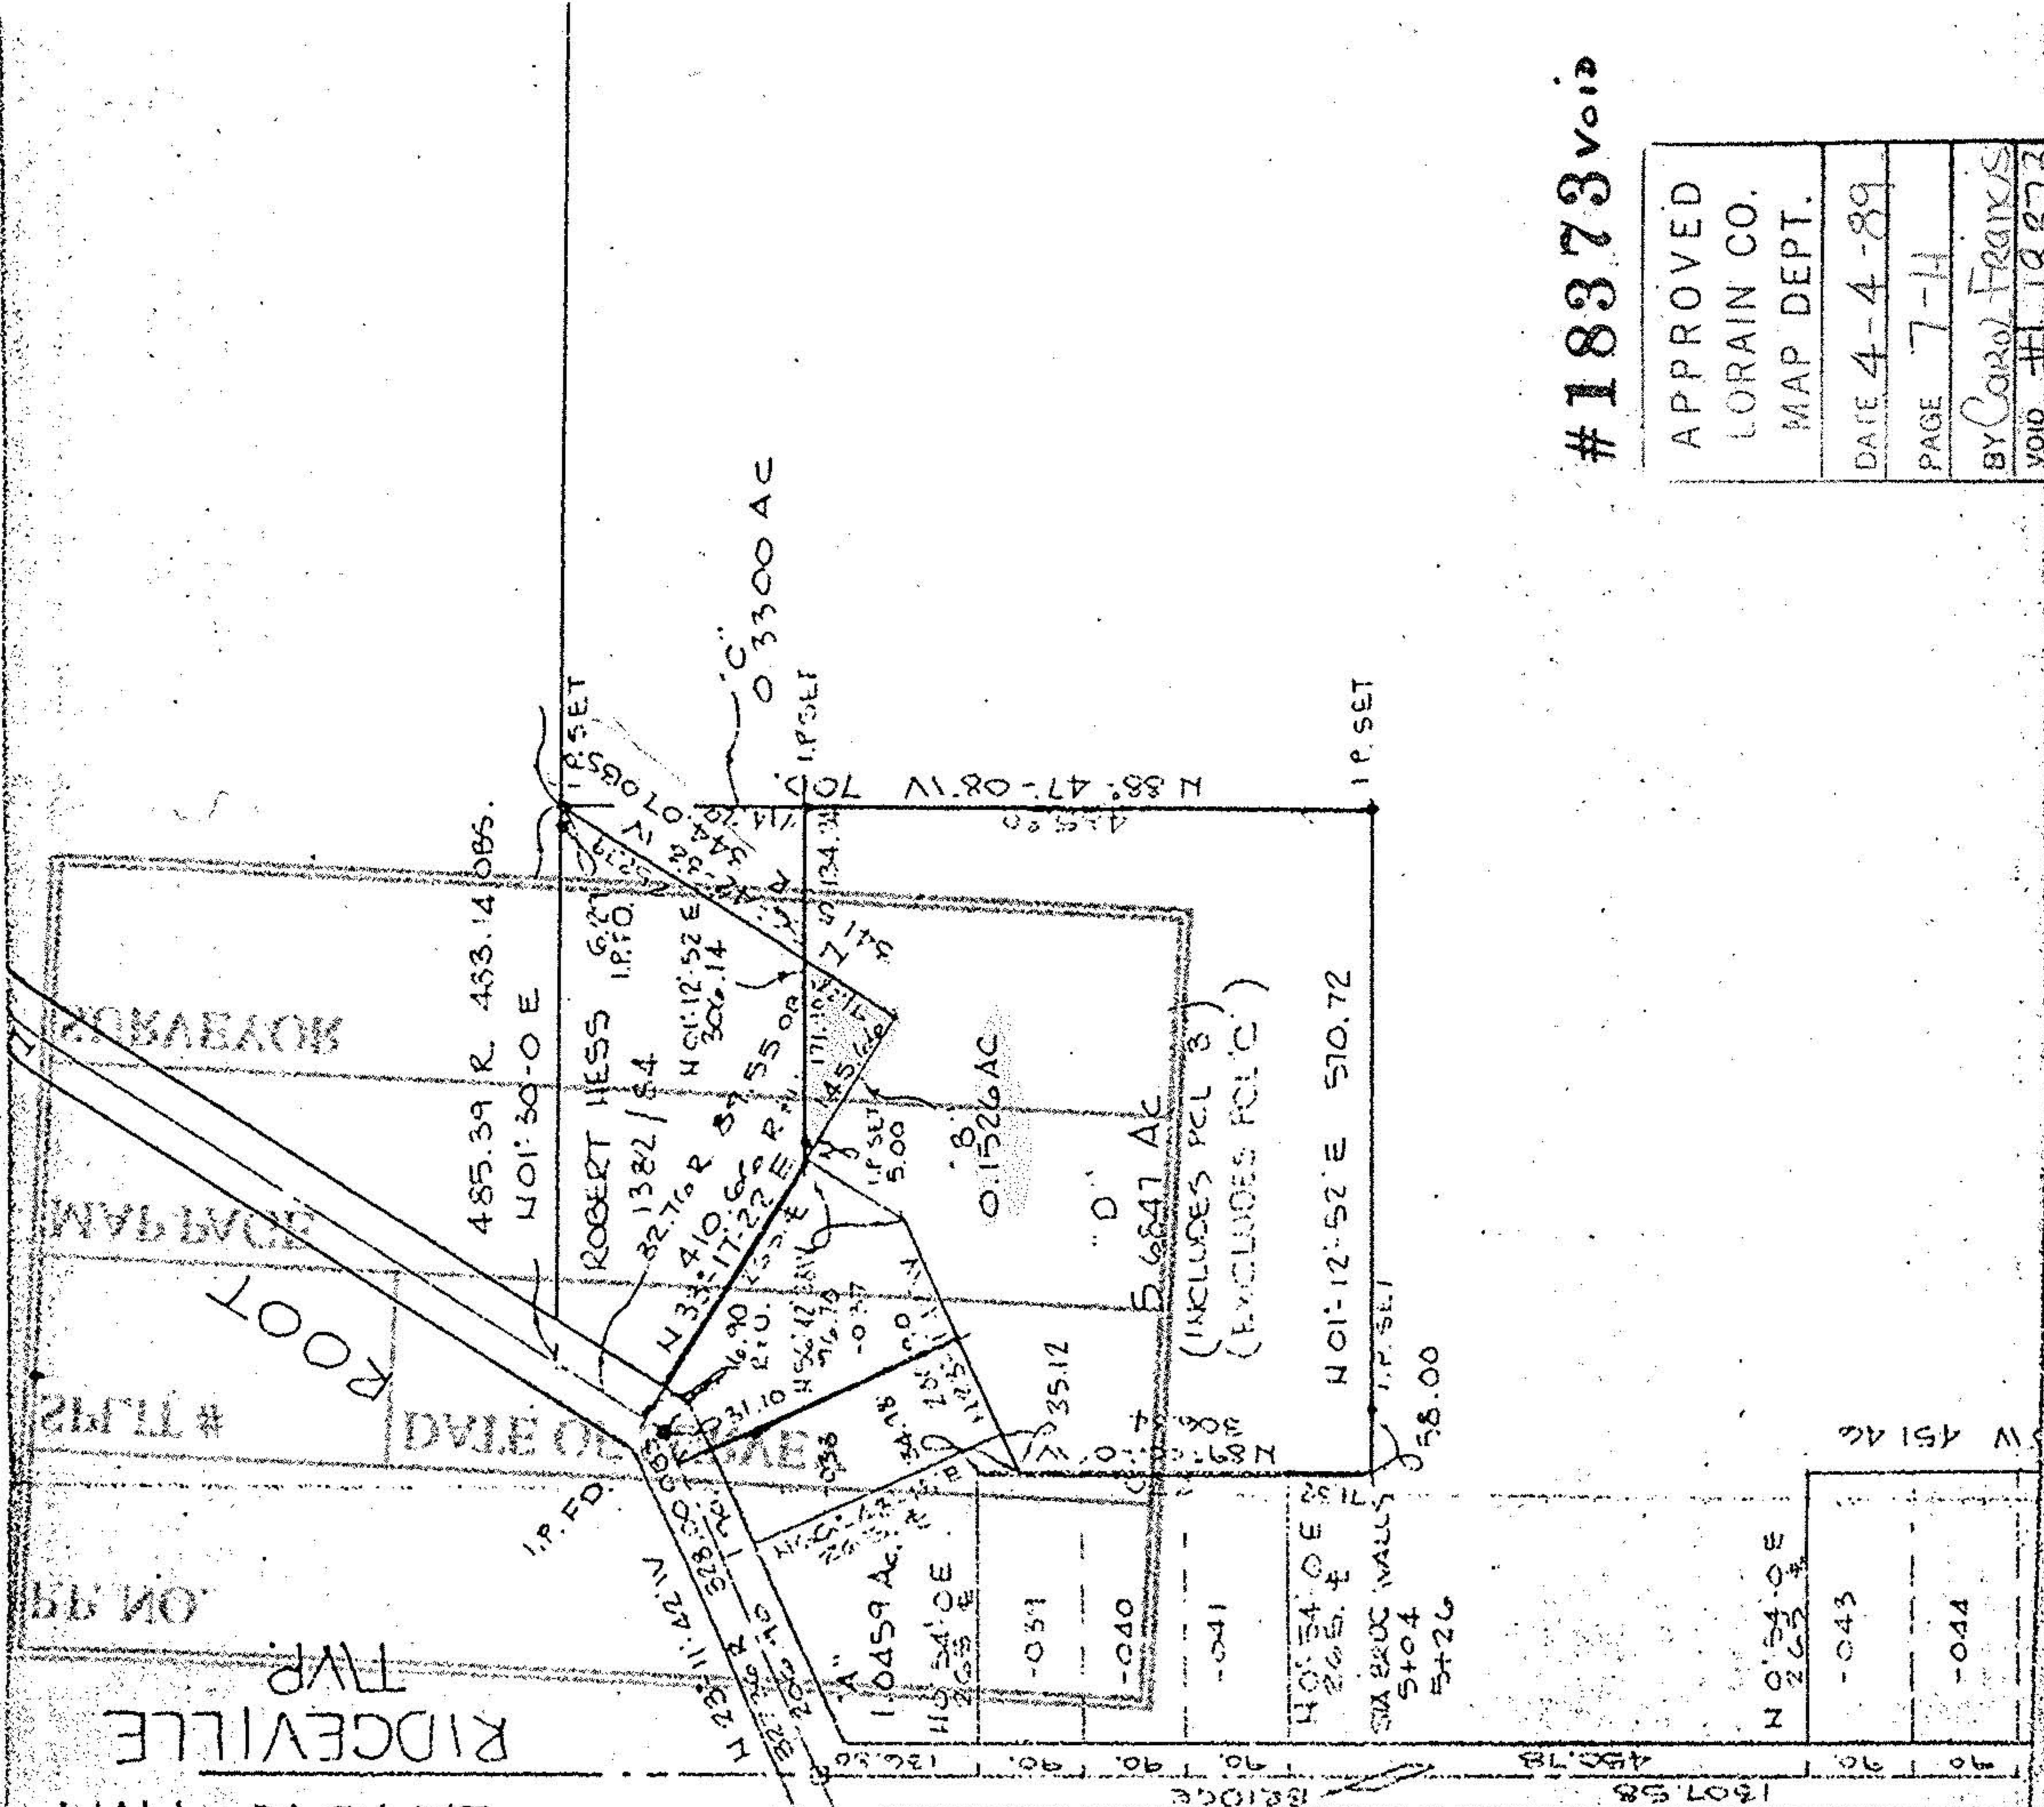

18373 void

| |
|-----------------|
| APPROVED |
| LORAIN CO. |
| MAP DEPT. |
| DATE 4-4-89 |
| PAGE 7-H |
| BY CAROL FRANKS |
| VOID # 18373 |
| AFTER |