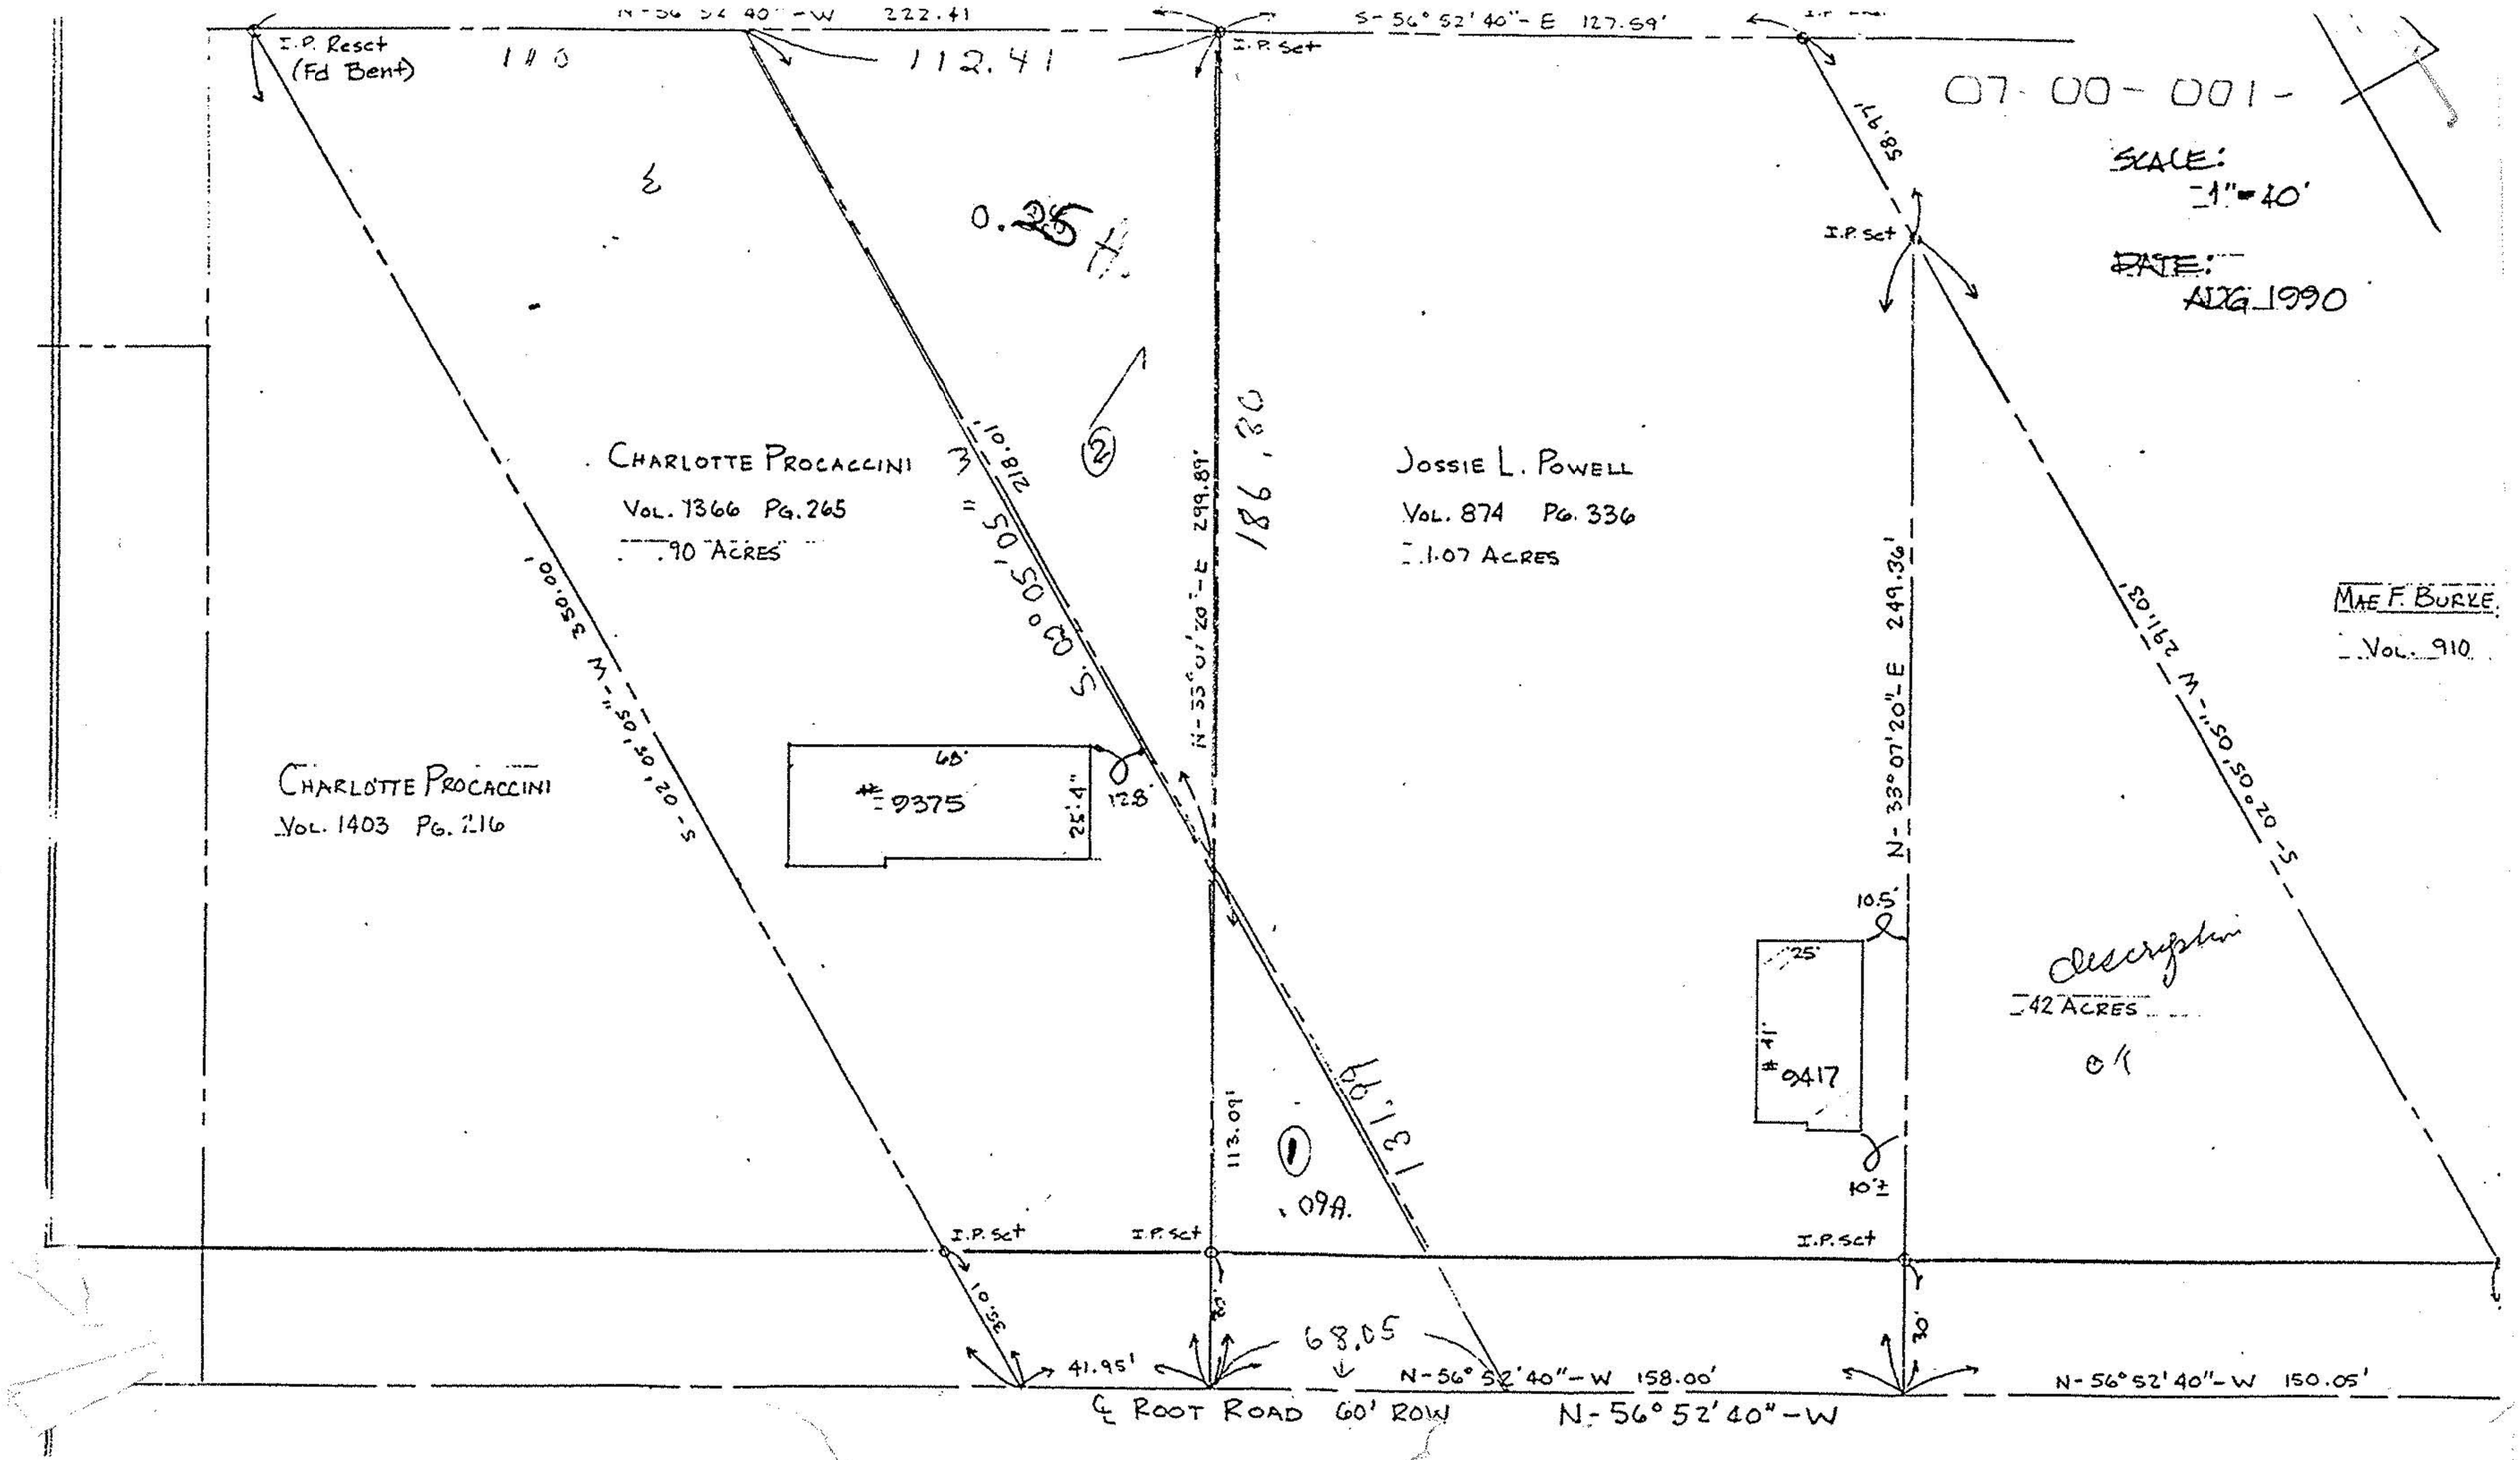

07-00-001-
SCALE: 1"=40'
DATE: AUG 1990
N-56°52'40"-W 222.41
S-56°52'40"-E 127.59'
I.P. Reset (Fd Bent)
I.P. Set
112.41
0.25 A.
CHARLOTTE PROCACCINI
VOL. 1366 PG. 265
.90 ACRES
JOSSIE L. POWELL
VOL. 874 PG. 336
1.07 ACRES
MAE F. BURKE
VOL. 910
CHARLOTTE PROCACCINI
VOL. 1403 PG. 216
#9375
#9417
68'
25'4"
12.8'
10.5'
25'
41'
10'±
42 ACRES
Description
O/K
S-02°05'05"-W 350.00'
S-02°05'05"-W 218.01'
N-33°07'20"-E 299.89'
N-33°07'20"-E 249.36'
S-02°05'05"-W 291.03'
186.30
131.99
113.09'
.09A.
68.05
41.95'
N-56°52'40"-W 158.00'
N-56°52'40"-W 150.05'
℄ ROOT ROAD 60' ROW
N-56°52'40"-W