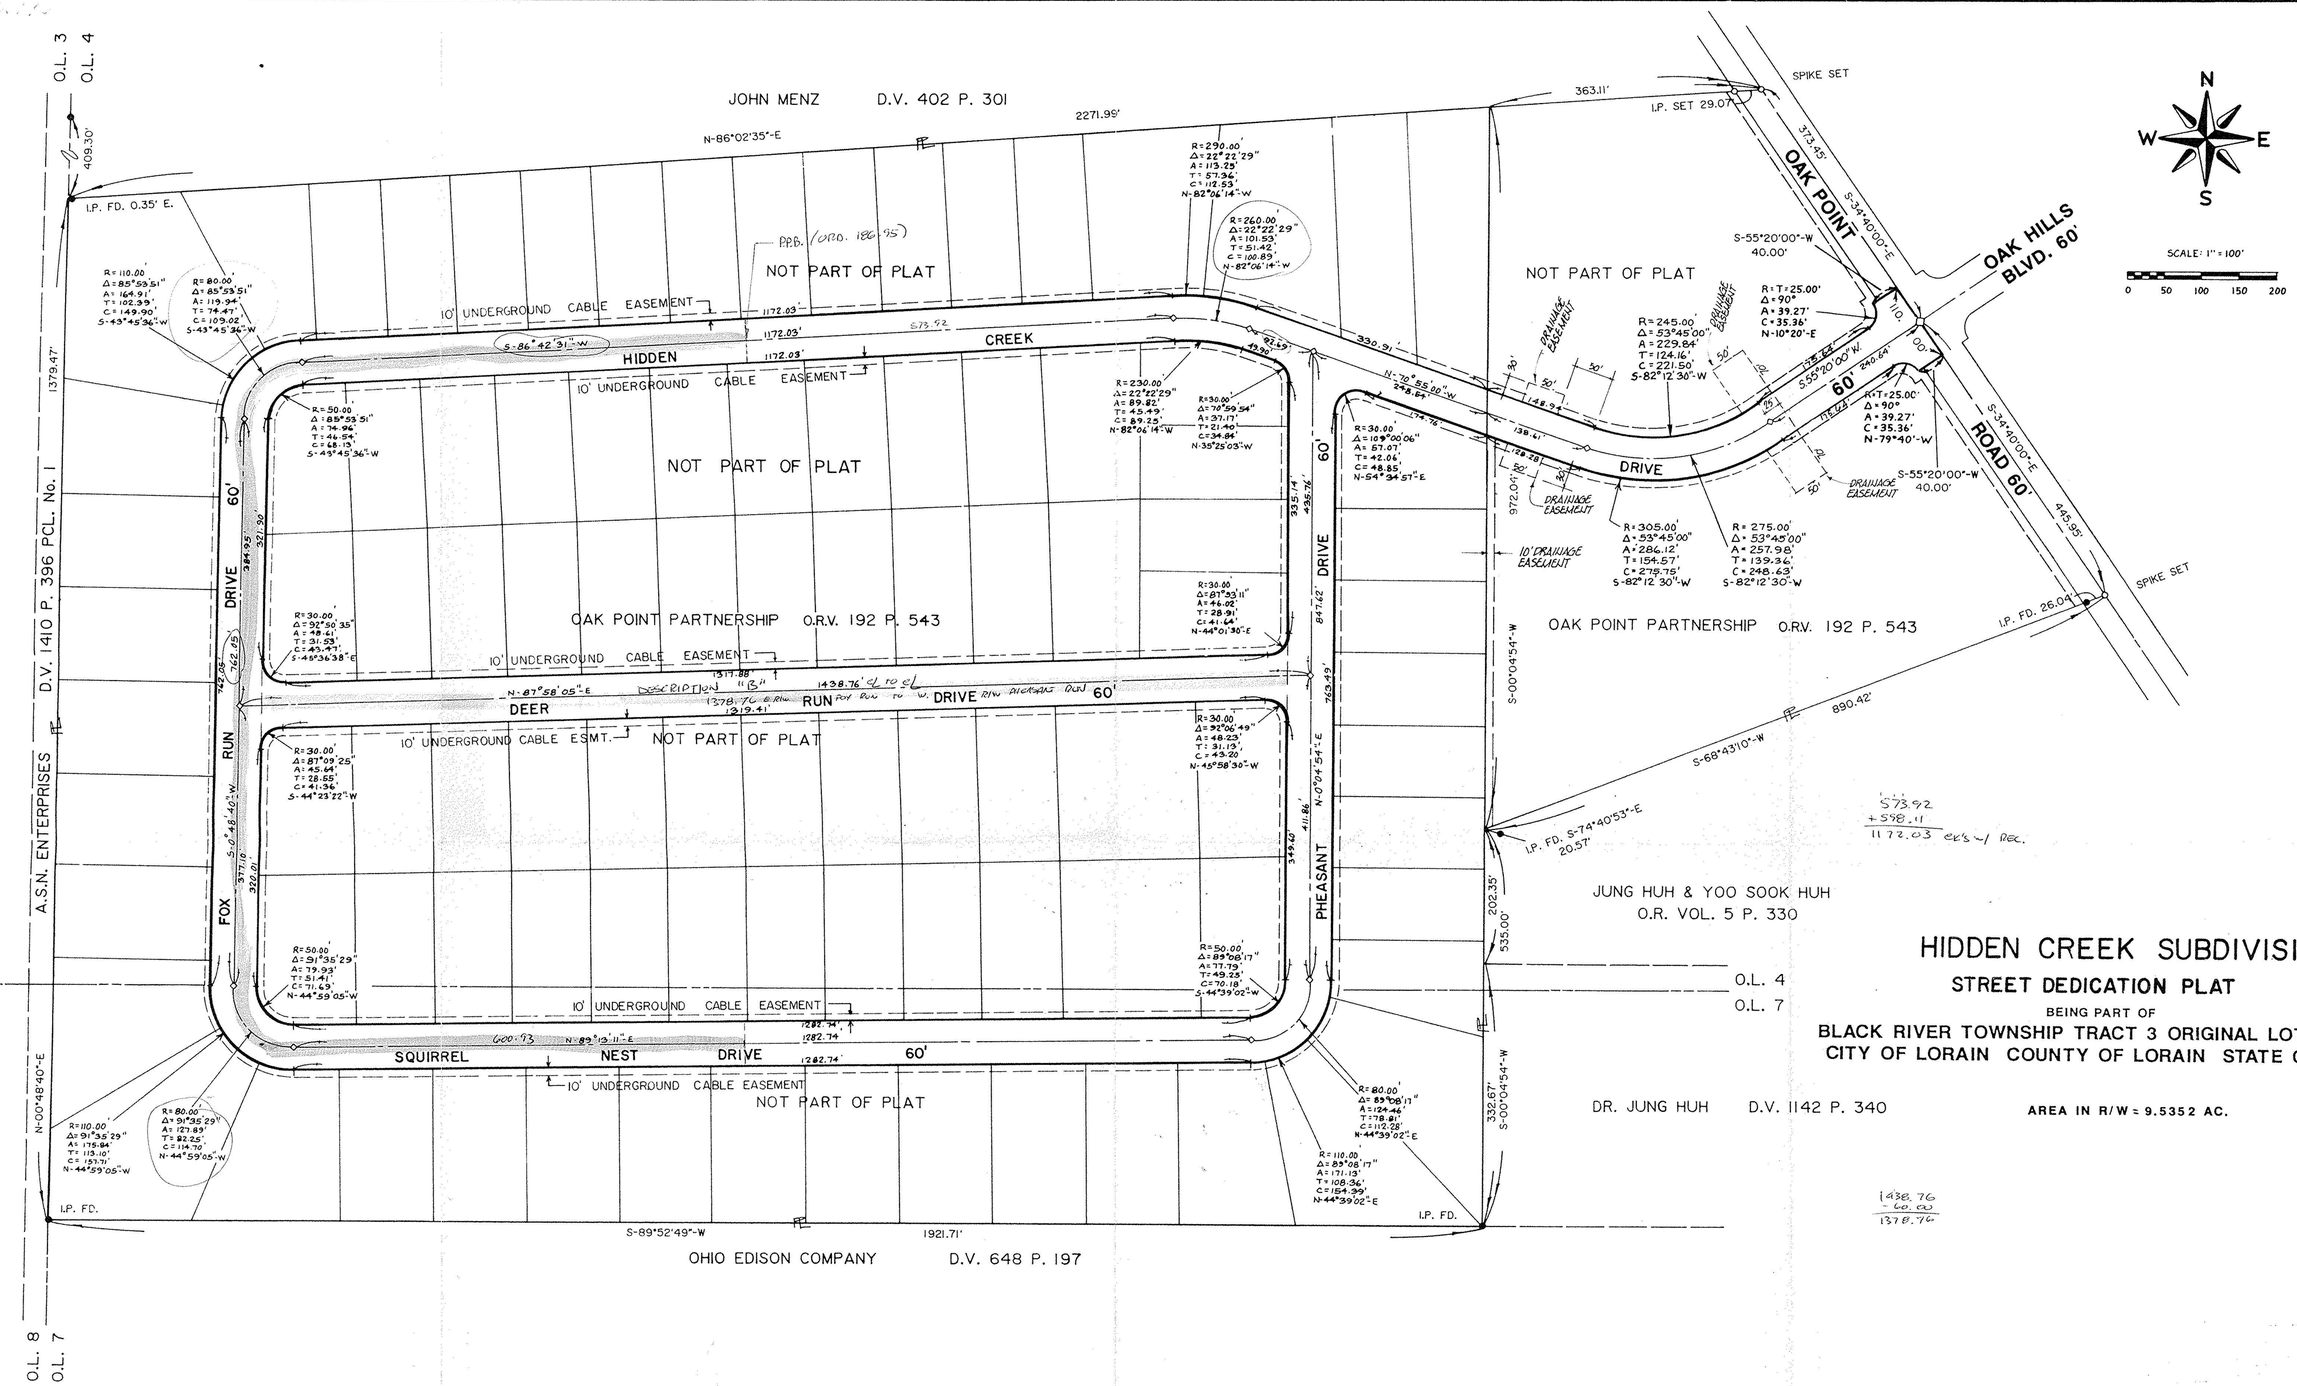


# HIDDEN CREEK SUBDIVISION

## STREET DEDICATION PLAT

BEING PART OF

BLACK RIVER TOWNSHIP TRACT 3 ORIGINAL LOTS 4 & 7
CITY OF LORAIN COUNTY OF LORAIN STATE OF OHIO

AREA IN R/W = 9.5352 AC.

573.92
+598.11
1172.03 ex's w/ Rec.

1438.76
- 60.00
1378.76

| | |
|---|---|
| AREA IN ORIGINAL LOT 4 | 7.4220 AC. |
| AREA IN ORIGINAL LOT 7 | 2.1132 AC. |
| TOTAL AREA IN R/W | 9.5352 AC. |

LORAIN COUNTY TAX MAP DEPARTMENT COPY

| REVISIONS | |
|---|---|
| 4-29-90 | MISCELLANEOUS REVISIONS |
| 8-16-91 | DRAINAGE EASEMENTS |

RIGHT-OF-WAY DEDICATION

RECORD PLAT


KS ASSOCIATES, INC.
ENGINEERS/SURVEYORS
424 Middle Avenue
P.O. Box 89
Elyria, Ohio 44036
Elyria (216) 322-6317 • Lorain (216) 244-5757
ENGINEERS/SURVEYORS KS ASSOCIATES INCORPORATED


SHEET OF

SHEET 2 OF 2

JOB NO. 89-252