

2-03-004-B

Lorain 245-3485 02-03-004-000


02-03-007-000

#9706

2-03-004-B

2E

2-E

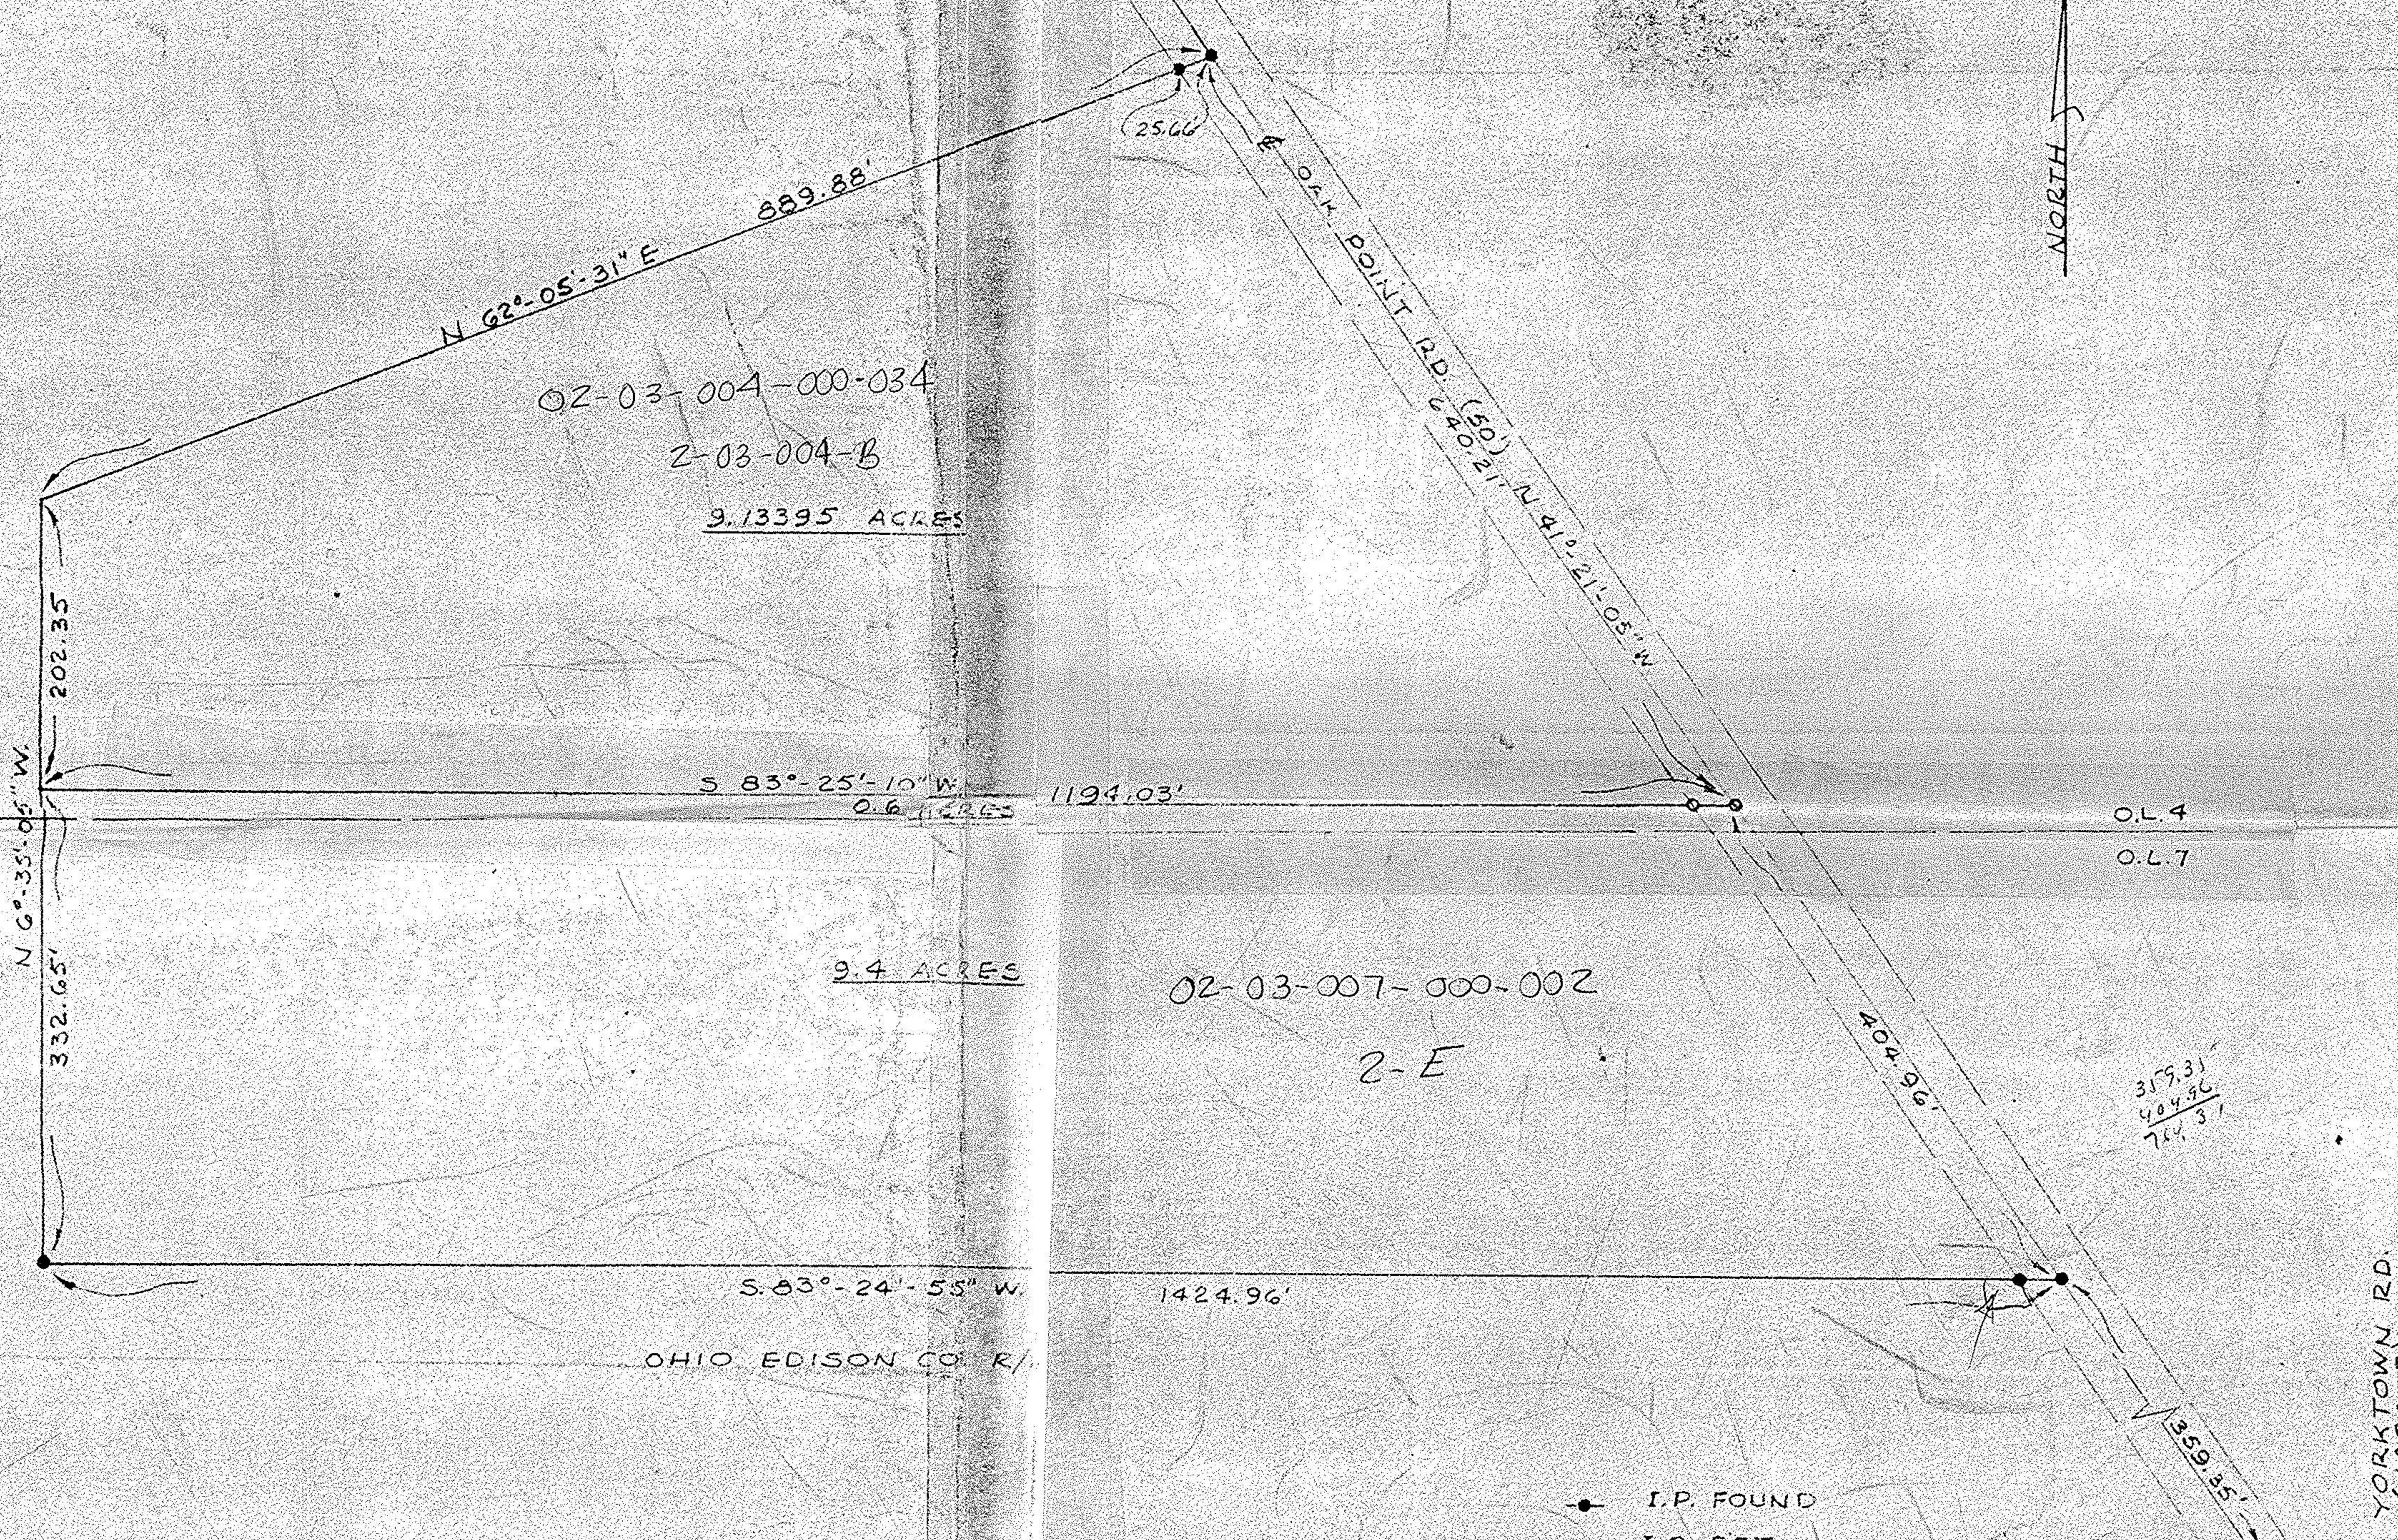

02-03-004-000-034

2-03-004-B

9.13395 ACRES

9.4 ACRES

02-03-007-000-002

2-E

319.31  
484.96  
764.31

● I.P. FOUND  
○ I.P. SET



G. T. MIHUTA  
 OAK POINT ROAD  
 LORAIN OHIO

*Environ Tech Consultants*

ENGINEERS & SURVEYORS & LAND PLANNERS  
 4658 ODELL AVENUE  
 LORAIN, OHIO 44053

AKA Schaefer Assoc  
 7871 4772

PLAT of SURVEY

000-400-80-20  
 000-004-80-20

ORIGINAL LOT	DATE
TOWNSHIP	SCALE
CITY OF	FIELD BOOK
COUNTY OF	DRAWN BY
STATE OF	CHECKED BY
	FILE NO.

2-03-004-B