
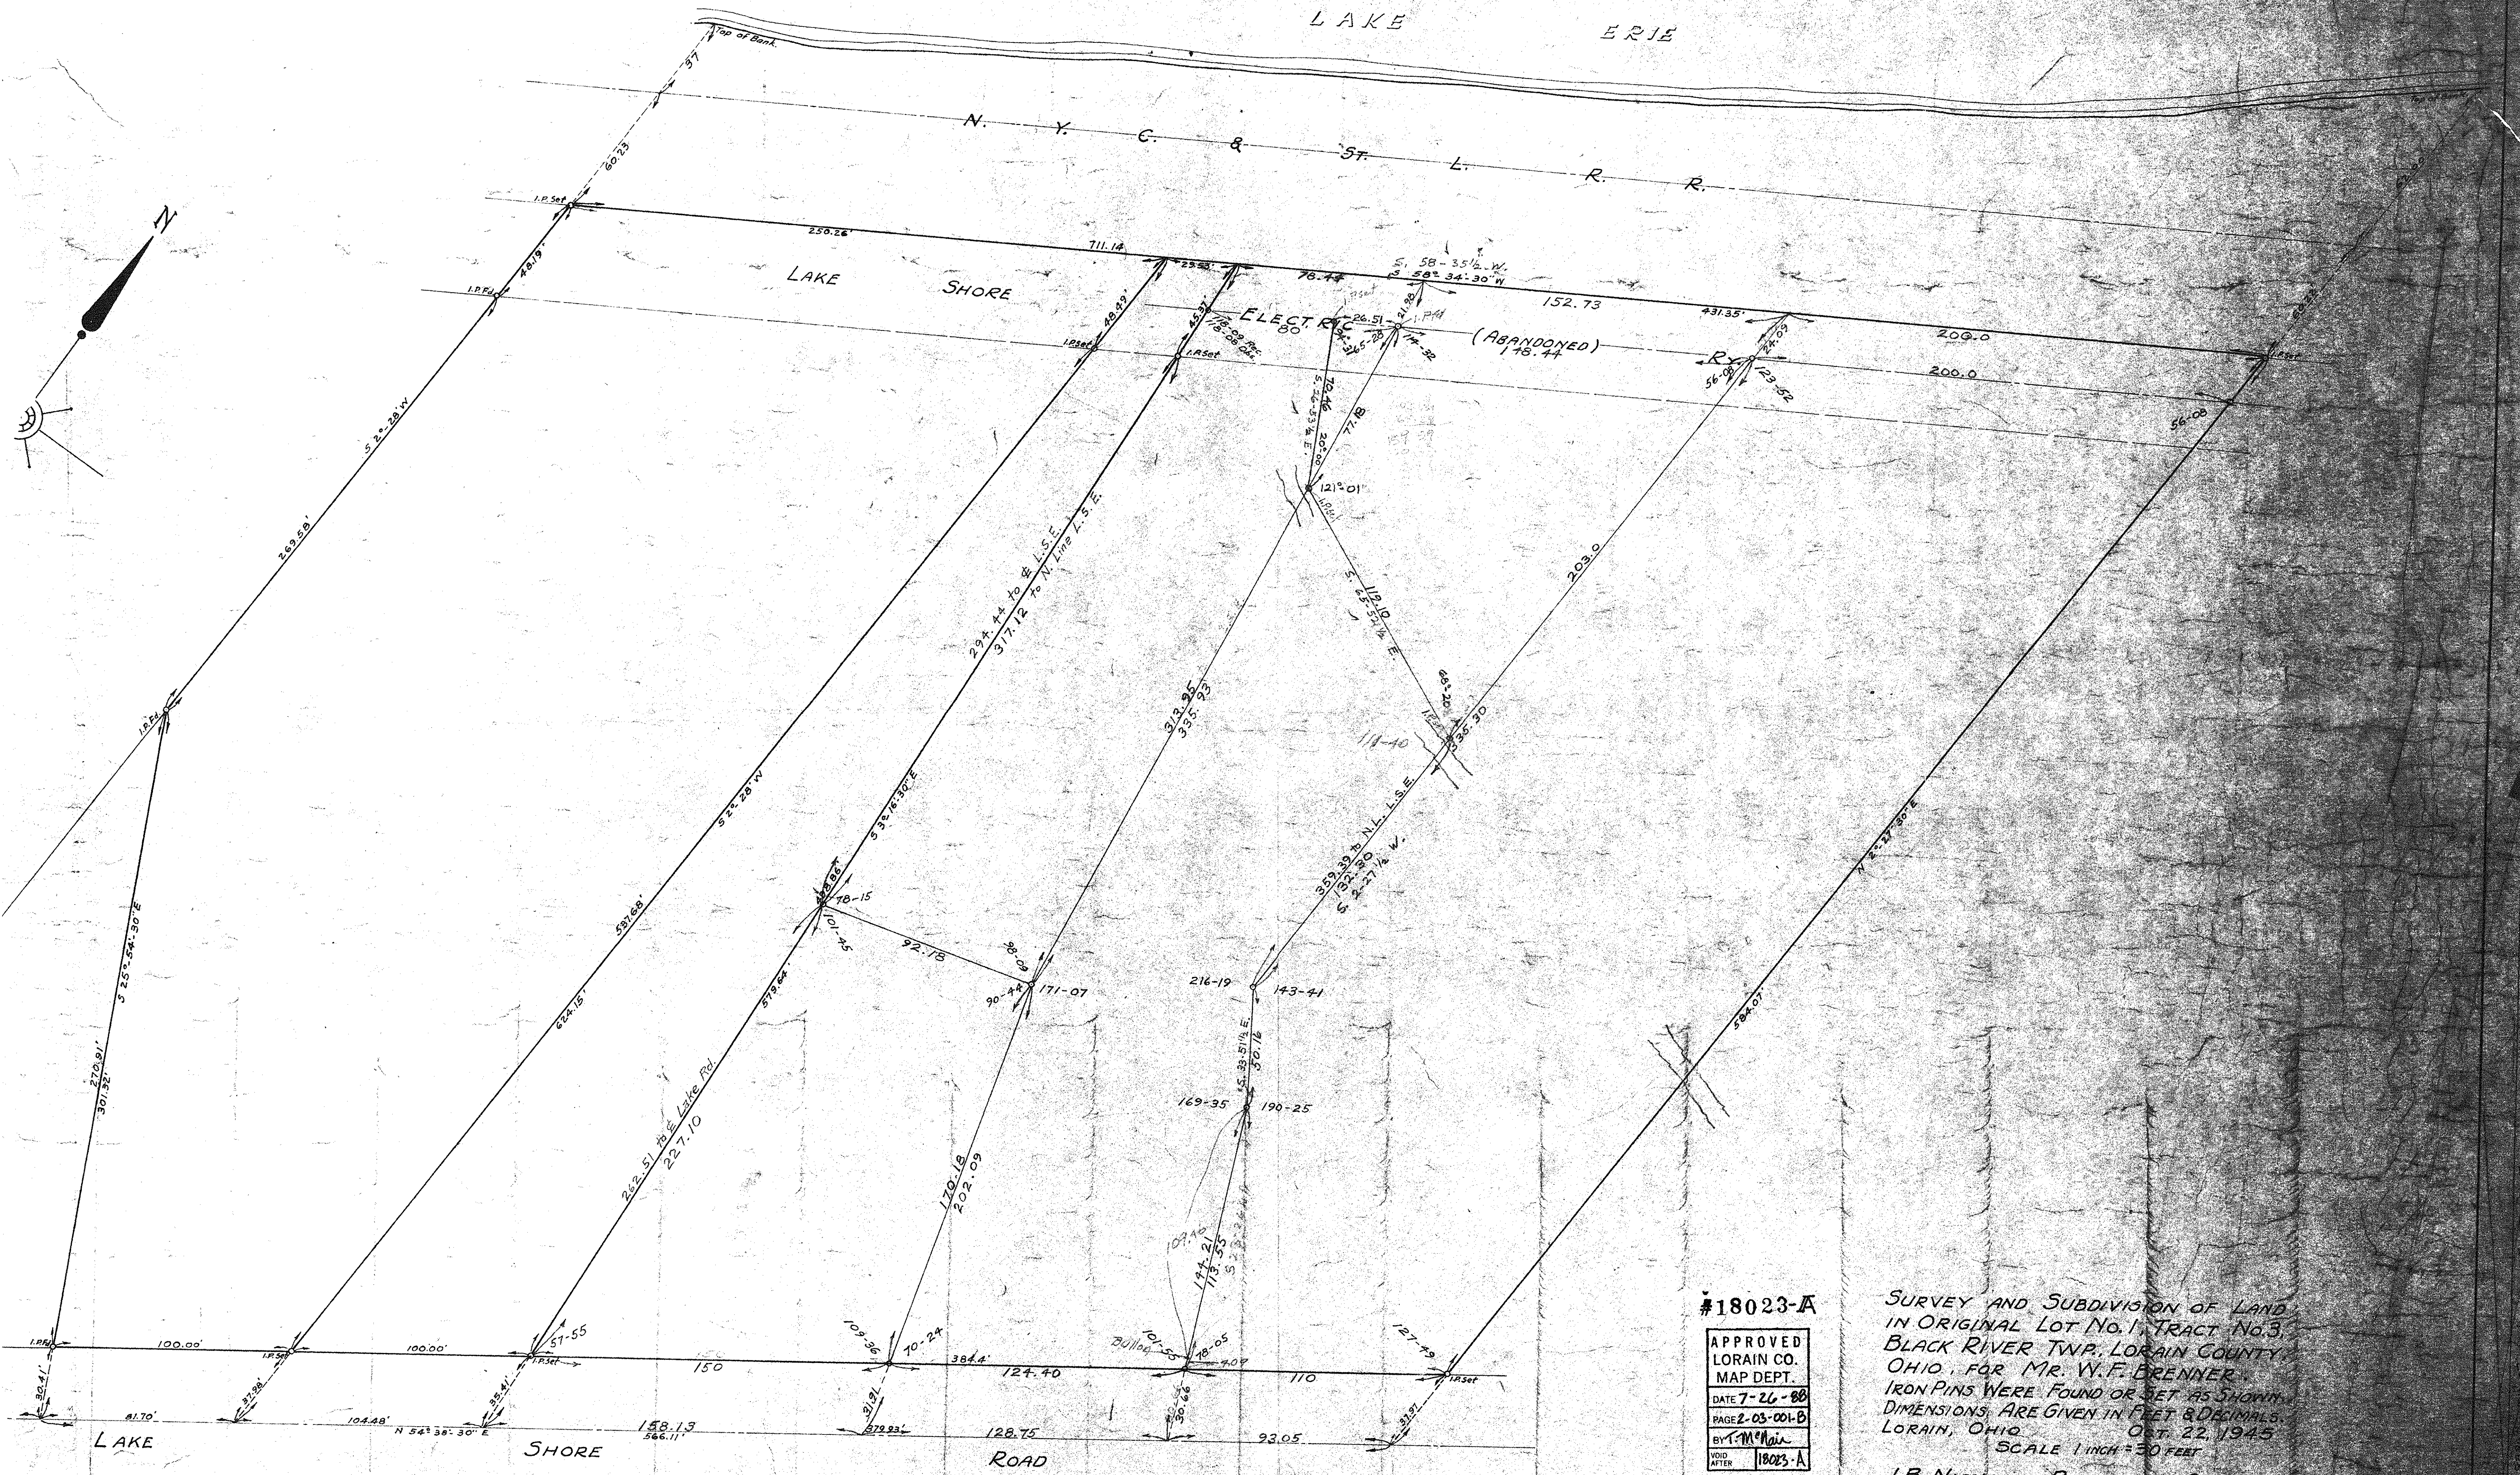


LAKE ERIE

N. Y. C. & ST. L. R. R.

LAKE SHORE

ELECT. R. (ABANDONED)

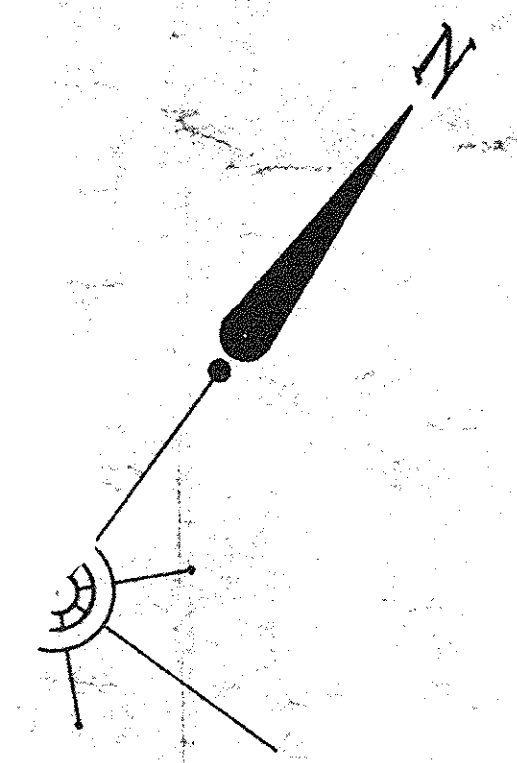

#18023-A

APPROVED
LORAIN CO.
MAP DEPT.
DATE 7-26-88
PAGE 2-03-001-B
BY T. M. Hain
VOID AFTER 18023-A

SURVEY AND SUBDIVISION OF LAND
IN ORIGINAL LOT NO. 1, TRACT NO. 3,
BLACK RIVER TWP., LORAIN COUNTY,
OHIO, FOR MR. W. F. BRENNER.
IRON PINS WERE FOUND OR SET AS SHOWN.
DIMENSIONS ARE GIVEN IN FEET & DECIMALS.
LORAIN, OHIO, OCT. 22, 1945
SCALE 1 INCH = 30 FEET
J. B. NICHOLS - REGISTERED SURVEYOR

2-03-001-B