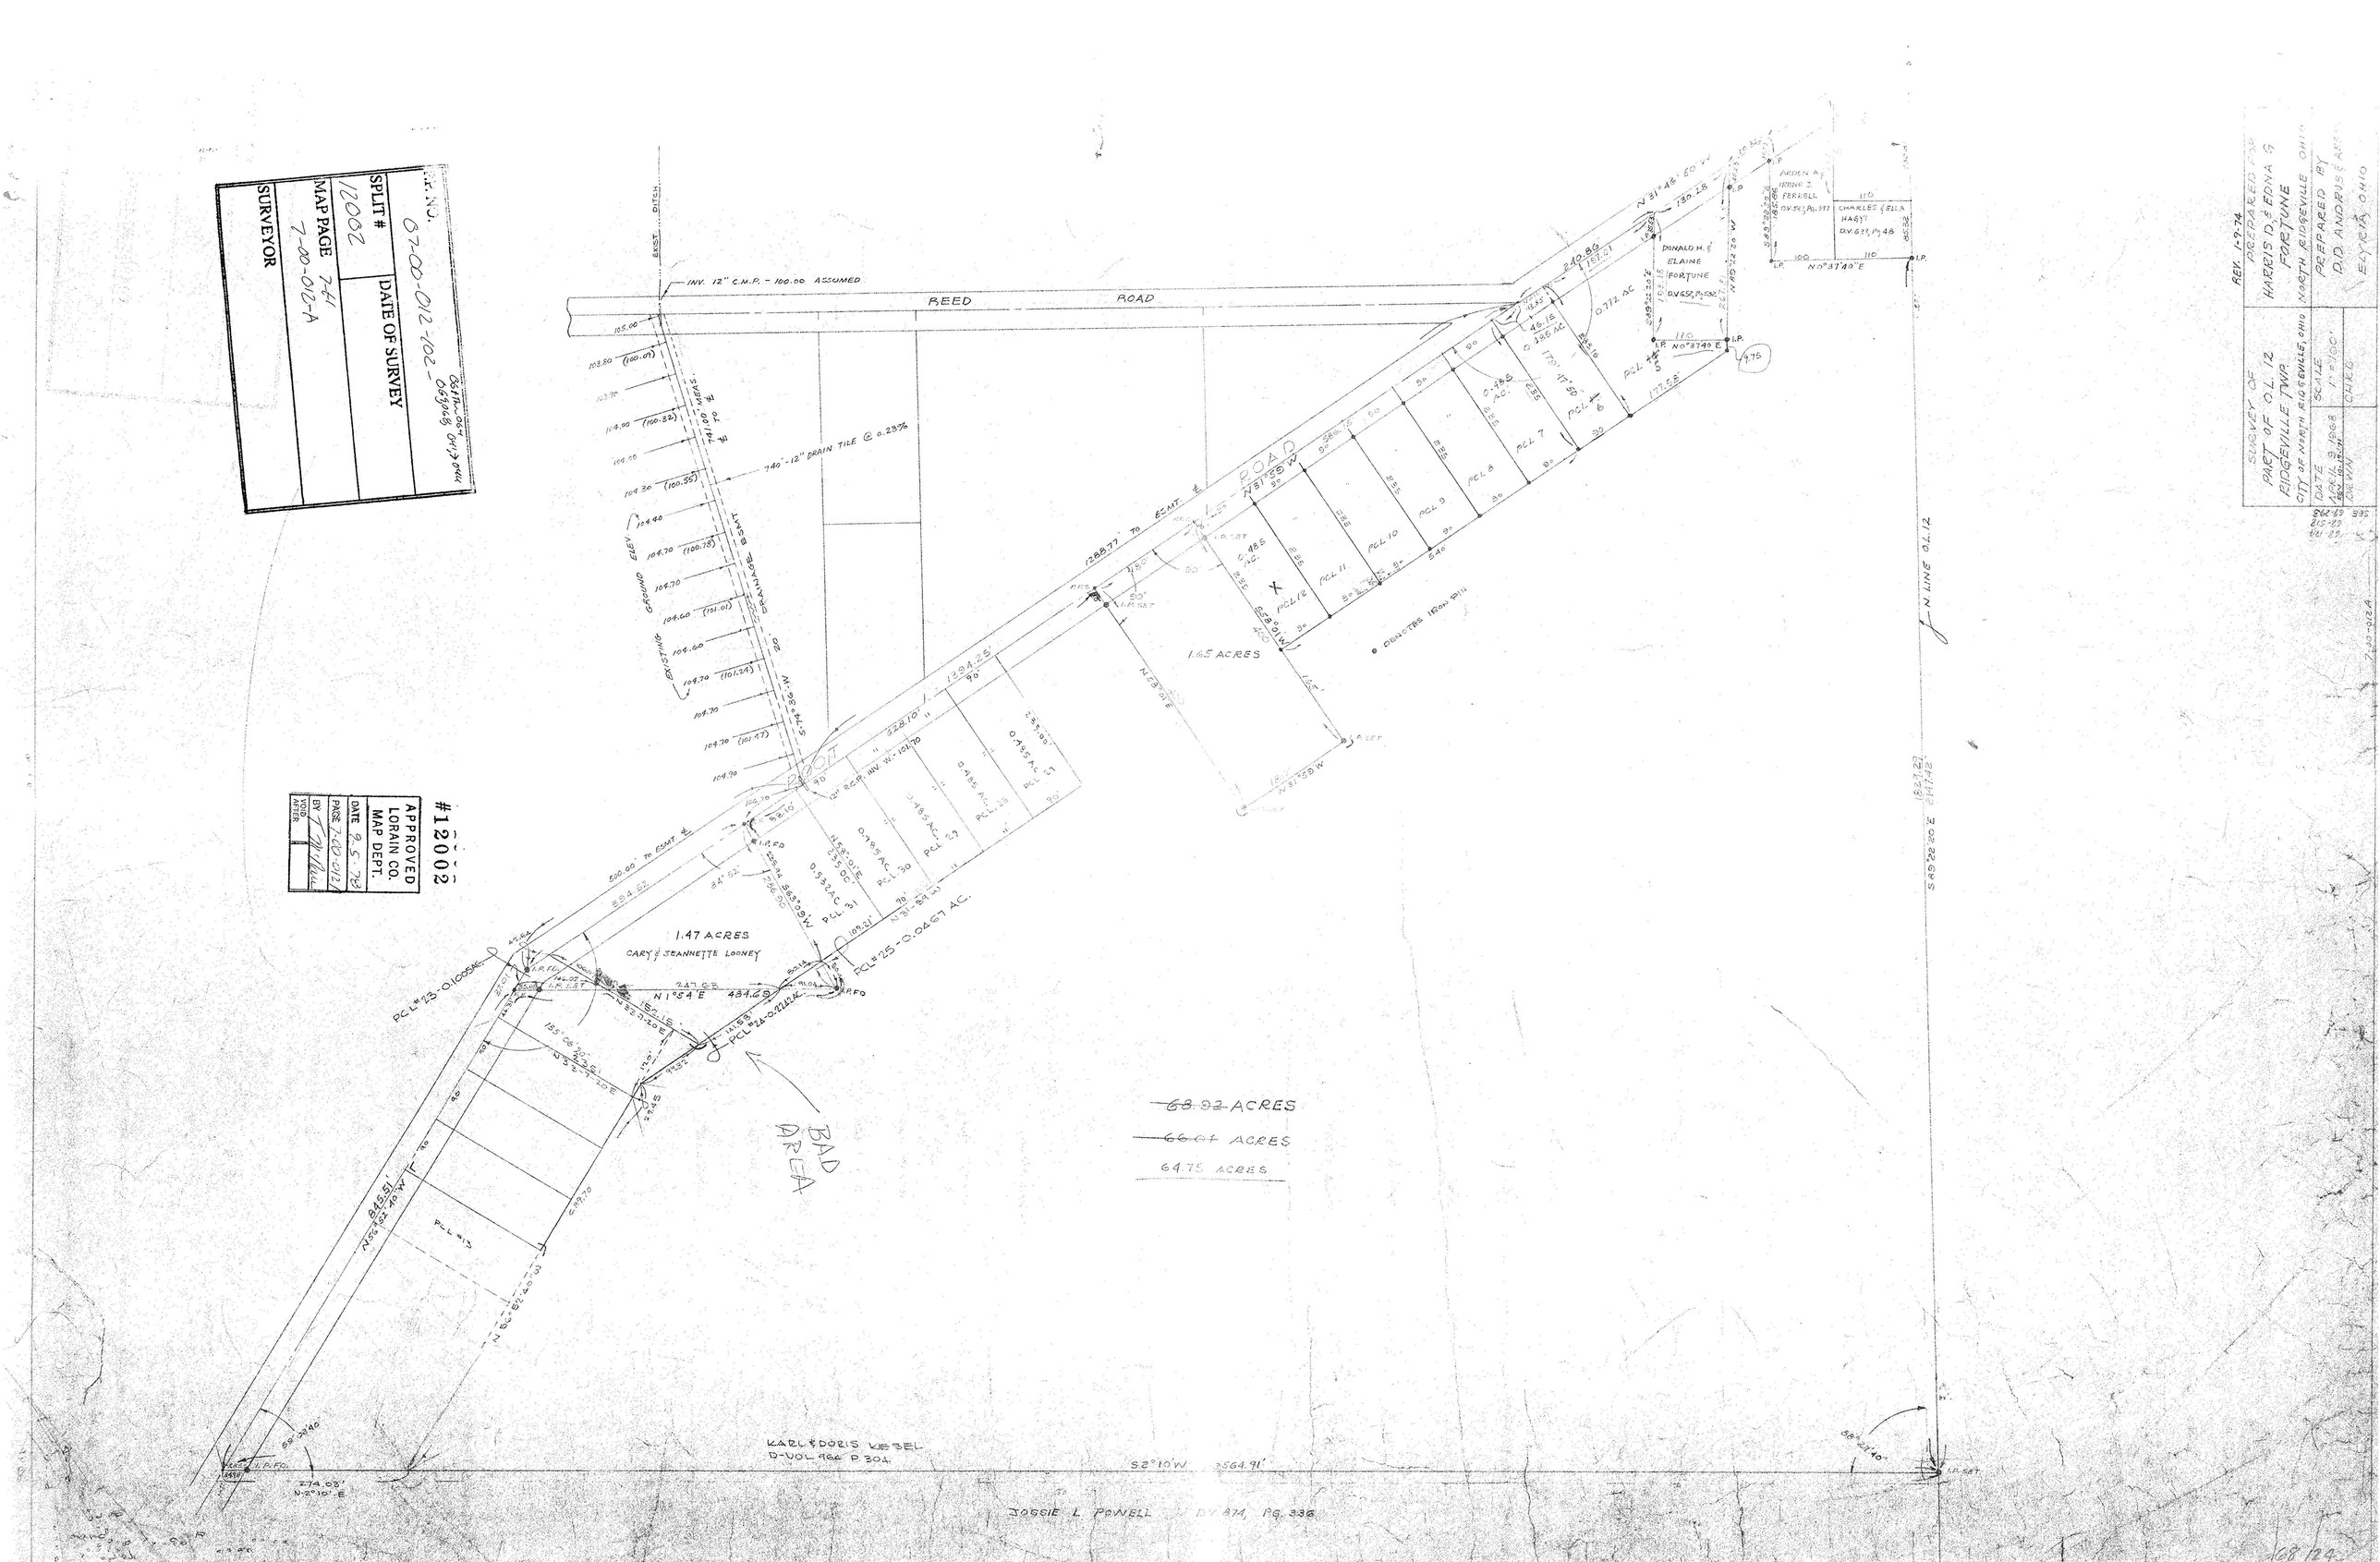
REV. 1-9-74
PREPARED FOR
HARRIS D. & EDNA G. FORTUNE
NORTH RIDGEVILLE OHIO
PREPARED BY
D.D. ANDRUS & ASS.
ELYRIA, OHIO
SURVEY OF
PART OF O.L. 12
RIDGEVILLE TWP.
CITY OF NORTH RIDGEVILLE, OHIO
DATE
SCALE
1"=100'
CHKD
DRAWN
BEED ROAD
INV. 12" C.M.P. - 100.00 ASSUMED
740'-12" DRAIN TILE @ 0.23%
DRAINAGE EASMT.
EXISTING GROUND
1.65 ACRES
1.47 ACRES
CARY & JEANNETTE LOONEY
68.92 ACRES
66.01 ACRES
64.75 ACRES
BAD AREA
KARL & DORIS WESEL
D-VOL. 966 P. 304
JOSSIE L. POWELL
N LINE O.L. 12
APPROVED
LORAIN CO.
MAP DEPT.
DATE 9-5-78
PAGE 7-00-012
#12002
SPLIT #
12002
DATE OF SURVEY
MAP PAGE
7-41
7-00-012-A
SURVEYOR