LAUNDON . SIMON . CAHL & ASSOC. INC.
CONSULTING ENGINEERS & SURVEYORS
219 COURT ST. ELYRIA, OHIO 44035

SURVEY FOR:

ROBERT P. GRIMMER

Orig. Lot 89	City of	Date JUNE 23,'88 Scale 1"=100'
Orig. Sec	Village of	Dwn. by R.G.S. Chkd. by C.J.
Tract	County of LORAIN	Job No. 88-1735 F.B.
Township of EATON	State of OHIO	Printed

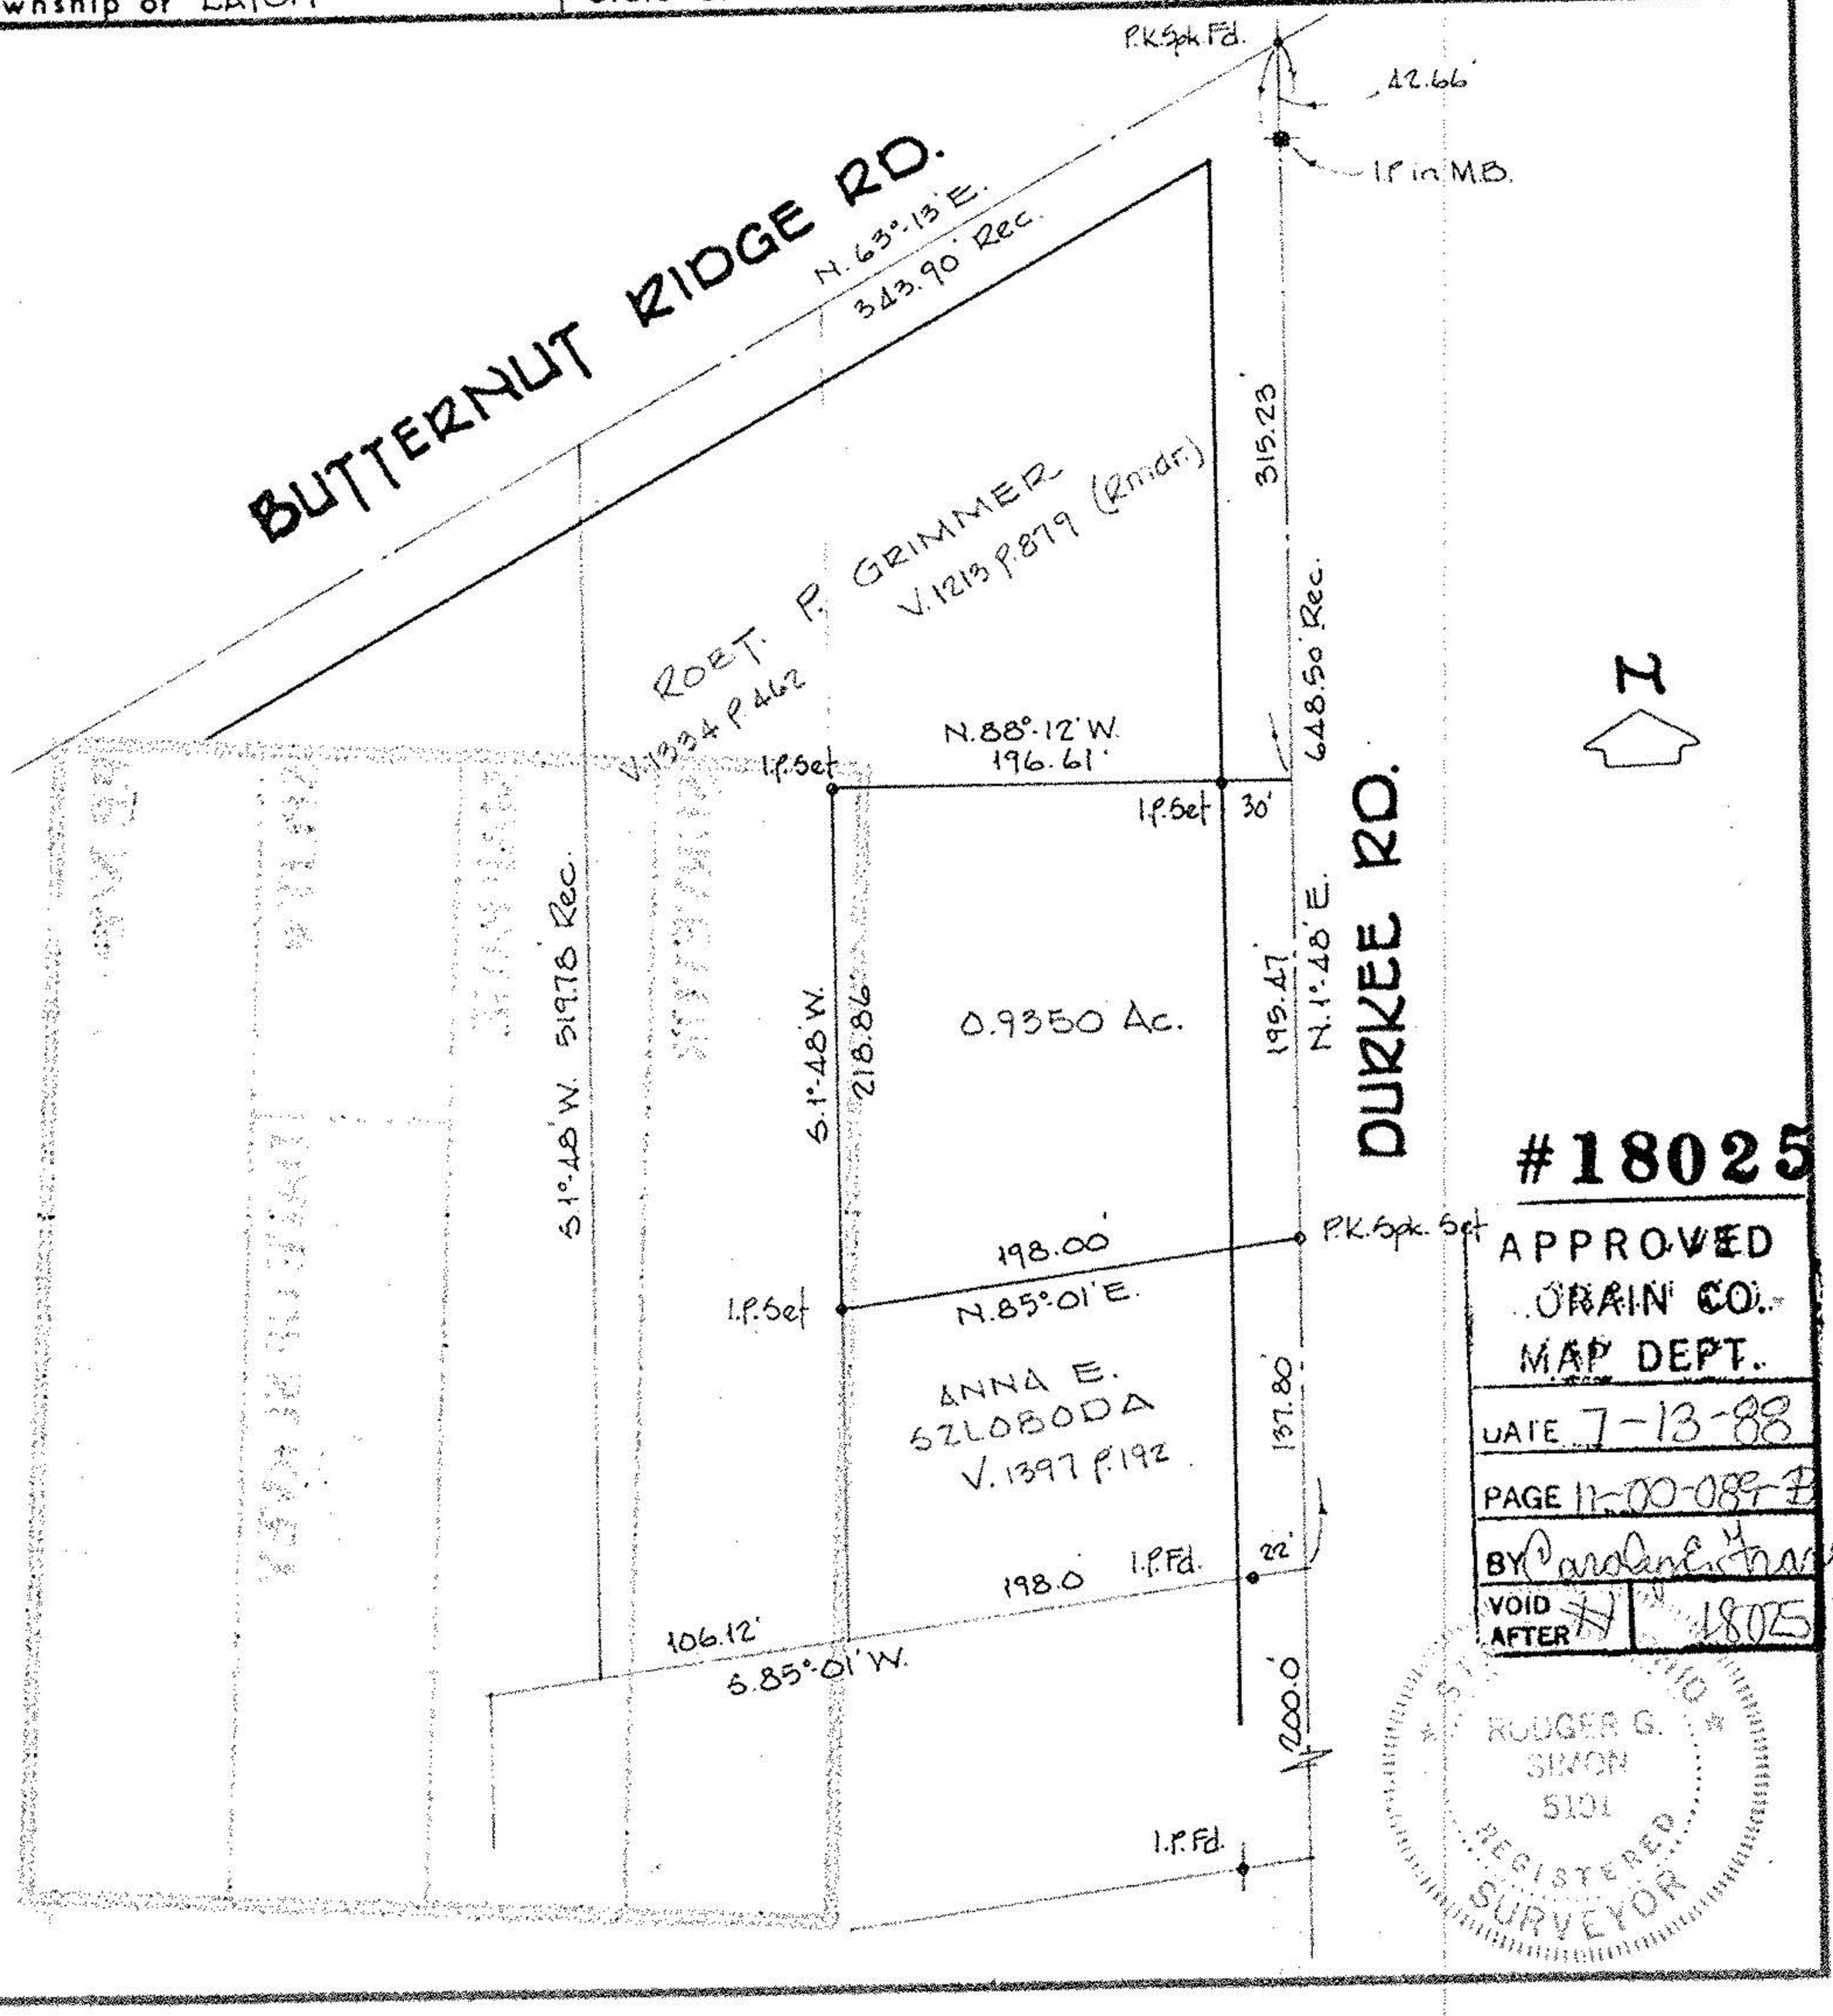

APPROVED
DRAIN CO.
MAP DEPT.
DATE 7-13-88
PAGE 11-00-089-B
BY Caroline Hanna
VOID AFTER ~~X~~ #18025

ROGER G. SIMON 5101 REGISTERED SURVEYOR STATE OF OHIO

#18025

11-00-089-B