11-00-074-A

#18493

11-00-074-000

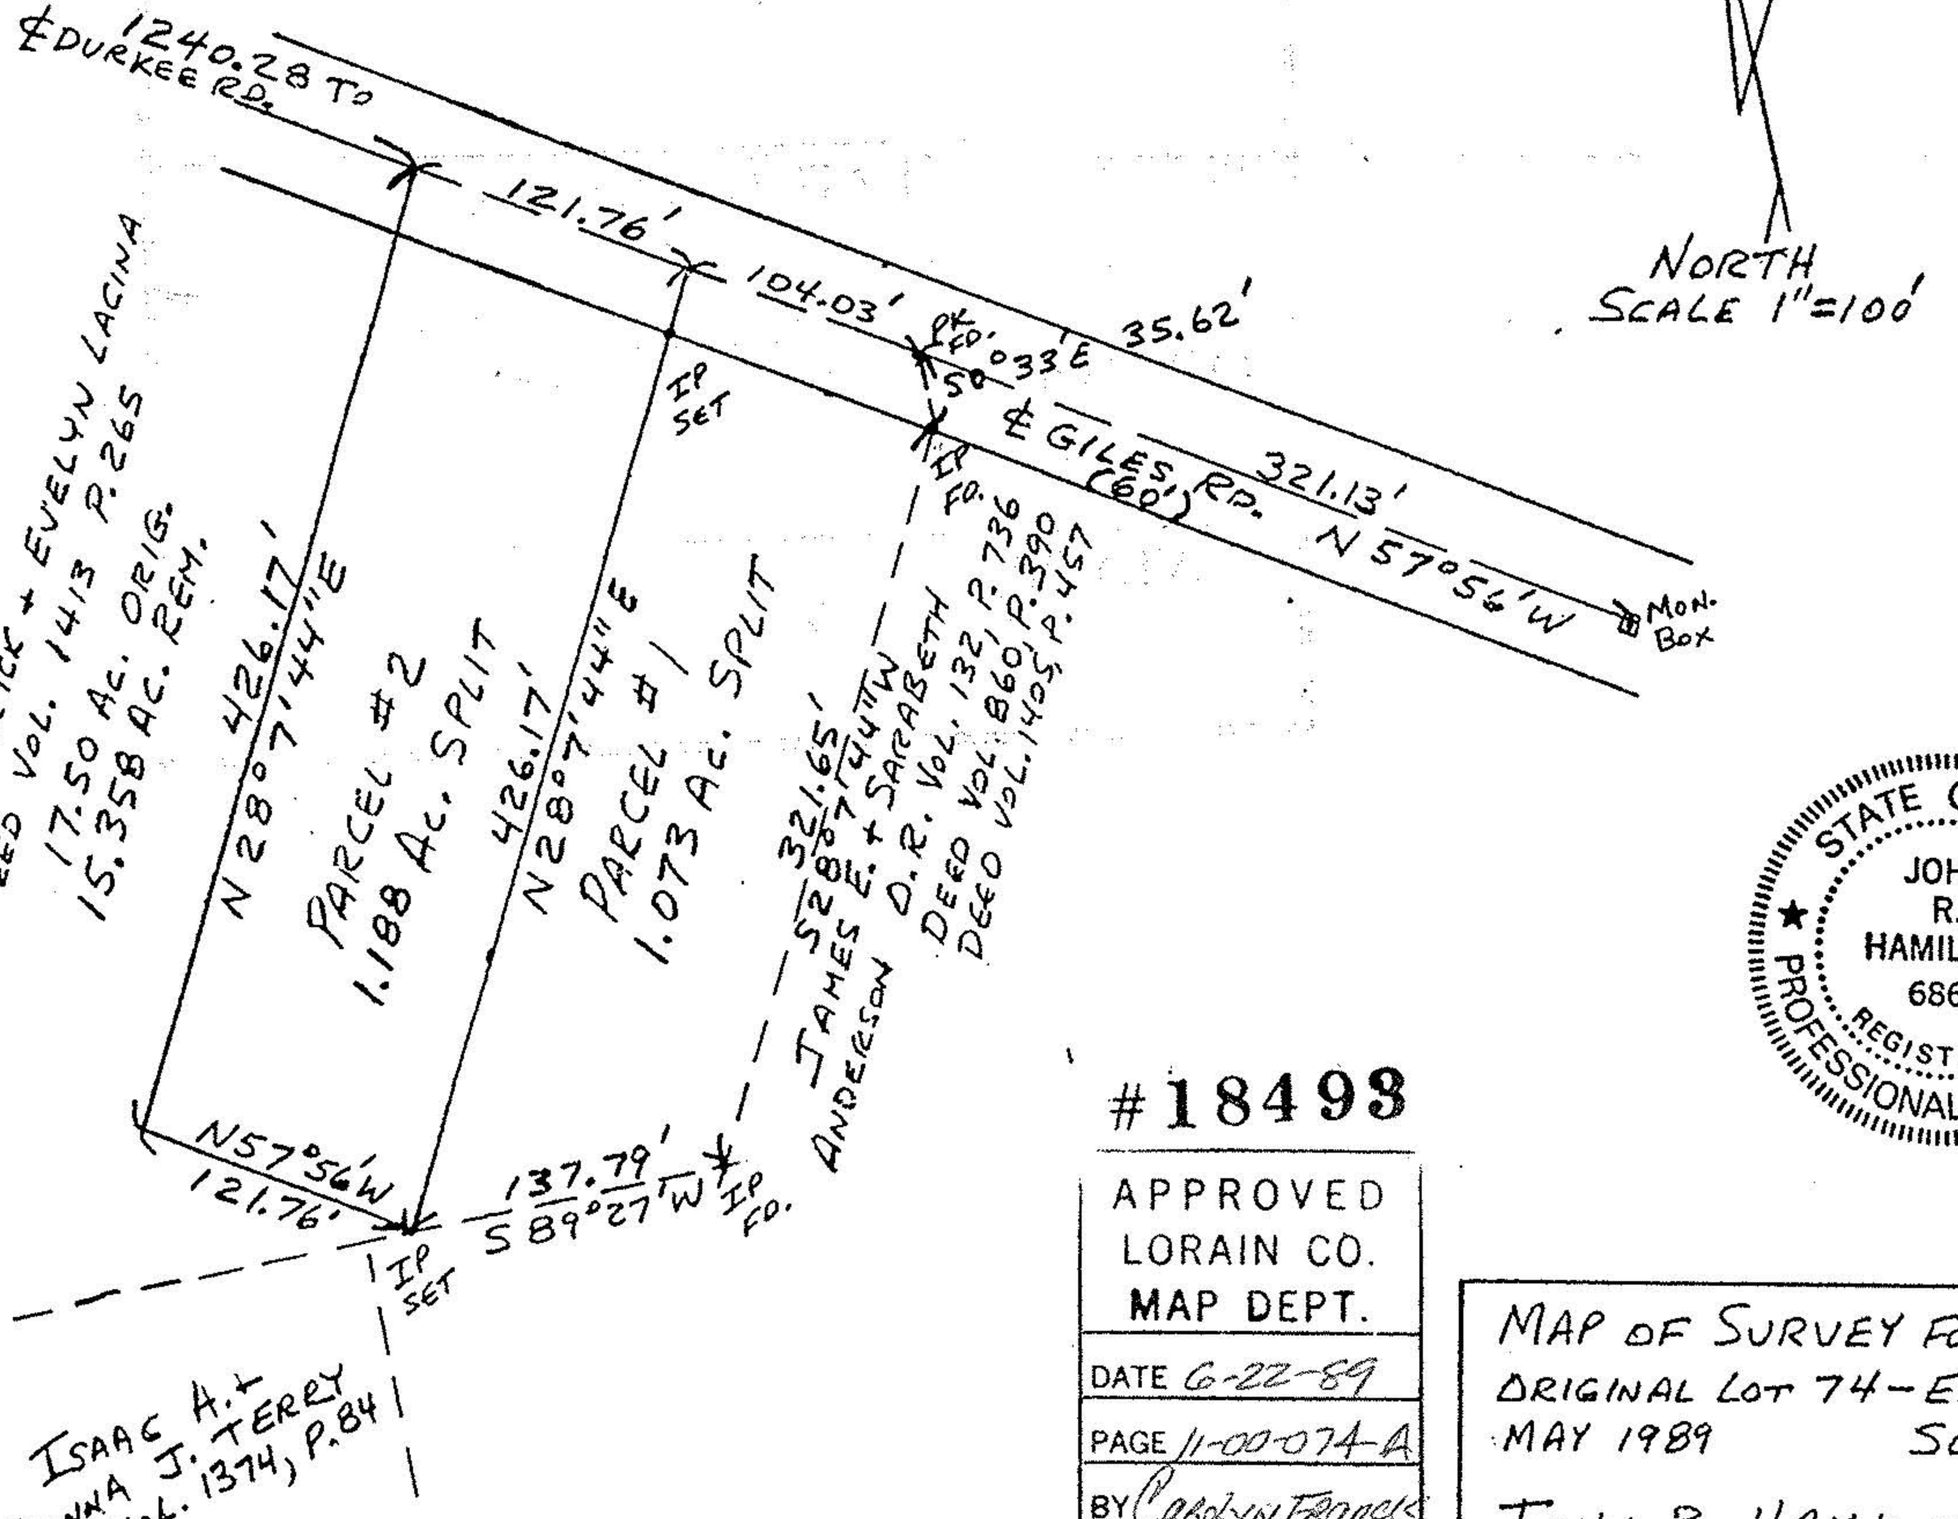

STATE OF OHIO
JOHN R. HAMILTON
6861
REGISTERED PROFESSIONAL SURVEYOR

#18493

APPROVED
LORAIN CO.
MAP DEPT.

DATE 6-22-89

PAGE 11-00-074-A

BY Carolyn Francis

VOID AFTER # 18493

MAP OF SURVEY FOR FRED LACINA
ORIGINAL LOT 74 - EATON TWP.
MAY 1989 SCALE 1"=100'

JOHN R. HAMILTON
REG. SURV. #6861

REV. 6/89 CHG. PAR. #2.