TOPOGRAPHIC SURVEY

OF

AKIN PROPERTY

ORIGINAL RIDGEVILLE LOT NO. 21

CITY OF NORTH RIDGEVILLE COUNTY OF LORAIN

STATE OF OHIO

PREPARED BY:
HAPONEK AND ASSOCIATES
SUREYORS AND ENGINEERS
NORTH RIDGEVILLE, OH

PREPARED FOR:
AKIN & AKIN & SON AUTO BODY
35205 CENTER RIDGE ROAD
NORTH RIDGEVILLE, OH

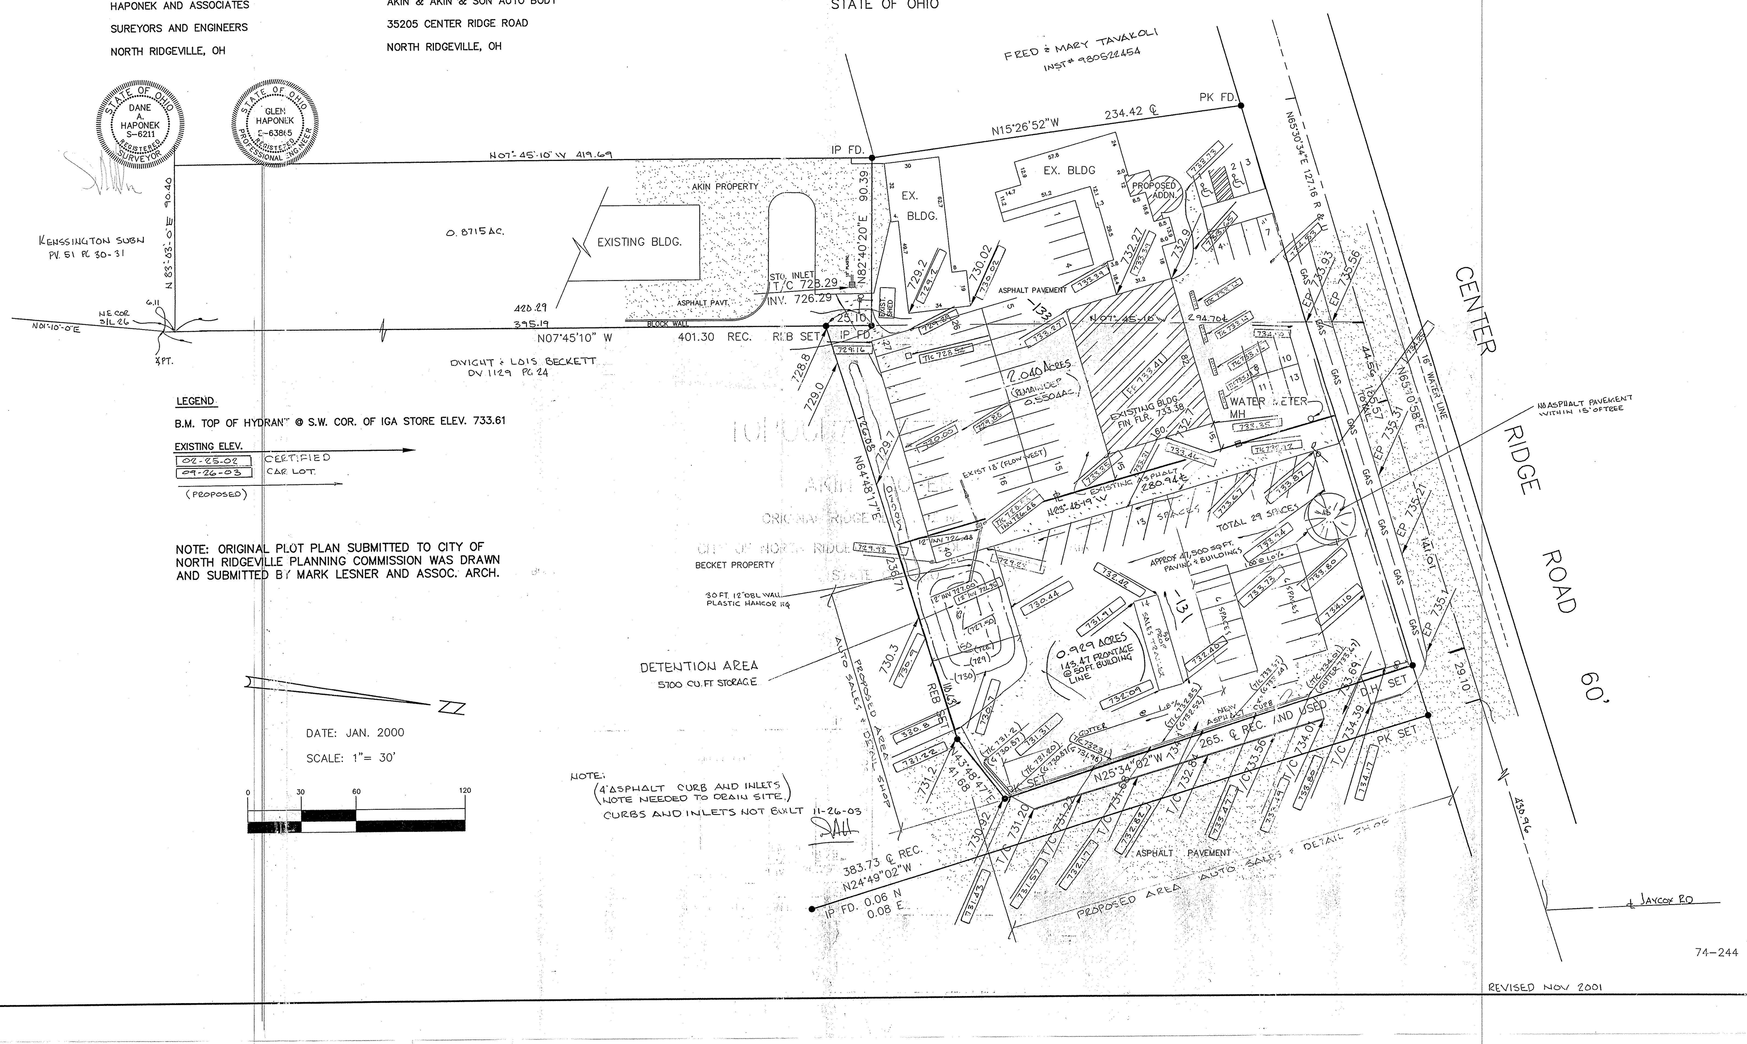

LEGEND

B.M. TOP OF HYDRANT @ S.W. COR. OF IGA STORE ELEV. 733.61

EXISTING ELEV.

02-25-02	CERTIFIED
09-26-03	CAR LOT.

(PROPOSED)

NOTE: ORIGINAL PLOT PLAN SUBMITTED TO CITY OF NORTH RIDGEVILLE PLANNING COMMISSION WAS DRAWN AND SUBMITTED BY MARK LESNER AND ASSOC. ARCH.

74-244

REVISED NOV 2001

SURVEY

OF PART OF

ORIGINAL RIDGEVILLE TWP. LOT 21

CITY OF N. RIDGEVILLE COUNTY OF LORAIN

STATE OF OHIO

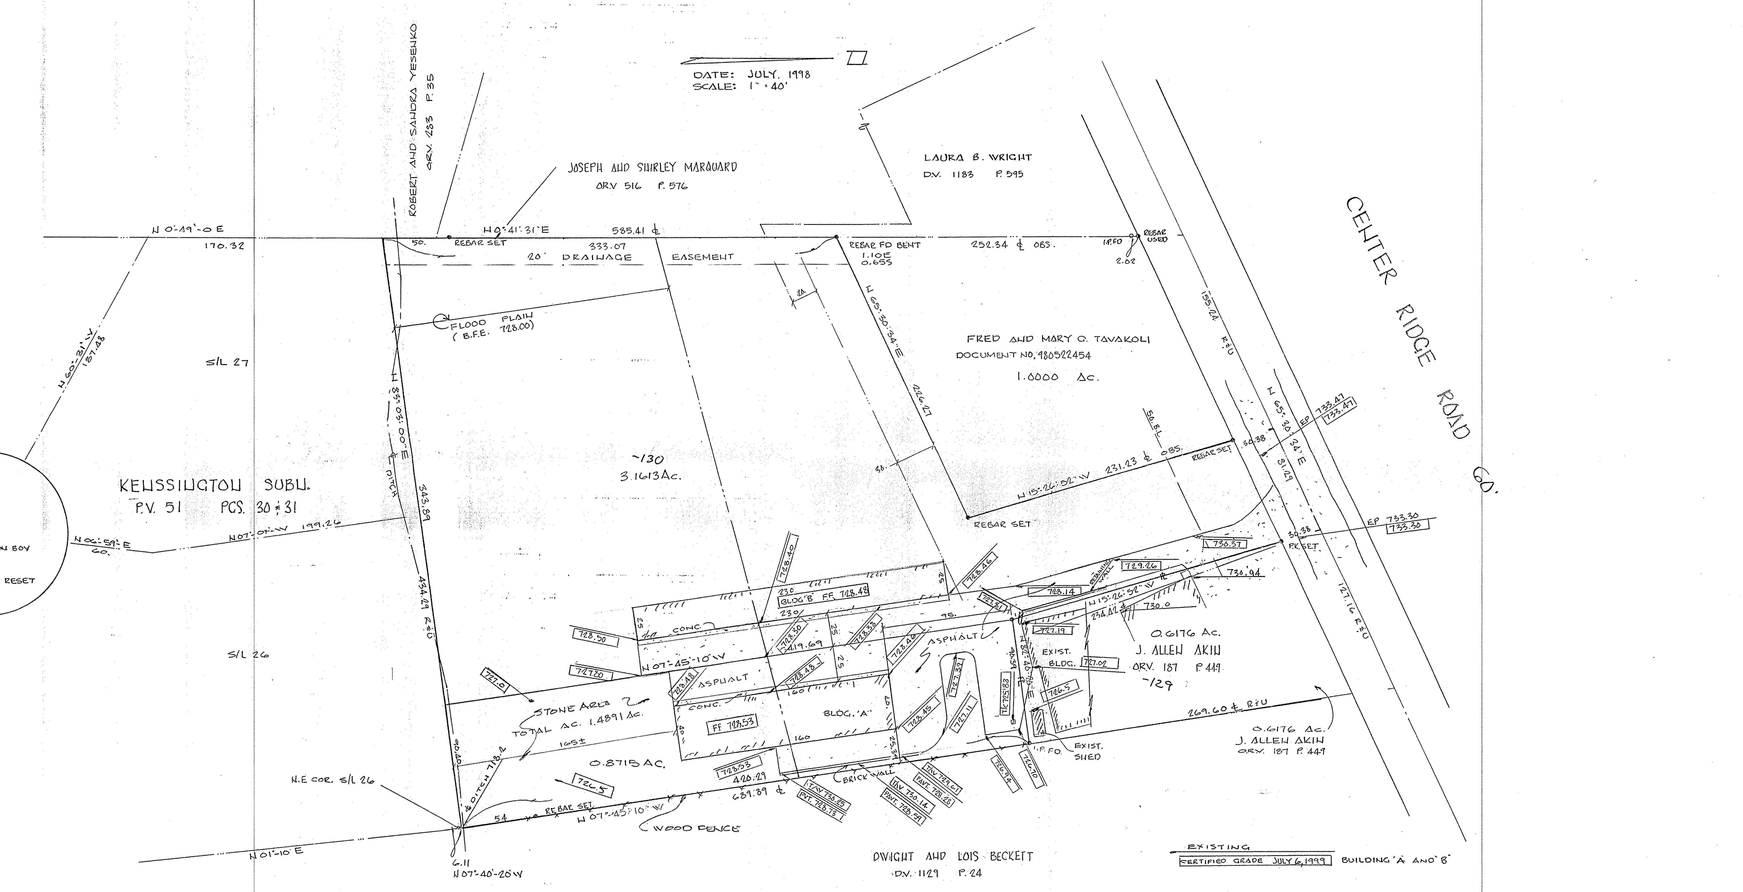

#01656

APPROVED
LORAIN CO.
MAP DEPT.
DATE 5-17-04
PARCEL 7-00-021 B D
BY R. HAINES
PARCEL NUMBER 04-016656

PREPARED FOR:
GEORGE KIMBLE & AKIN AUTO BODY
N. RIDGEVILLE, OH N. RIDGEVILLE, OH.

PREPARED BY:
HAPONEK AND ASSOC.
SURVEYORS
N. RIDGEVILLE, OH

STATE OF OHIO
DANE A. HAPONEK
S-6211
REGISTERED SURVEYOR

REVISED MARCH 2004
REVISED: BLDGS ADDED 4-14-98