PLAT OF SURVEYING FOR JUTTA TAKACS AND FOR ELIZABETH QUINTANA AND ELIZABETH M. GREEN

ORIGINAL LOT 85-PITTSFIELD TOWNSHIP-LORAIN COUNTY-OHIO

SCALE: 1"=100' - APRIL-MAY 1994 - Gary E. Penfound - Reg. Surveyor No. 4457

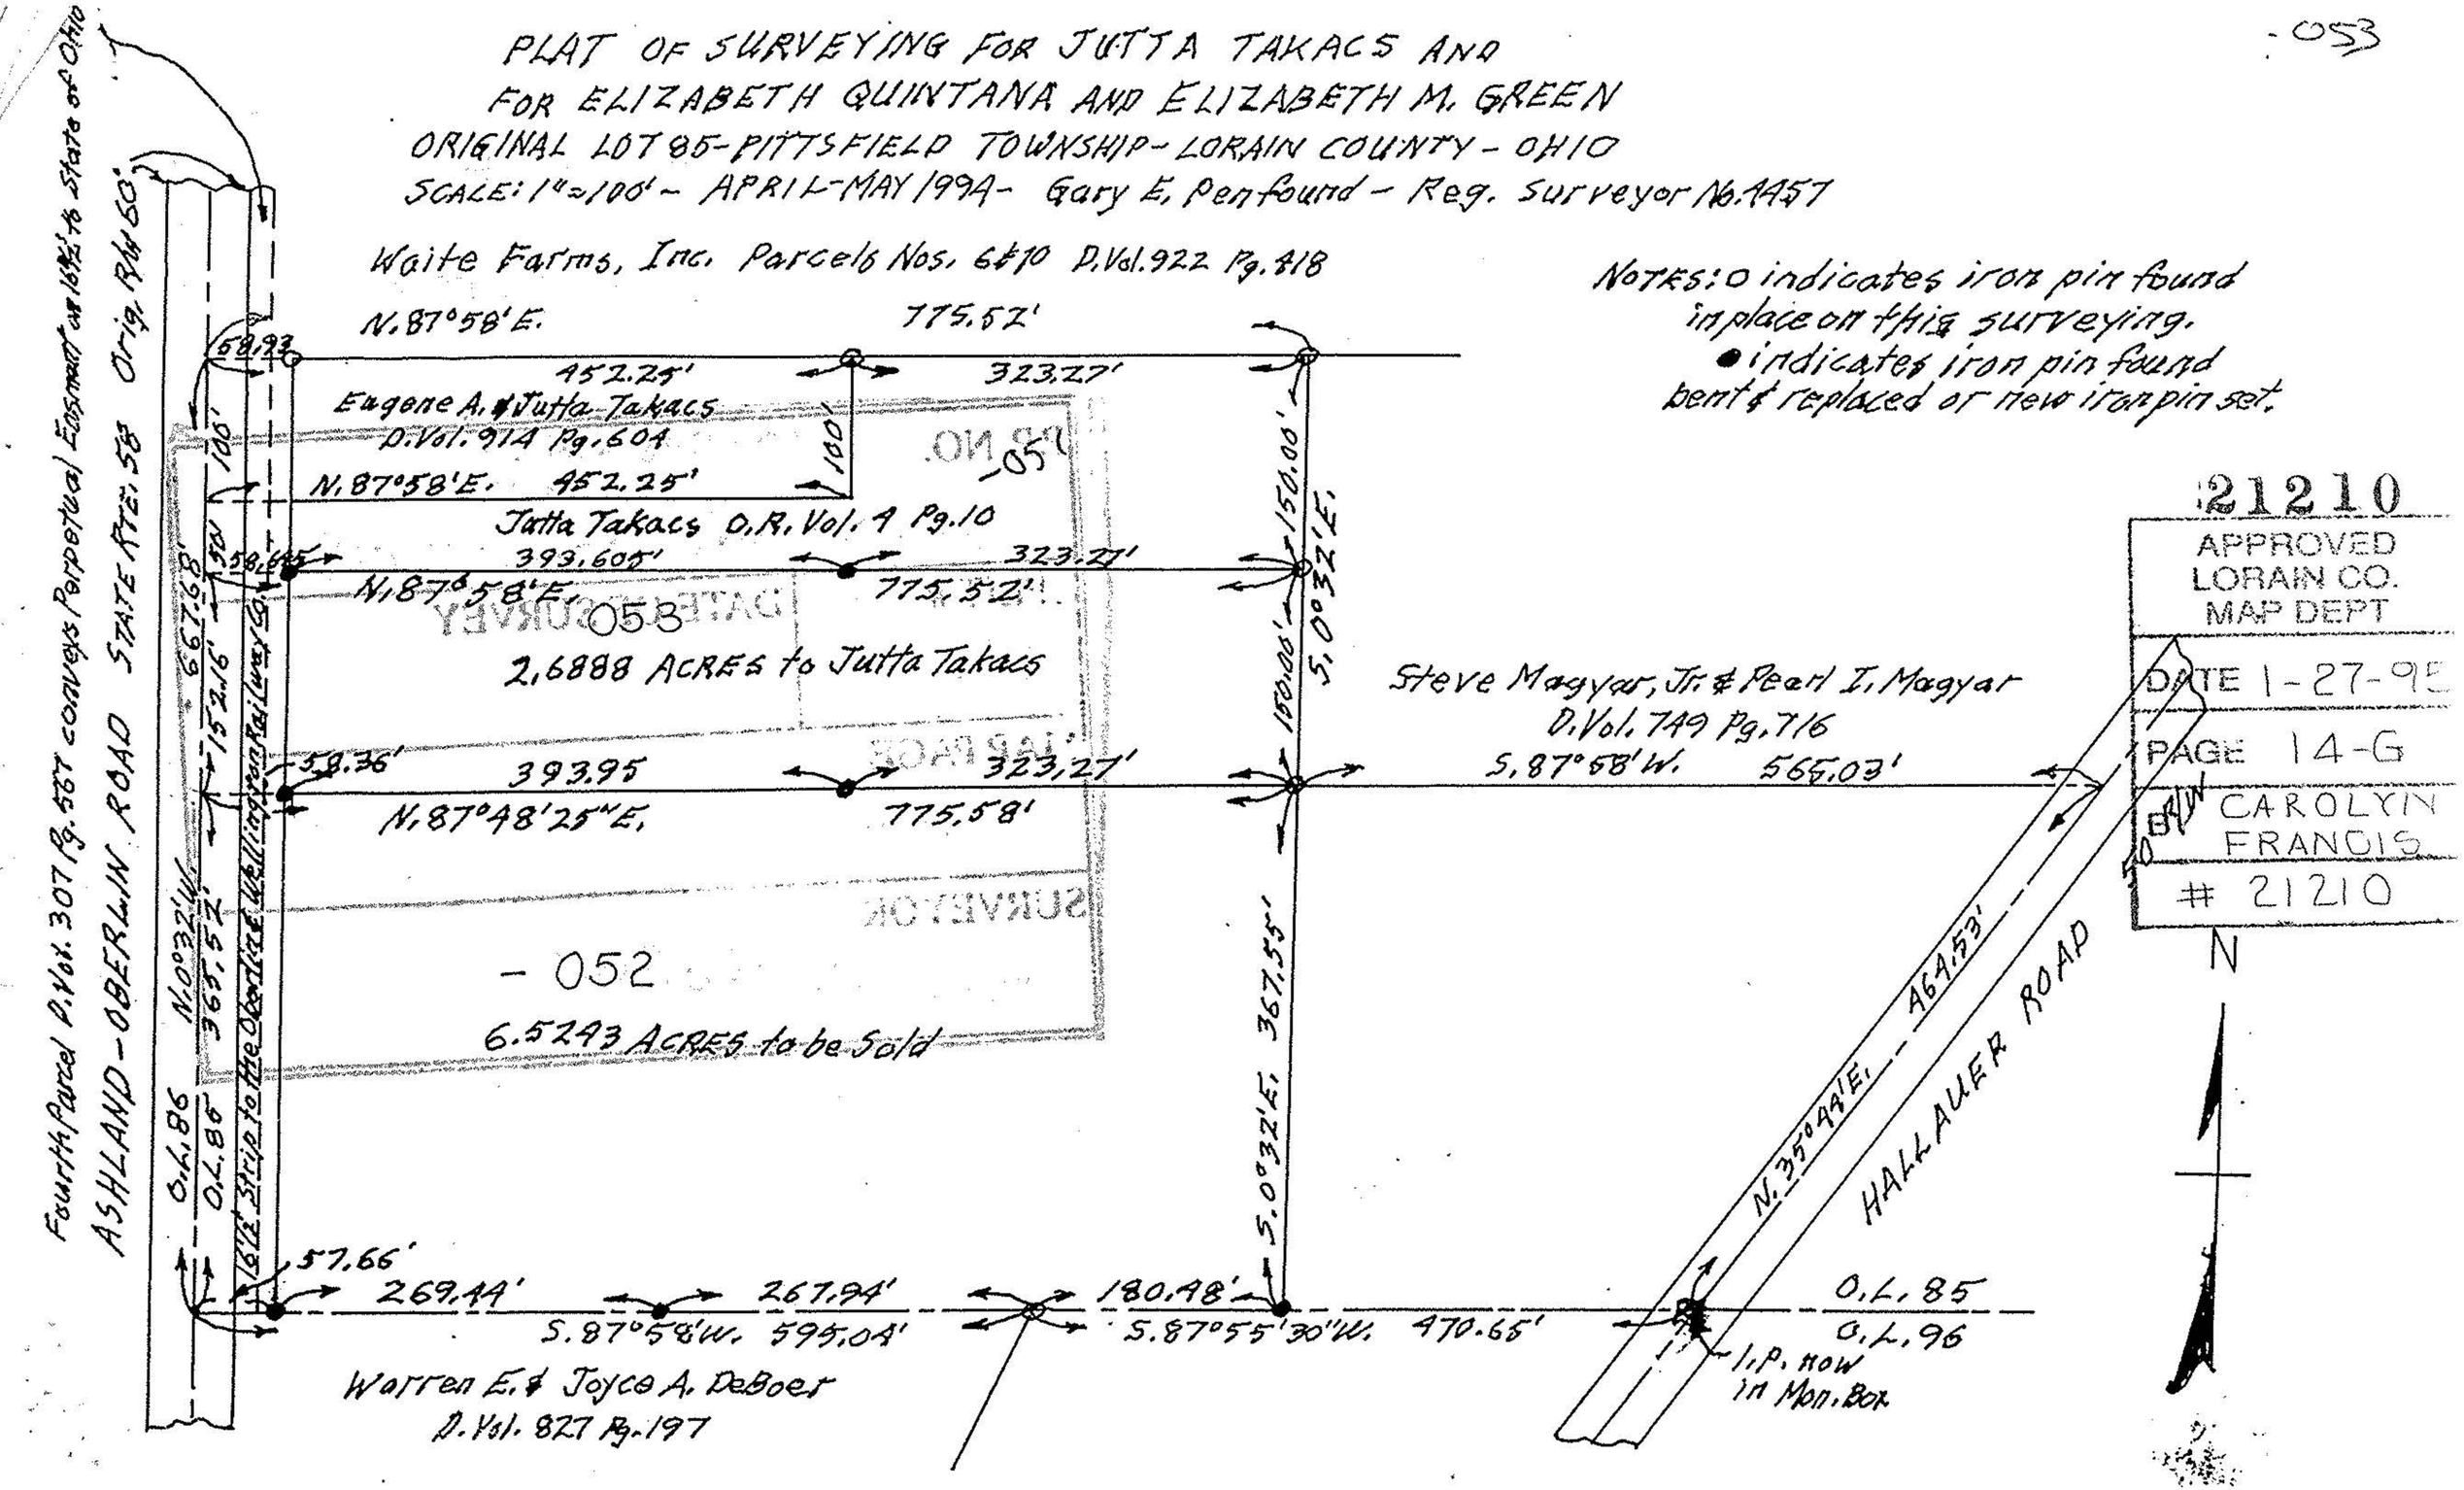

NOTES: ○ indicates iron pin found in place on this surveying.
● indicates iron pin found bent & replaced or new iron pin set.

21210
APPROVED
LORAIN CO.
MAP DEPT
DATE 1-27-95
PAGE 14-G
BY CAROLYN FRANCIS
21210