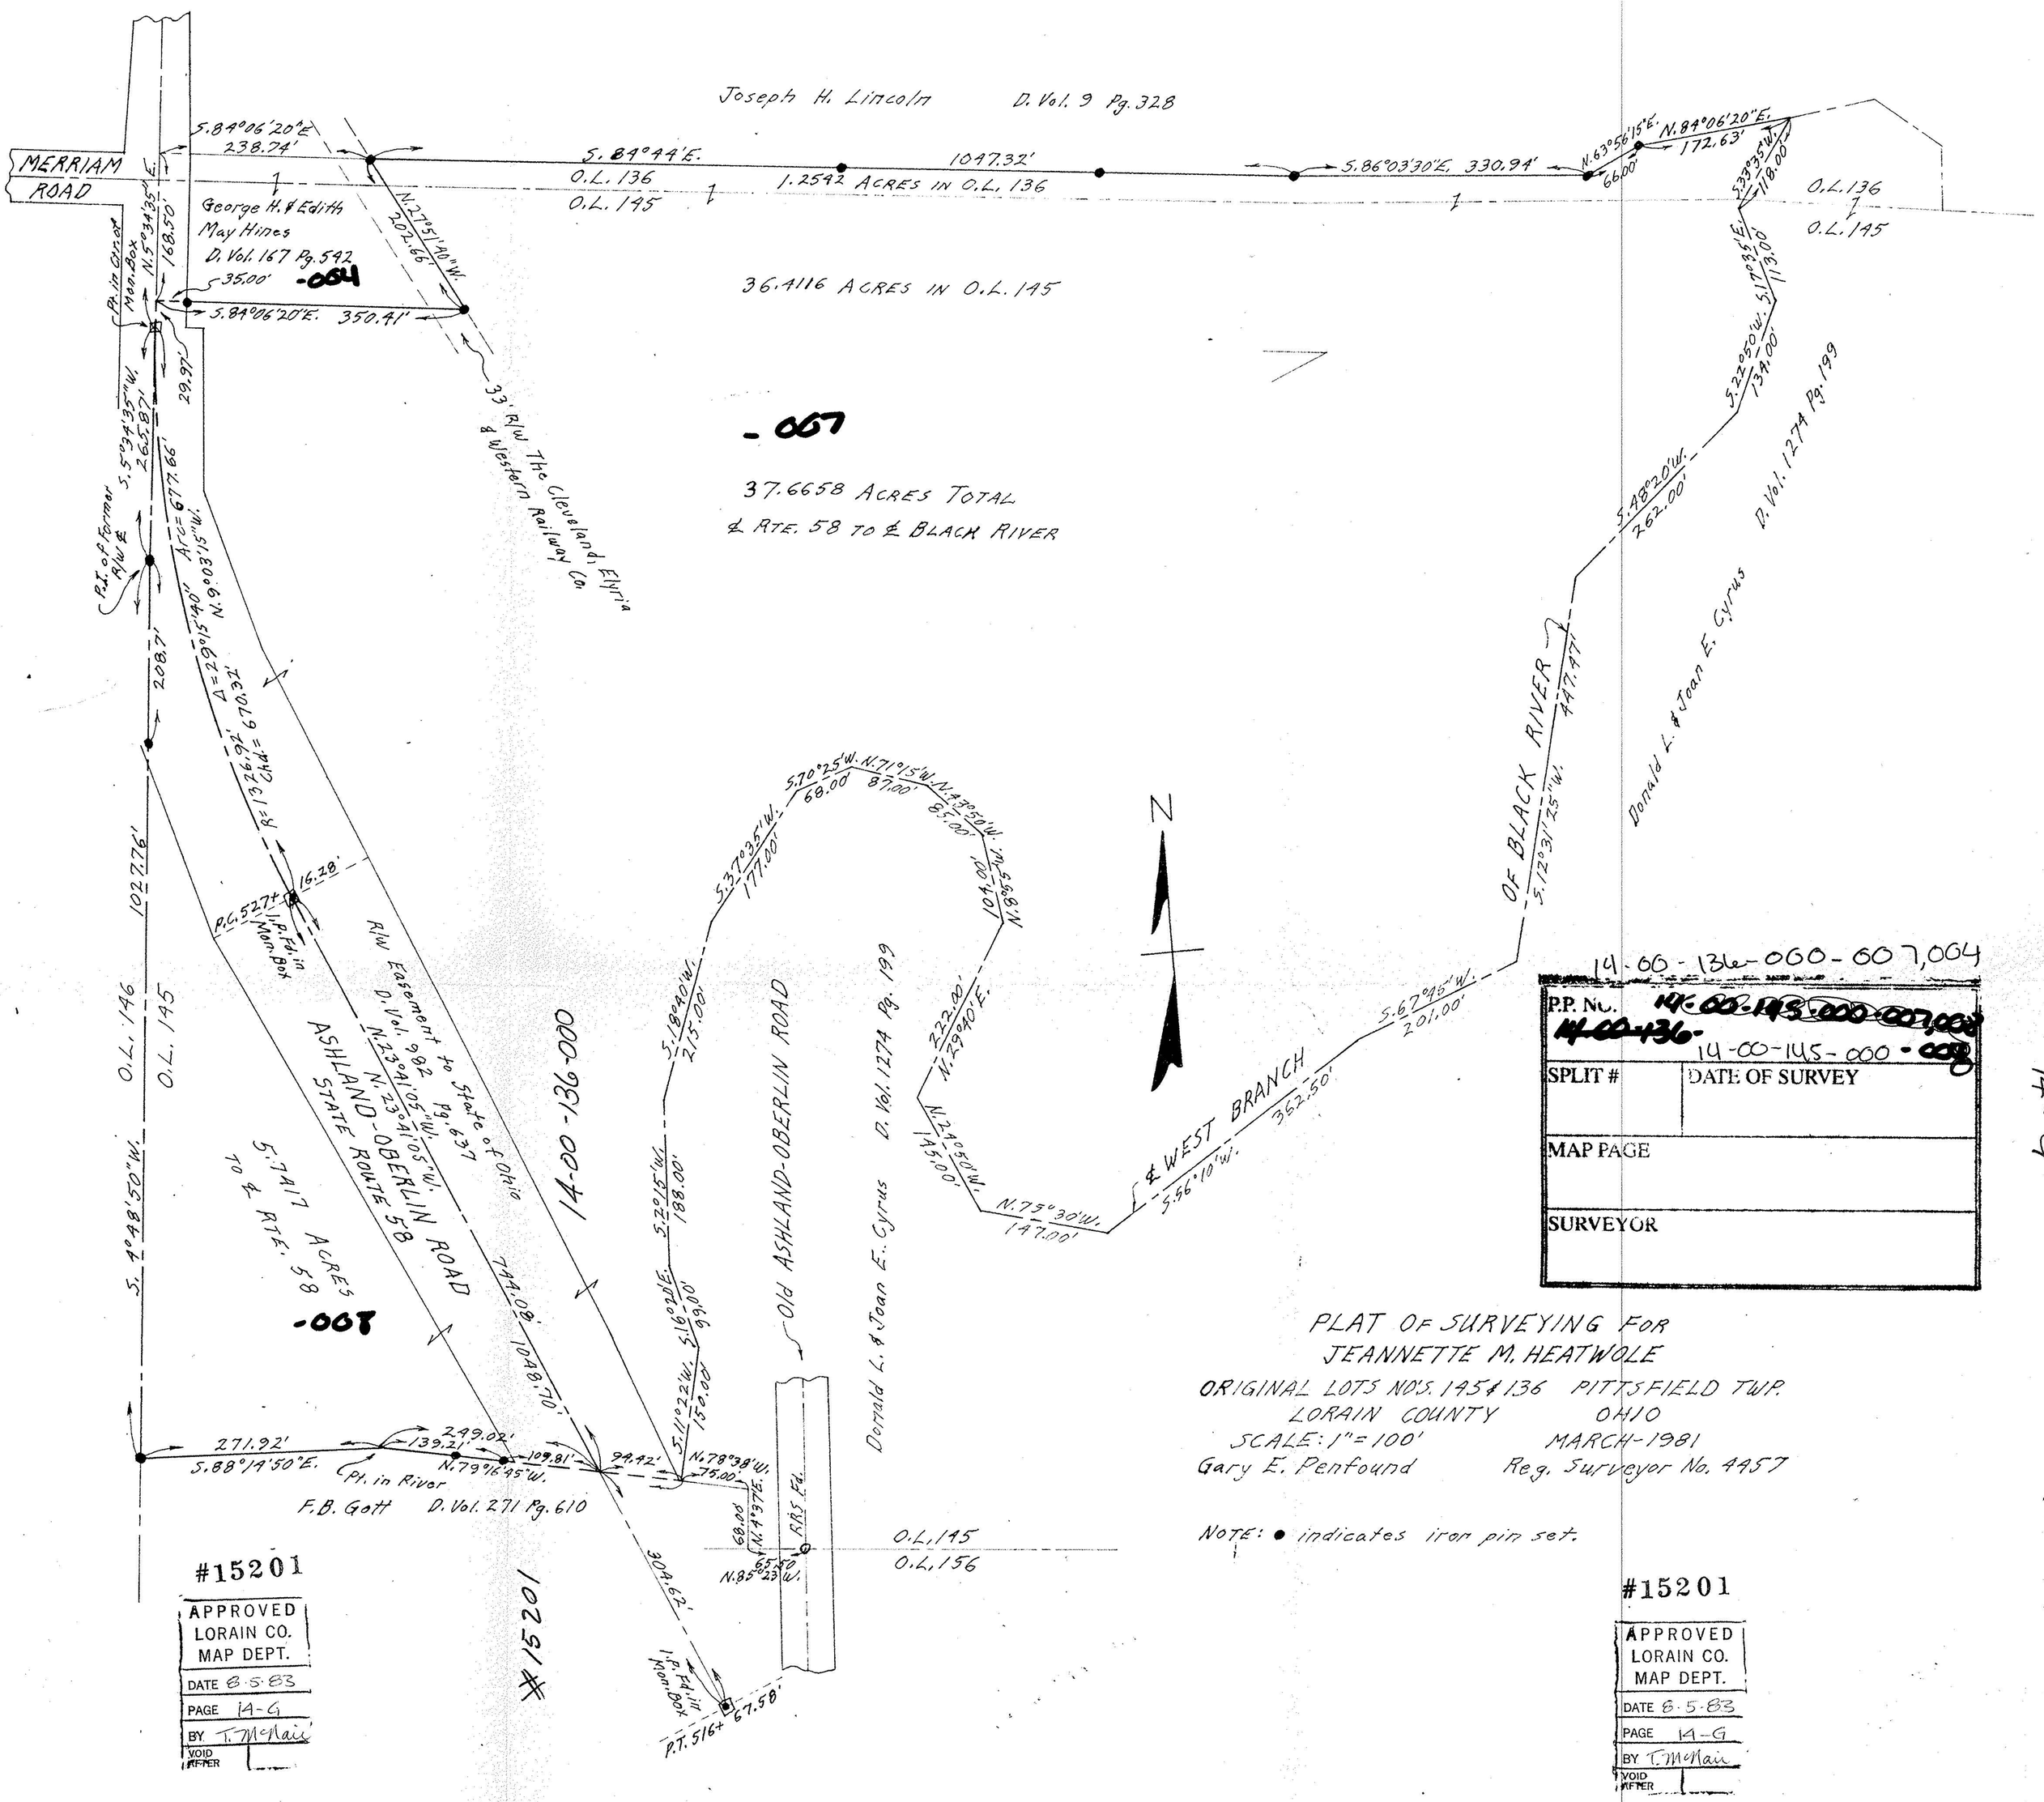


14-00-136-000-007,004

| P.P. No. | ~~14-00-145-000-007,008~~ ~~14-00-136-~~ 14-00-145-000-008 |
|---|---|
| SPLIT # | DATE OF SURVEY |
| MAP PAGE | |
| SURVEYOR | |

PLAT OF SURVEYING FOR
JEANNETTE M. HEATWOLE
ORIGINAL LOTS NO'S. 145 & 136 PITTSFIELD TWP.
LORAIN COUNTY OHIO
SCALE: 1" = 100' MARCH-1981
Gary E. Penfound Reg. Surveyor No. 4457

NOTE: ● indicates iron pin set.

#15201

APPROVED
LORAIN CO.
MAP DEPT.
DATE 8-5-83
PAGE 14-G
BY T. McNair
VOID AFTER

#15201

APPROVED
LORAIN CO.
MAP DEPT.
DATE 8-5-83
PAGE 14-G
BY T. McNair
VOID AFTER

14-G

#15201

14-00-136-000