


019
19-04-035-000
19-05-037-000

DENNIS W. STRAUB
D-VOL. 1012 PG. 811

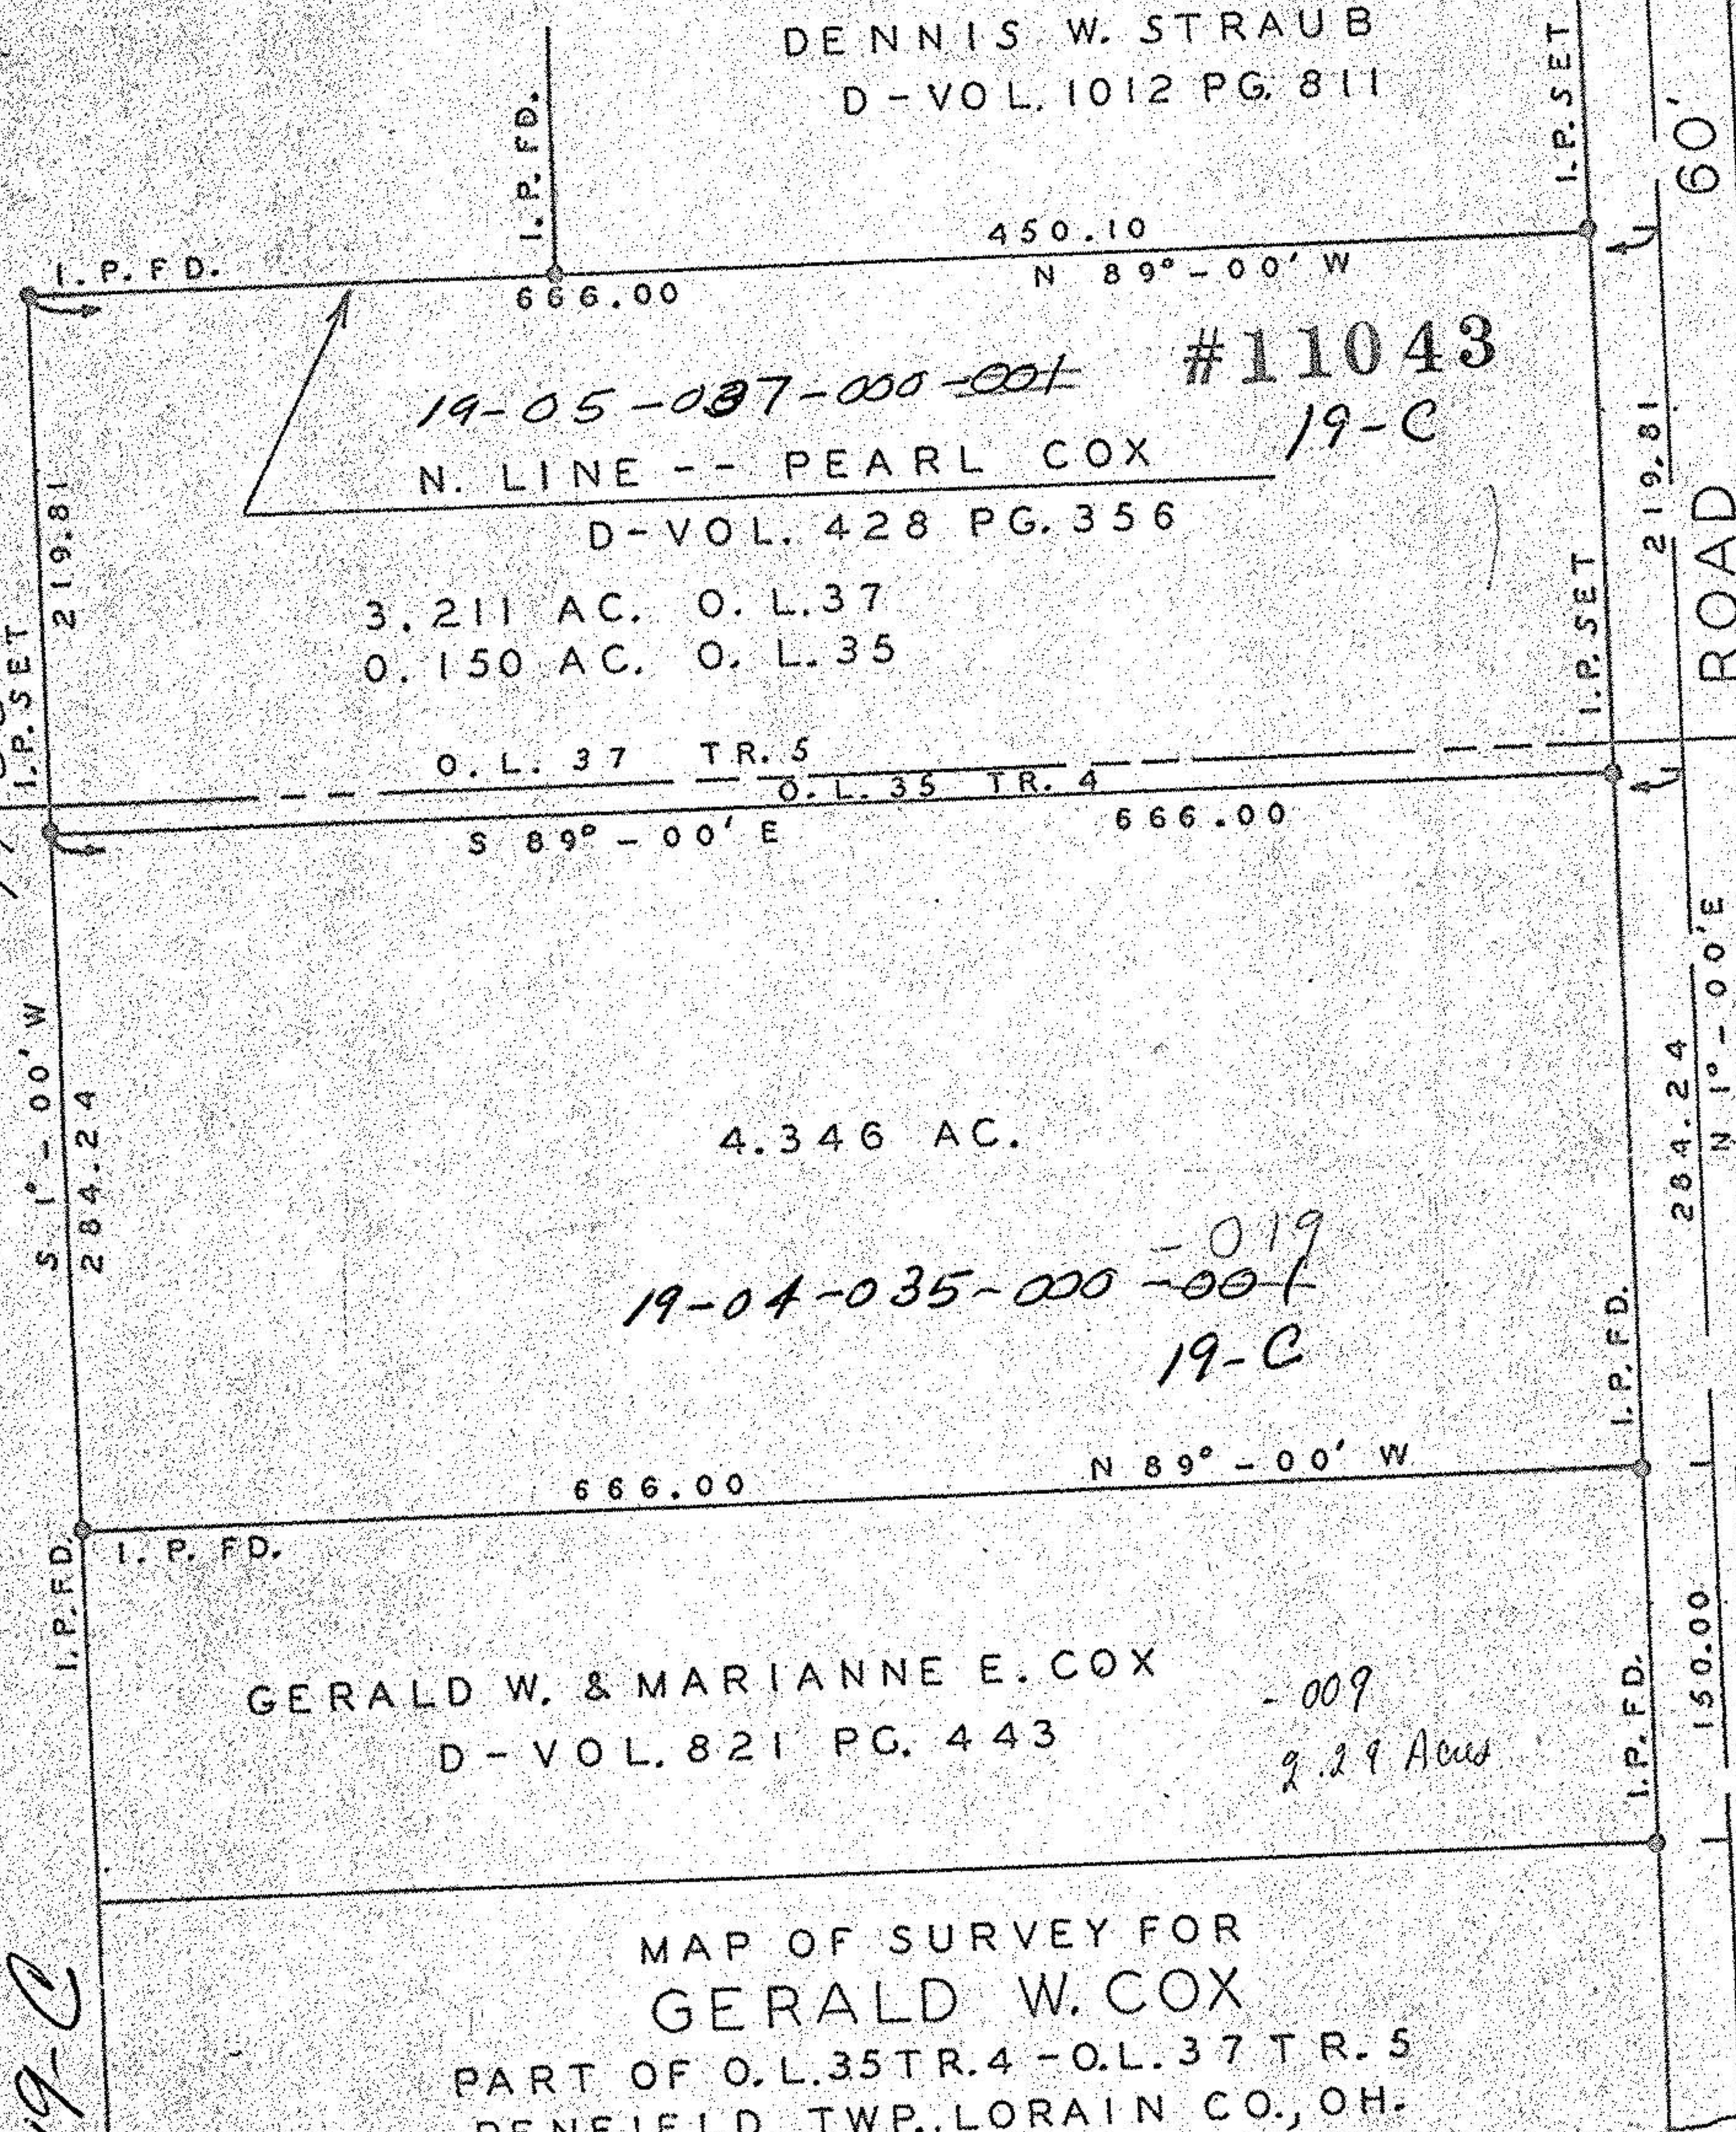

~~19-05-037-000-001~~ #11043
N. LINE -- PEARL COX 19-C
D-VOL. 428 PG. 356

3.211 AC. O. L. 37
0.150 AC. O. L. 35

O. L. 37 TR. 5
O. L. 35 TR. 4
S 89° - 00' E 666.00

4.346 AC.

~~19-04-035-000-001~~ -019
19-C

GERALD W. & MARIANNE E. COX
D-VOL. 821 PG. 443

-009
2.29 Acres

MAP OF SURVEY FOR
GERALD W. COX
PART OF O. L. 35 TR. 4 - O. L. 37 TR. 5
PENFIELD TWP., LORAIN CO., OH.
SCALE 1" = 100' JUNE, 1977
NEFF AND ASSOCIATES, INC.
REGISTERED SURVEYORS

ROAD 60'

ROAD 264.24 N 1° - 00' E

ROAD 150.00

FOSTER

19-04-037
19-04-037

JM-19-C
Neff & Associates, Inc.