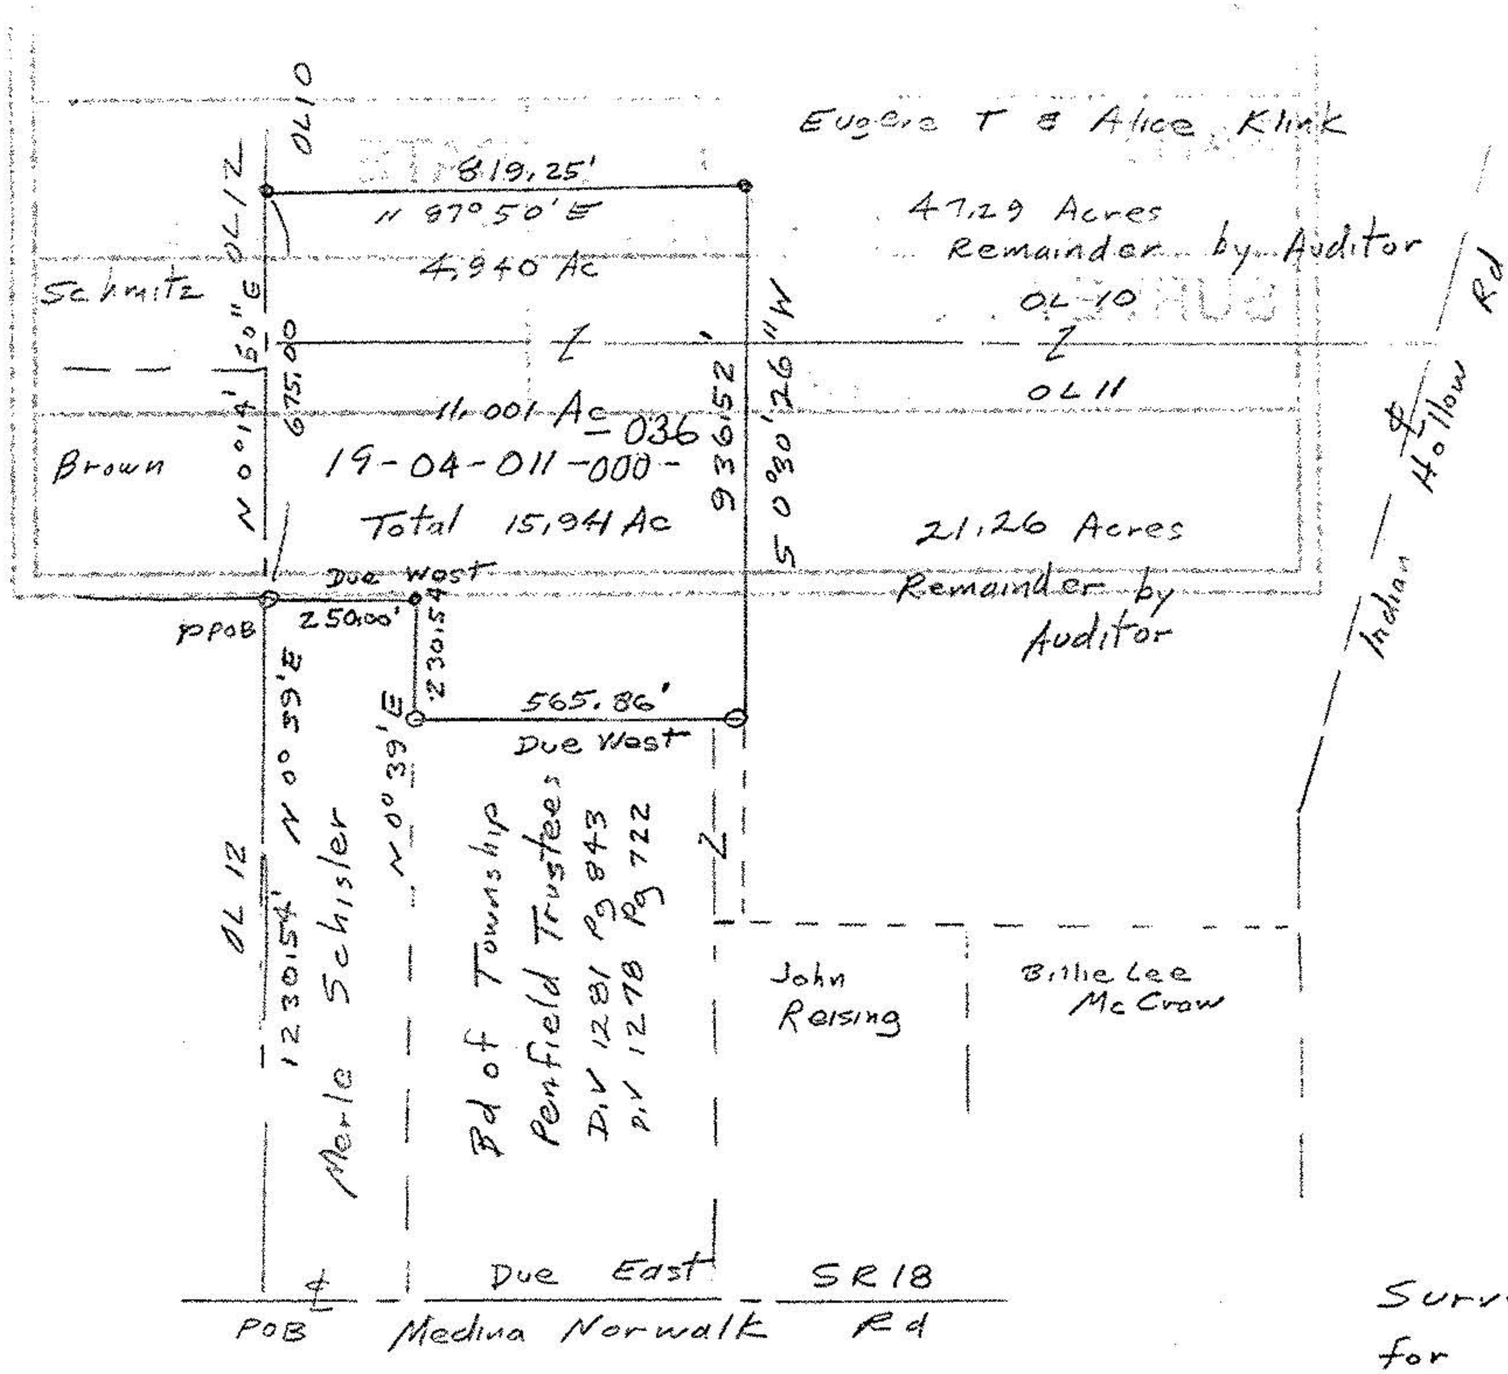

21668

APPROVED
LORAIN CO.
MAP DEPT

DATE 2-13-96

PAGE 19-C

BY CAROLYN FRANCIS

#21668

o iron pipes fd
iron pipes set

STATE OF OHIO
JOHN
POZYWAK
5292
REGISTERED
SURVEYOR

Survey for a Parcel Split
for Board of Penfield Trustees
Original Lots 10 & 11 Tract 4
Penfield Township
Lorain County Ohio
Scale 1" = 400' Dec 1, 1994
John Pozywak Reg Surveyor 5292