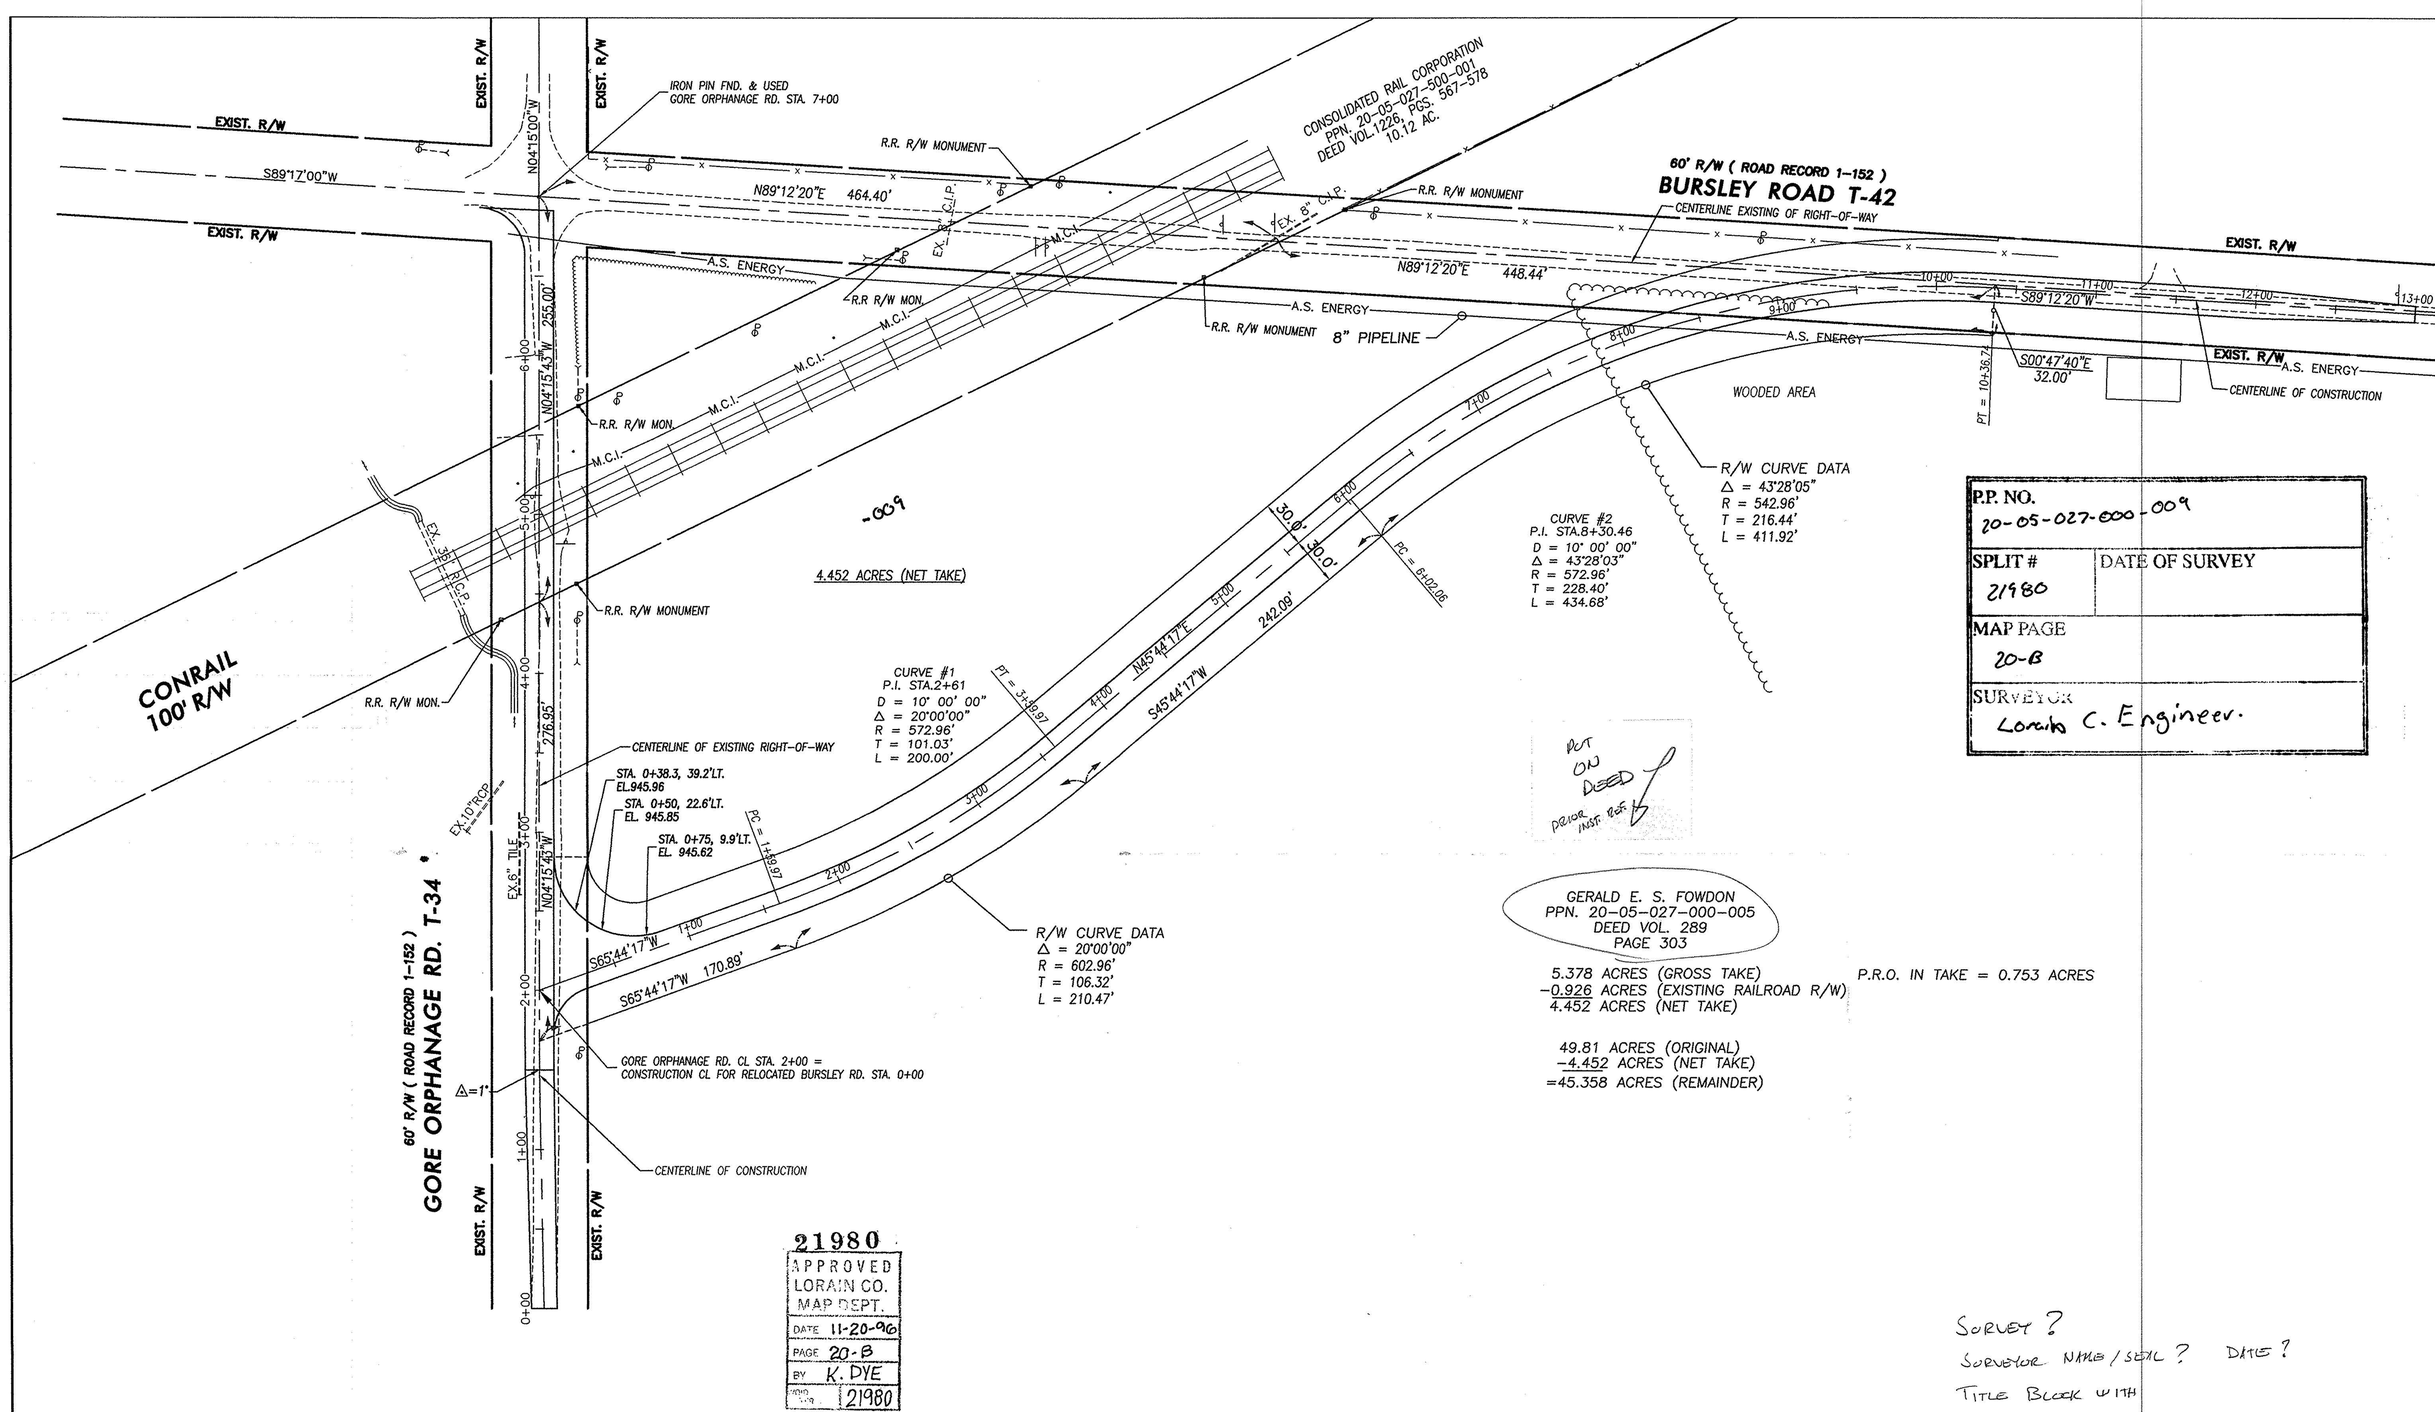

P.P. NO.	
20-05-027-000-009	
SPLIT # 21980	DATE OF SURVEY
MAP PAGE 20-B	
SURVEYOR Lorain C. Engineer.	

PRIOR INST. REF.

GERALD E. S. FOWDON
PPN. 20-05-027-000-005
DEED VOL. 289
PAGE 303

5.378 ACRES (GROSS TAKE)
−0.926 ACRES (EXISTING RAILROAD R/W)
4.452 ACRES (NET TAKE)

P.R.O. IN TAKE = 0.753 ACRES

49.81 ACRES (ORIGINAL)
−4.452 ACRES (NET TAKE)
=45.358 ACRES (REMAINDER)

21980
APPROVED
LORAIN CO.
MAP DEPT.
DATE 11-20-96
PAGE 20-B
BY K. DYE
MAP NO. 21980

SURVEY ?
SURVEYOR NAME / SEAL ? DATE ?
TITLE BLOCK WITH
PART OF ORIGINAL ROCHESTER TWP. LOT 27, TRACT 5

REVISED 5-20-96
RIGHT-OF-WAY

HORIZONTAL SCALE IN FEET
0 25 50 100

CALC. DATE
CHECK DATE
R.J.M. 08/95
XXX XX/XX

PLAN – T.R. 42 AND T.R. 34

BURSLEY ROAD AT GRADE ELIMINATION
CONRAIL R.R. @ GORE ORPHANAGE RD.

1
9

CAD FILE: \T42T34\T42T34PL.DWG