#18311 15-00-1-063-000-1

LAUNDON · SIMON · CAHL & ASSOC. INC.
CONSULTING ENGINEERS & SURVEYORS
219 COURT ST. ELYRIA, OHIO 44035

SURVEY FOR

DAVID & JUDITH LONG

Orig. Lot 63	City of	Date NOV. '88 Scale 1"=200'
Orig. Sec	Village of	Dwn. by R.G.S. Chkd. by C.J.
Tract	County of LORAIN	Job No. 88-1771 F.B.
Township of LAGRANGE	State of OHIO	Printed DEC 27 1988

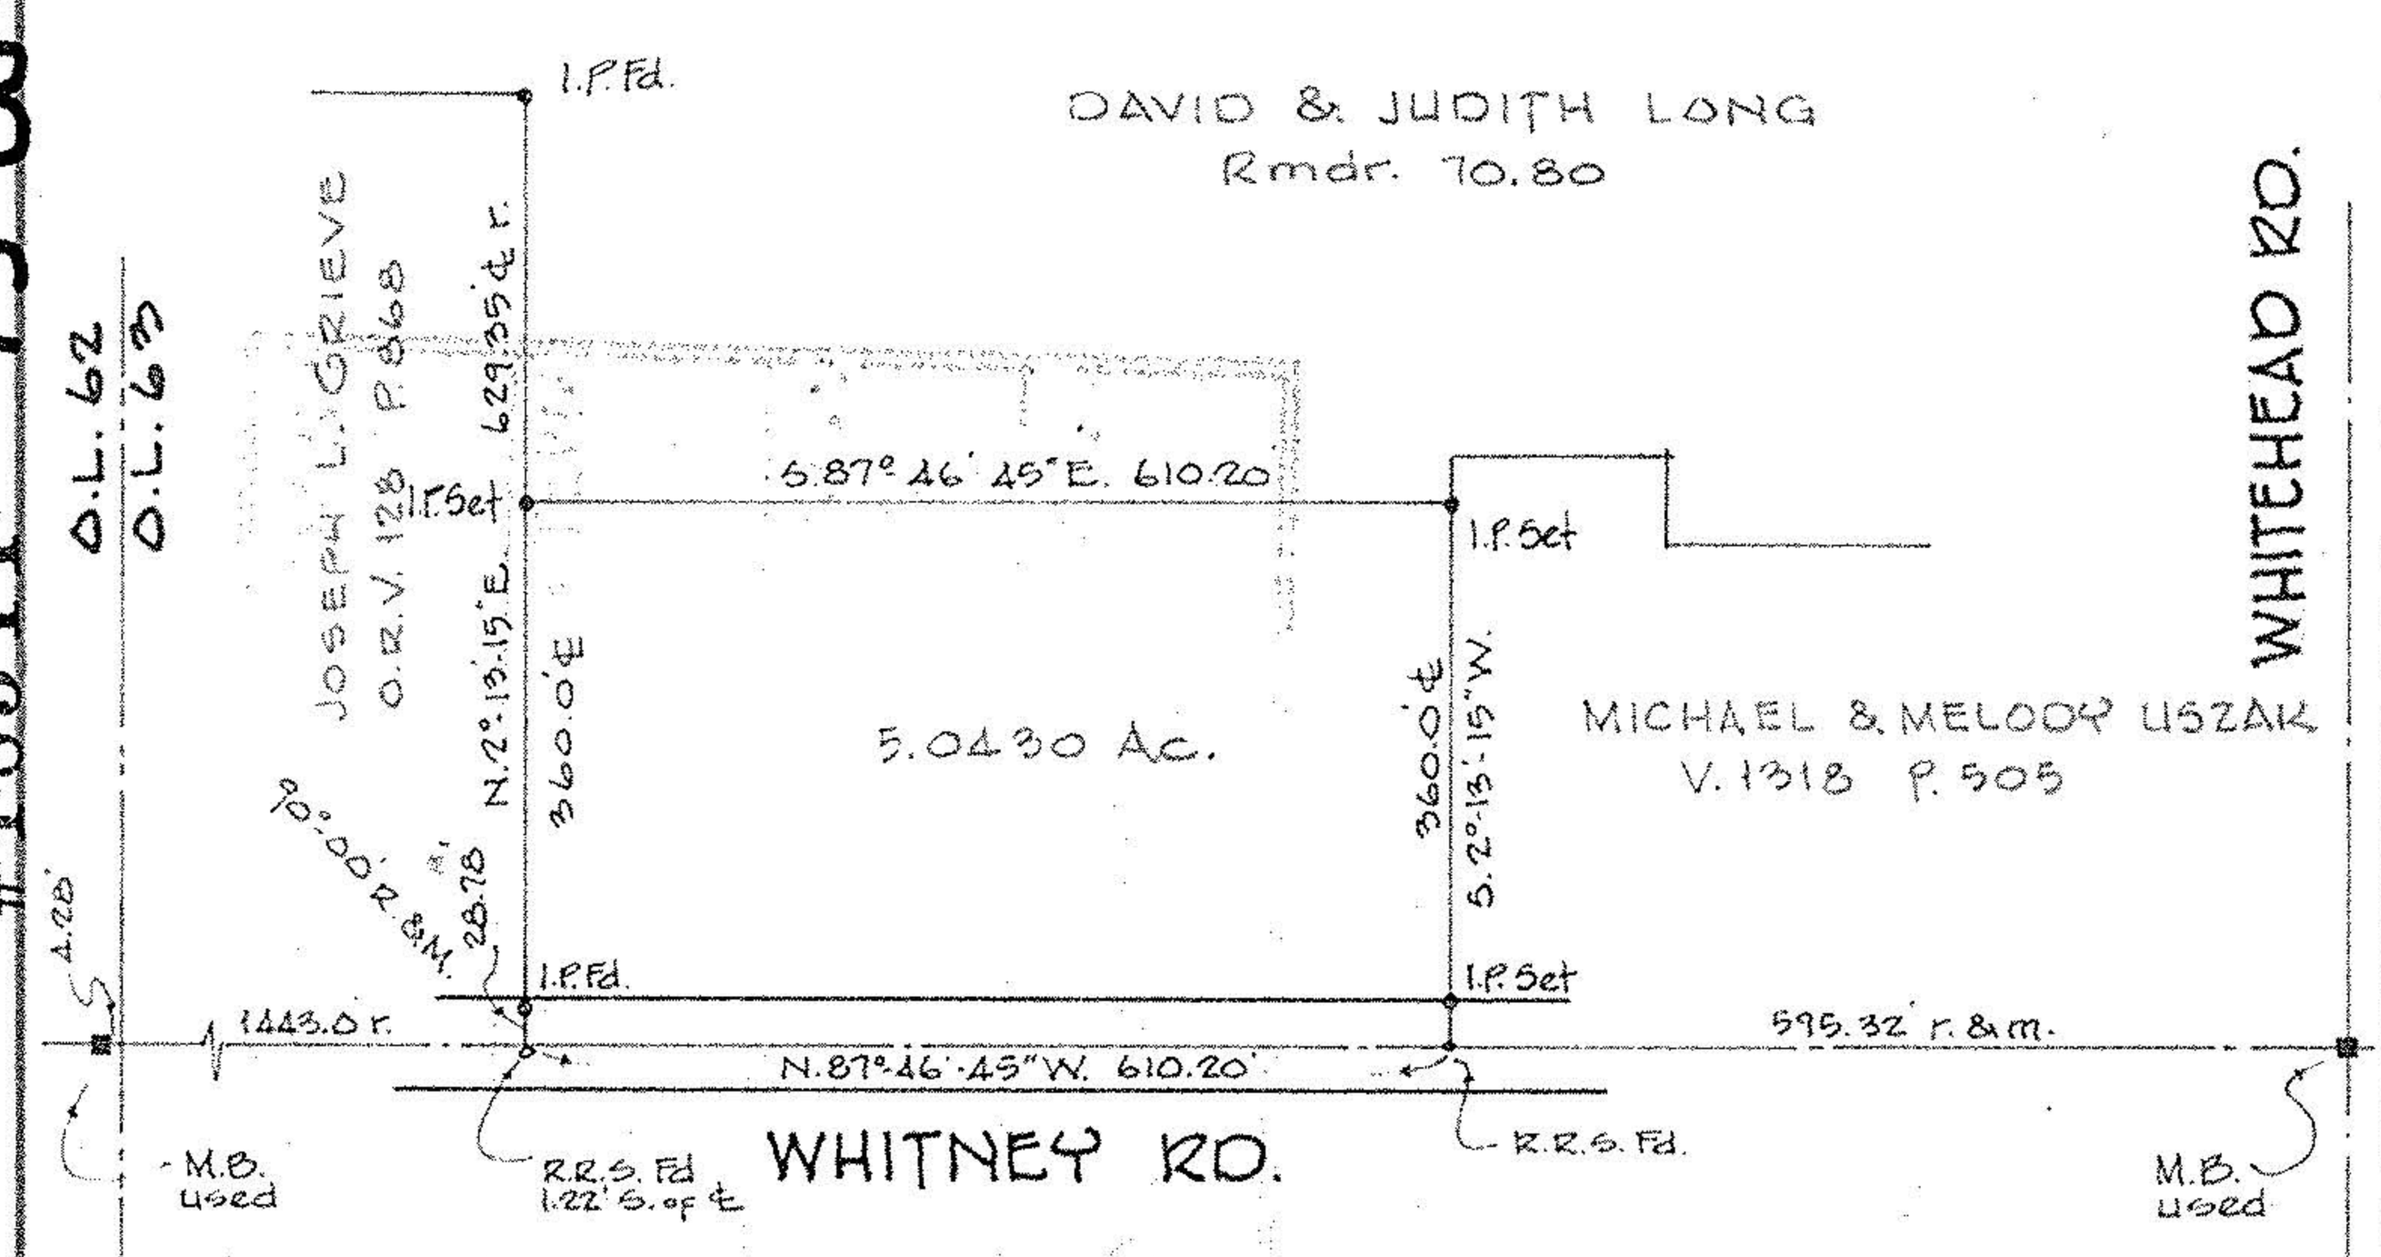

N

1 DAS
2. GaL
3. DeK-L
4. K.L.

#18311
APPROVED
GRAIN CO.
MAP DEPT.
DATE 2-3-89
PAGE 15-E
BY Carolyn Frances
VOID AFTER # 18311

Exhibit A

STATE OF OHIO
RODGER G. SIMON
5101
REGISTERED SURVEYOR

15-E