P.P. NO. 15-00-012-000-016	
SPLIT # 18747	DATE OF SURVEY Jan '88
MAP PAGE 15-0	
SURVEYOR Gary E, PENFOUND	

PLAT OF SURVEYING FOR EUGENE & BONNIE FACEMIRE

ORIGINAL LOTS 11 & 12 – LAGRANGE TWP.
LORAIN COUNTY – OHIO
SCALE: 1" = 100' JANUARY-1988 & NOVEMBER-1989
Gary E. Penfound – Reg. Surveyor No. 4457
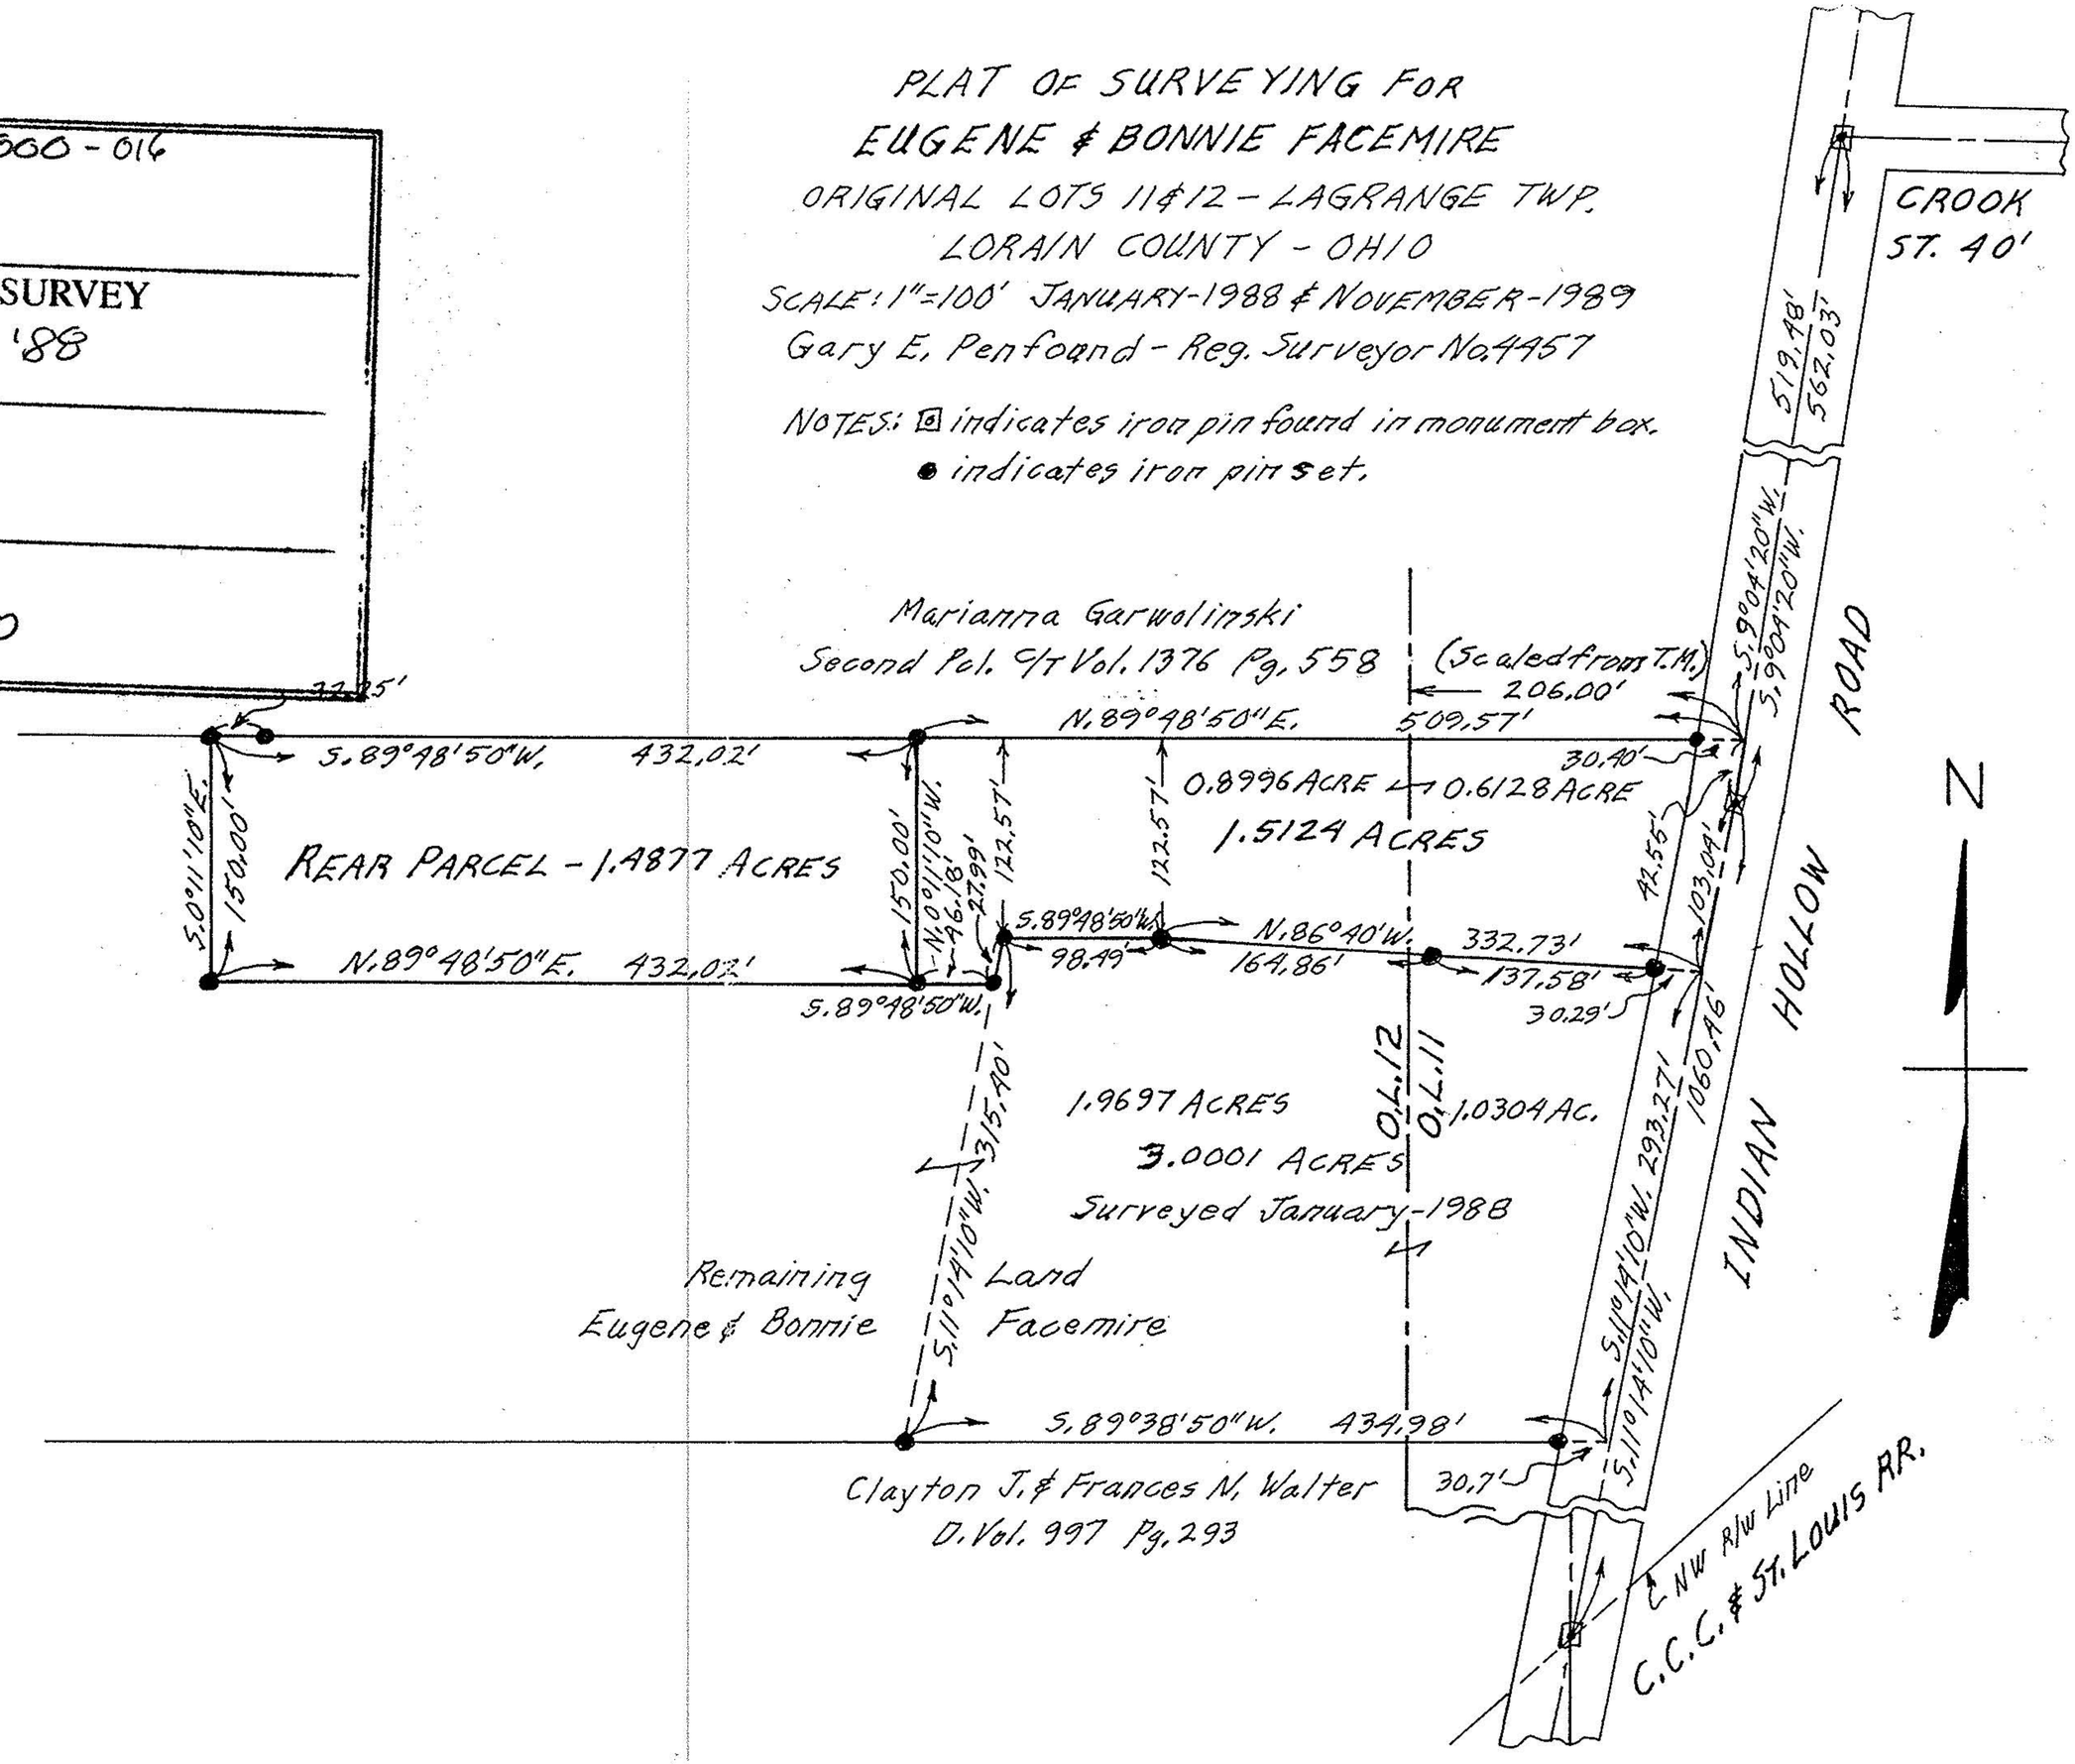
NOTES: ⊡ indicates iron pin found in monument box.
● indicates iron pin set.