20033 15-00-097-000

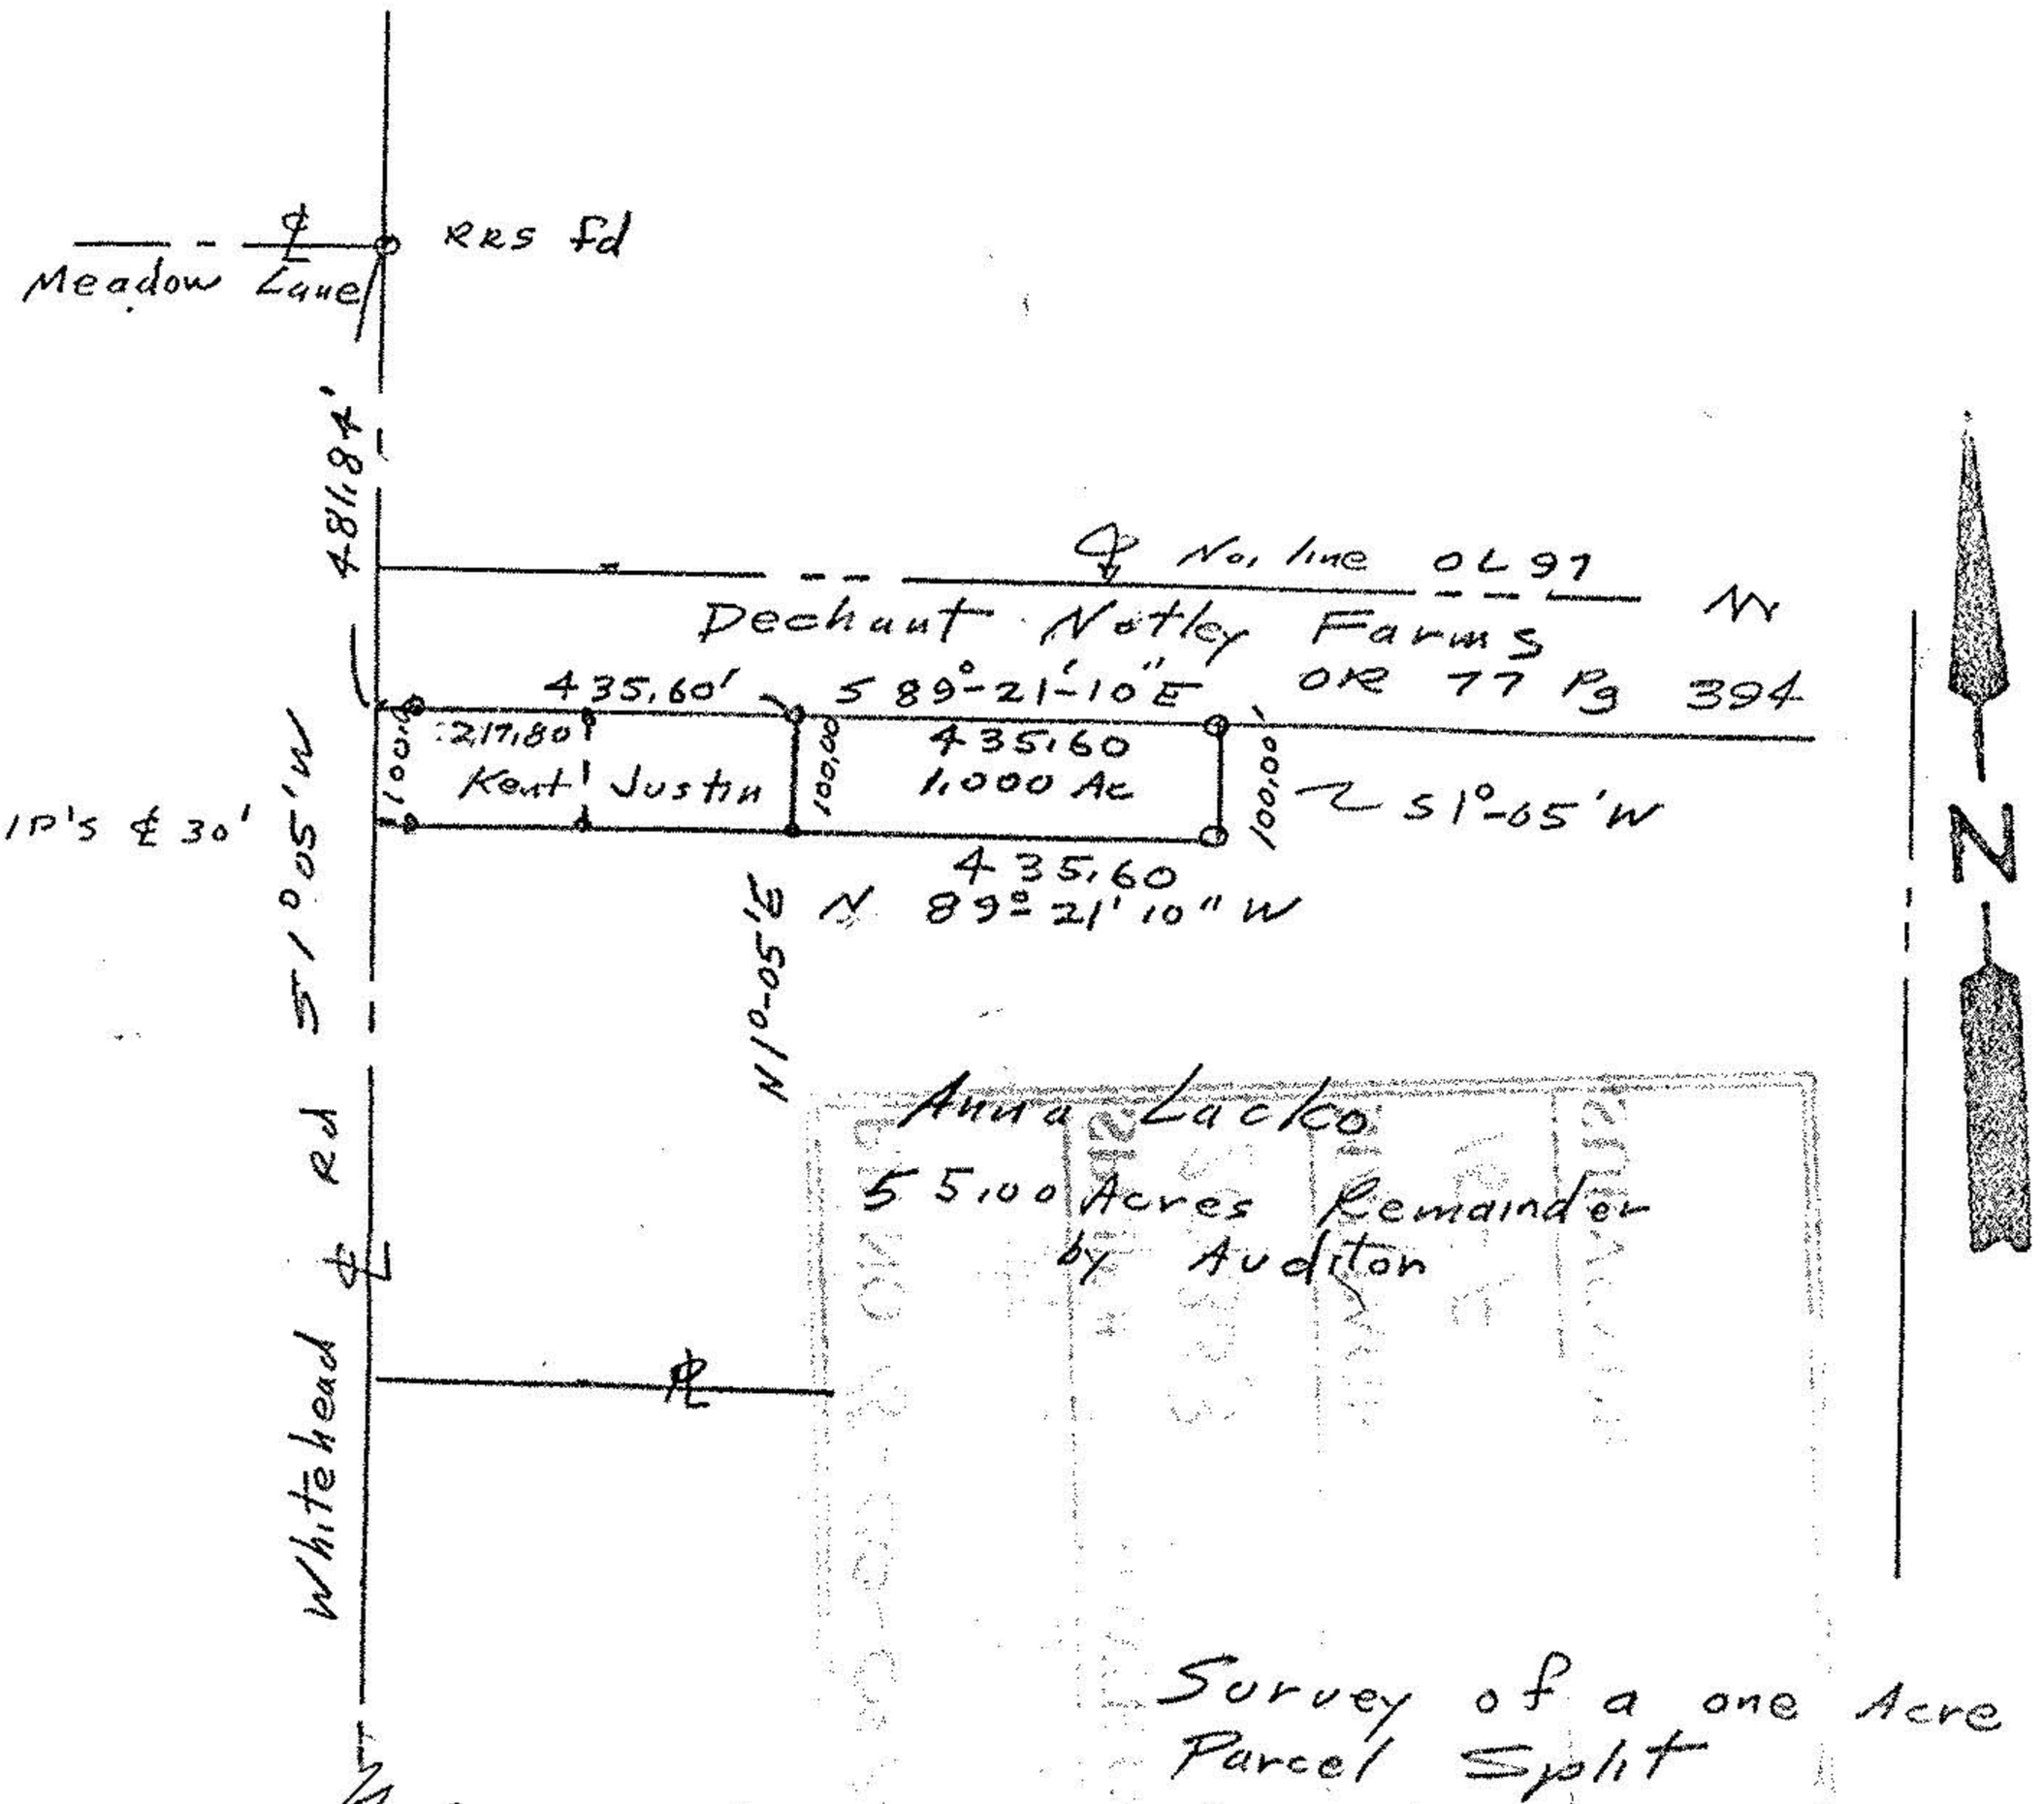

Survey of a one Acre Parcel Split

John Pozywak
Reg Surveyor 5292

- ● Iron pipes fd
- ○ Iron pipes set
- □ MB

STATE OF OHIO
JOHN POZYWAK
5292
REGISTERED SURVEYOR

ORIGINAL LOT 97	DATE Jan 25, 93
TOWNSHIP LaGrange	SCALE 1" = 300'
CITY OF N/A	FIELD BOOK NA
COUNTY OF Lorain	DRAWN BY JPoz
STATE OF Ohio	CHECKED BY Idem
W. O.	FILE NO. 15-97

15-00-097-000