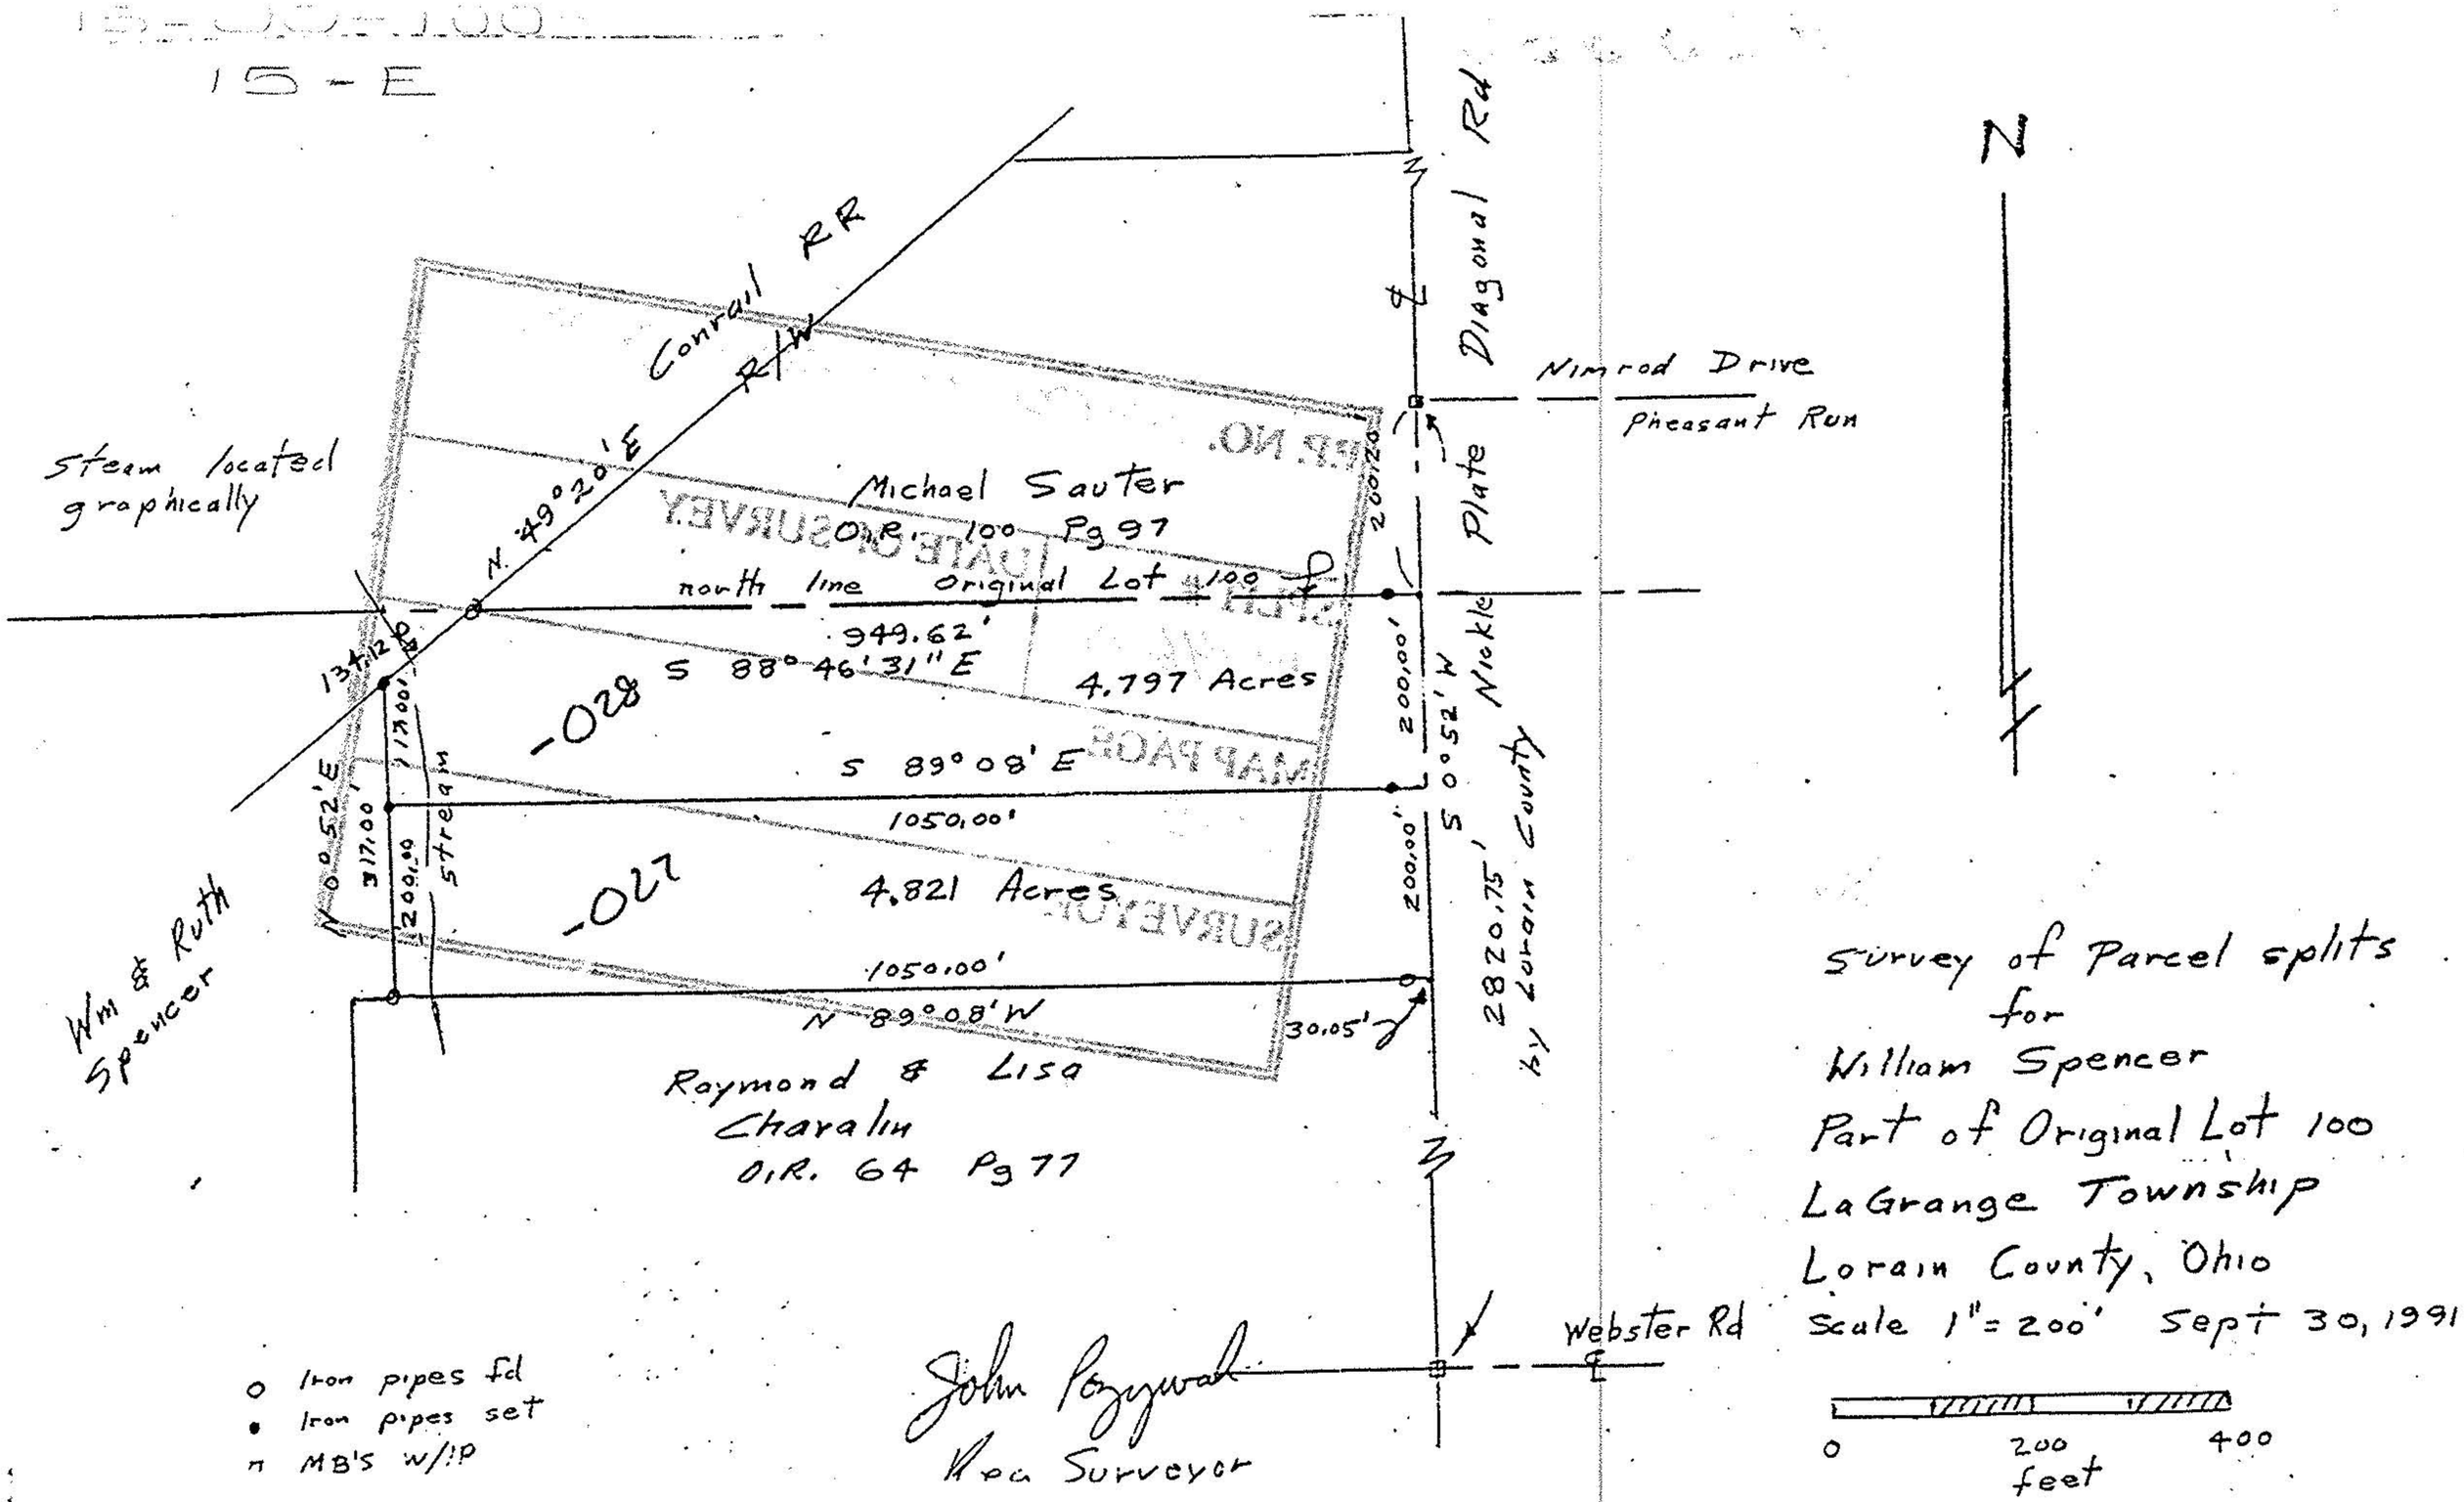
15-E
Conrail RR
R/W
N. 49°20'E
Steam located graphically
Michael Sauter
O.R. 100 Pg 97
north line Original Lot 100
949.62'
S 88°46'31"E
4.797 Acres
-028
S 89°08'E
1050.00'
4.821 Acres
-027
1050.00'
N 89°08'W
134.12
117.00'
317.00'
200.00
N 0°52'E
stream
Wm & Ruth Spencer
Raymond & Lisa Charalin
O.R. 64 Pg 77
Diagonal Rd
Nimrod Drive
Pheasant Run
Plate
Nickle
200.20
200.00'
S 0°52'W
200.00'
2820.75'
by Lorain County
30.05'
Webster Rd
N
Survey of Parcel splits
for
William Spencer
Part of Original Lot 100
LaGrange Township
Lorain County, Ohio
Scale 1" = 200' Sept 30, 1991
0
200
400
feet
o Iron pipes fd
• Iron pipes set
n MB's w/IP
John Pozywak
Reg Surveyor