


O.L. 77

SURVEY FOR RONALD HUMPHREYS
O.L. 77 LAGRANGE TOWNSHIP
JOHN R. HAMILTON REG. SURVEYOR #6861
MAY 3, 1984

SCALE
1" = 100'

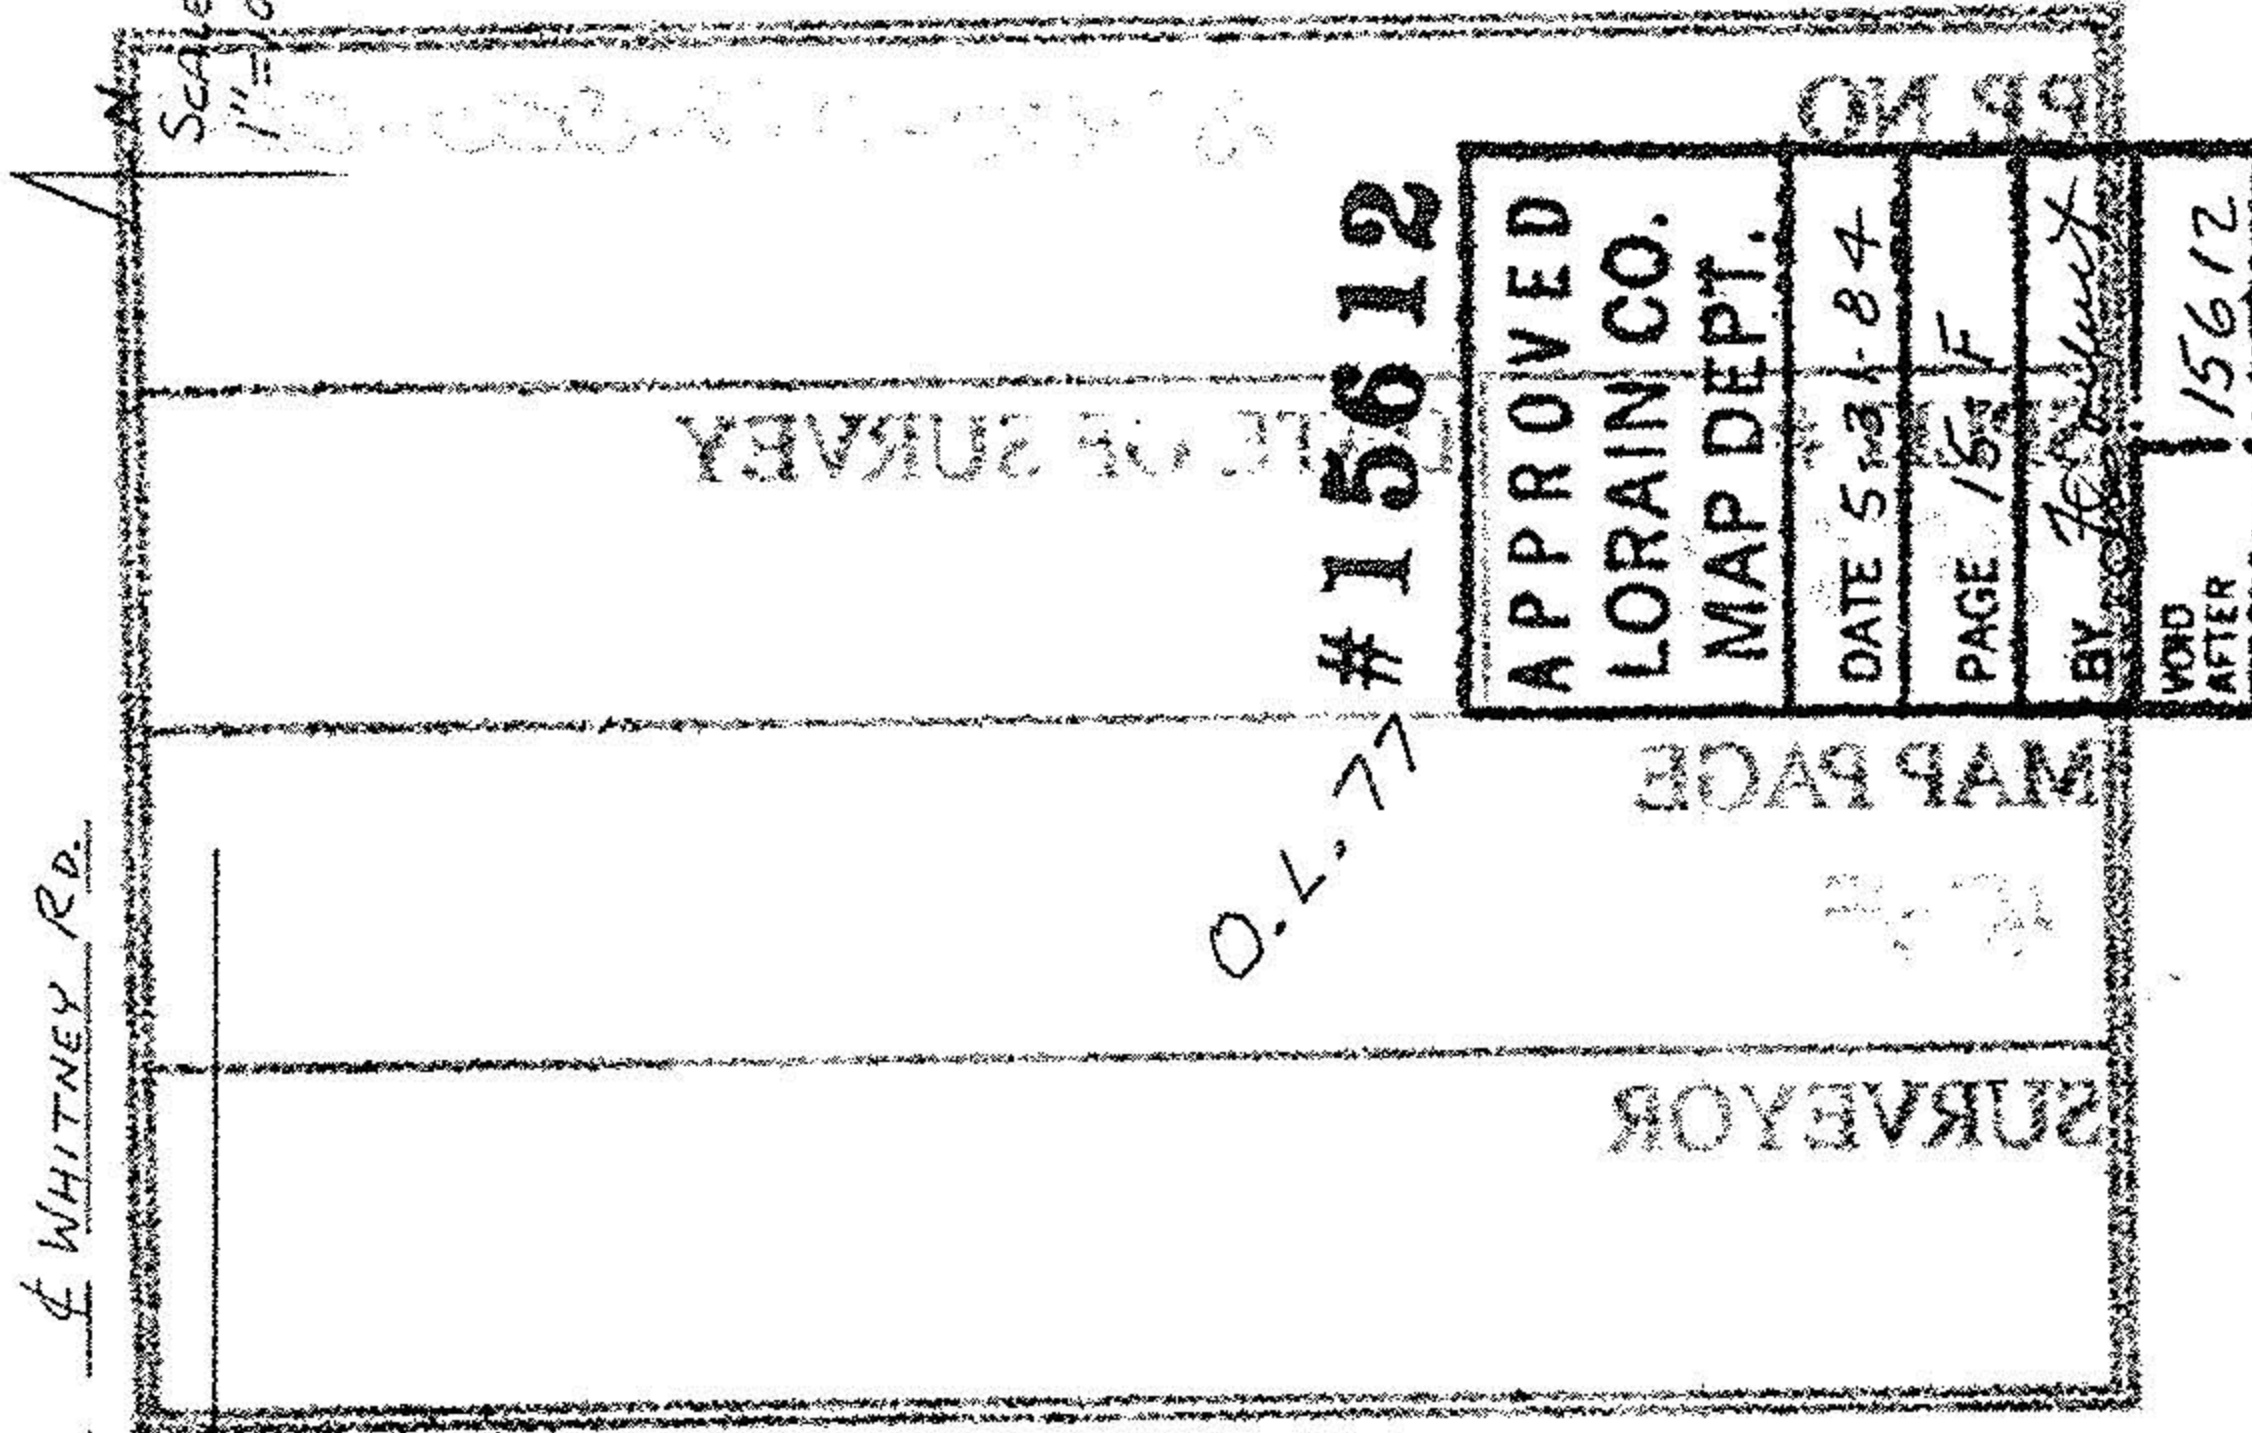

O.L. 77 #15612

SURVEYOR
MAP PAGE

WHITNEY RD.

MON. BOX
I.P. FD.

213.52'
S 0° 56' 40" W

MON. BOX
I.P. FD.

359.27'
S 2° 28' 05" W


130.00'
I.P. FD.

170.00'
S 2° 28' 05" W

130.00'
I.P. FD.

(.74' NORTH)

WHITEHEAD RD.
60' R/W

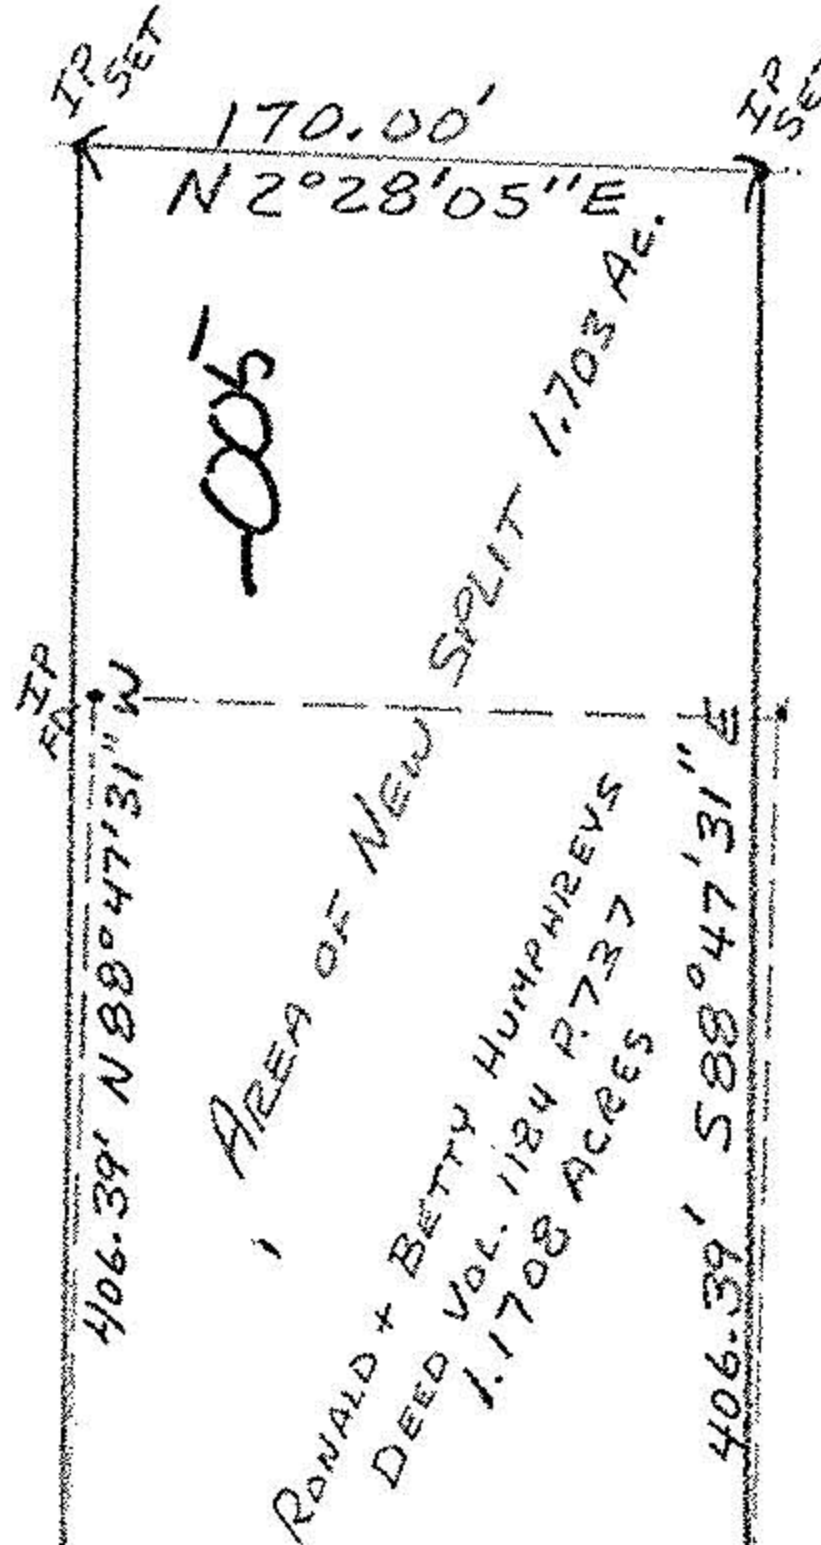

005