


713.66  
+200.20  
913.86

458.90  
455.26  
913.86

REFERENCE  
MATERIAL FOR  
TIE-IN ON  
THIS SPLIT

INFORMATION TO TRY -005  
& TIE-IN A DIMENSION 69.81 A.  
FROM @ CONRML TO  
N. LINE OL 100, AS AERIAL  
LOOKS DIFFERENT THAN J. SCHMIDT AND R.D. ROBINSON

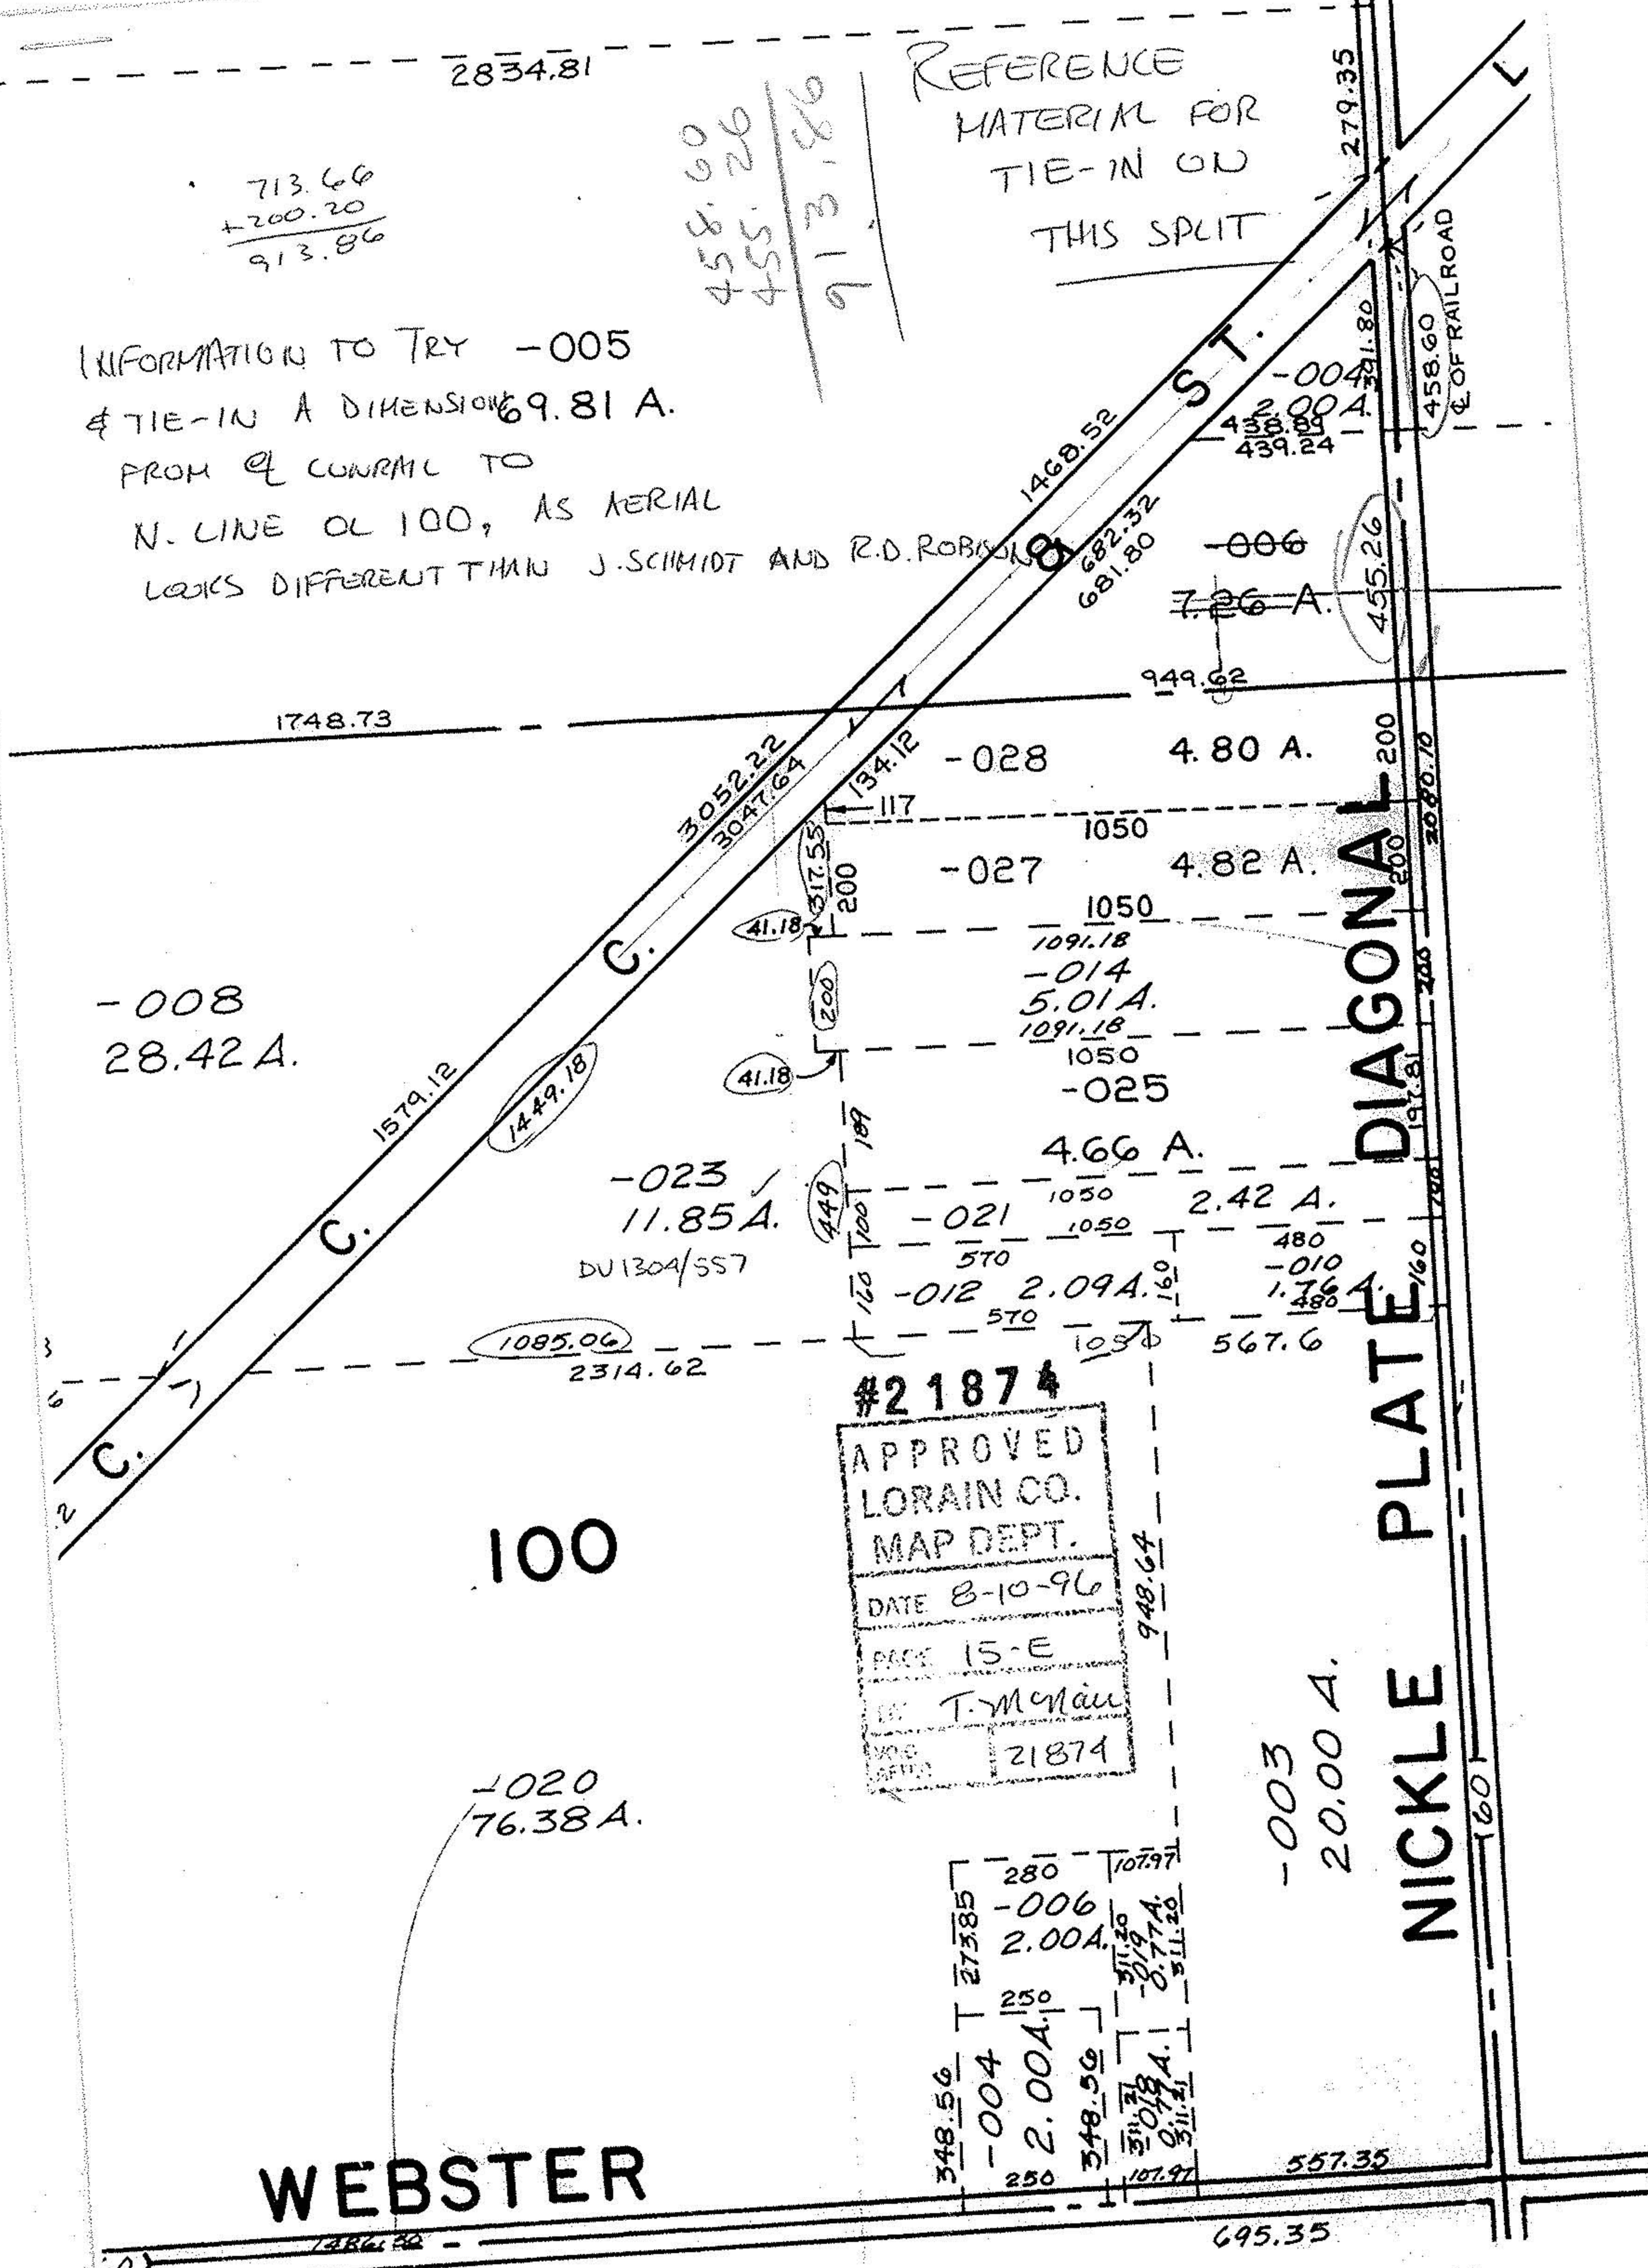

#21874  
APPROVED  
LORAIN CO.  
MAP DEPT.  
DATE 8-10-96  
PAGE 15-E  
BY T. McMan  
VOL 21874

WEBSTER

DIAGONAL  
NICKLE PLATE

LOTS 58 THRU 63, 78 THRU