

9-A


0.4.43

16142

09-00-033-000

09-00-043-000

9-A

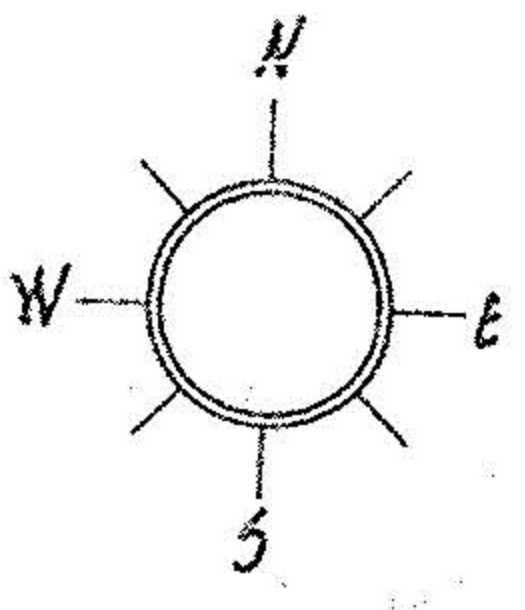

MONUMENT

589°07'55"E, 540.38'

09-00-033-000

-014
4.165 ACRES

IRON PIN SET

797.80

PYLE SOUTH AMHERST ROAD

N 3°00'15"E

09-00-043-000

5.850 ACRES

-027

ORIGINAL LOT 33
ORIGINAL LOT 43

N 3°00'15"E, 817.94'

586°59'45"E 540.00'

IRON PIN SET

IRON PIN SET

1064.02

MONUMENT

16142

| |
|-----------------------|
| APPROVED |
| LORAIN CO. |
| MAP DEPT. |
| DATE 4-23-85 |
| PAGE 9-A |
| BY <i>[Signature]</i> |
| VOID AFTER 16142 |

ACREAGE 10.015
 DATE 01-31-85
 DRAWN MGH
 SCALE 1" = 200 ft.

PREPARED FOR MR. RON SPIEGELBERG 949 7474
4289 EAST LAKE RD., SHEFFIELD LAKE, O. 44054

MICHAEL G. HURA, registered surveyor
 12706 MASON RD., VERMILION, O., Ph (216) 965 4040

PERIMETER SURVEY

SUBLOT(s) _____ of _____
 _____ Volume _____ Page _____ of PLATS
 PART OF O.L. 33/43 TRACT _____ SECTION _____ OF
RUSSIA TOWNSHIP LORAIN CO., OHIO
 PERMANENT PARCEL NO _____



CITY OF