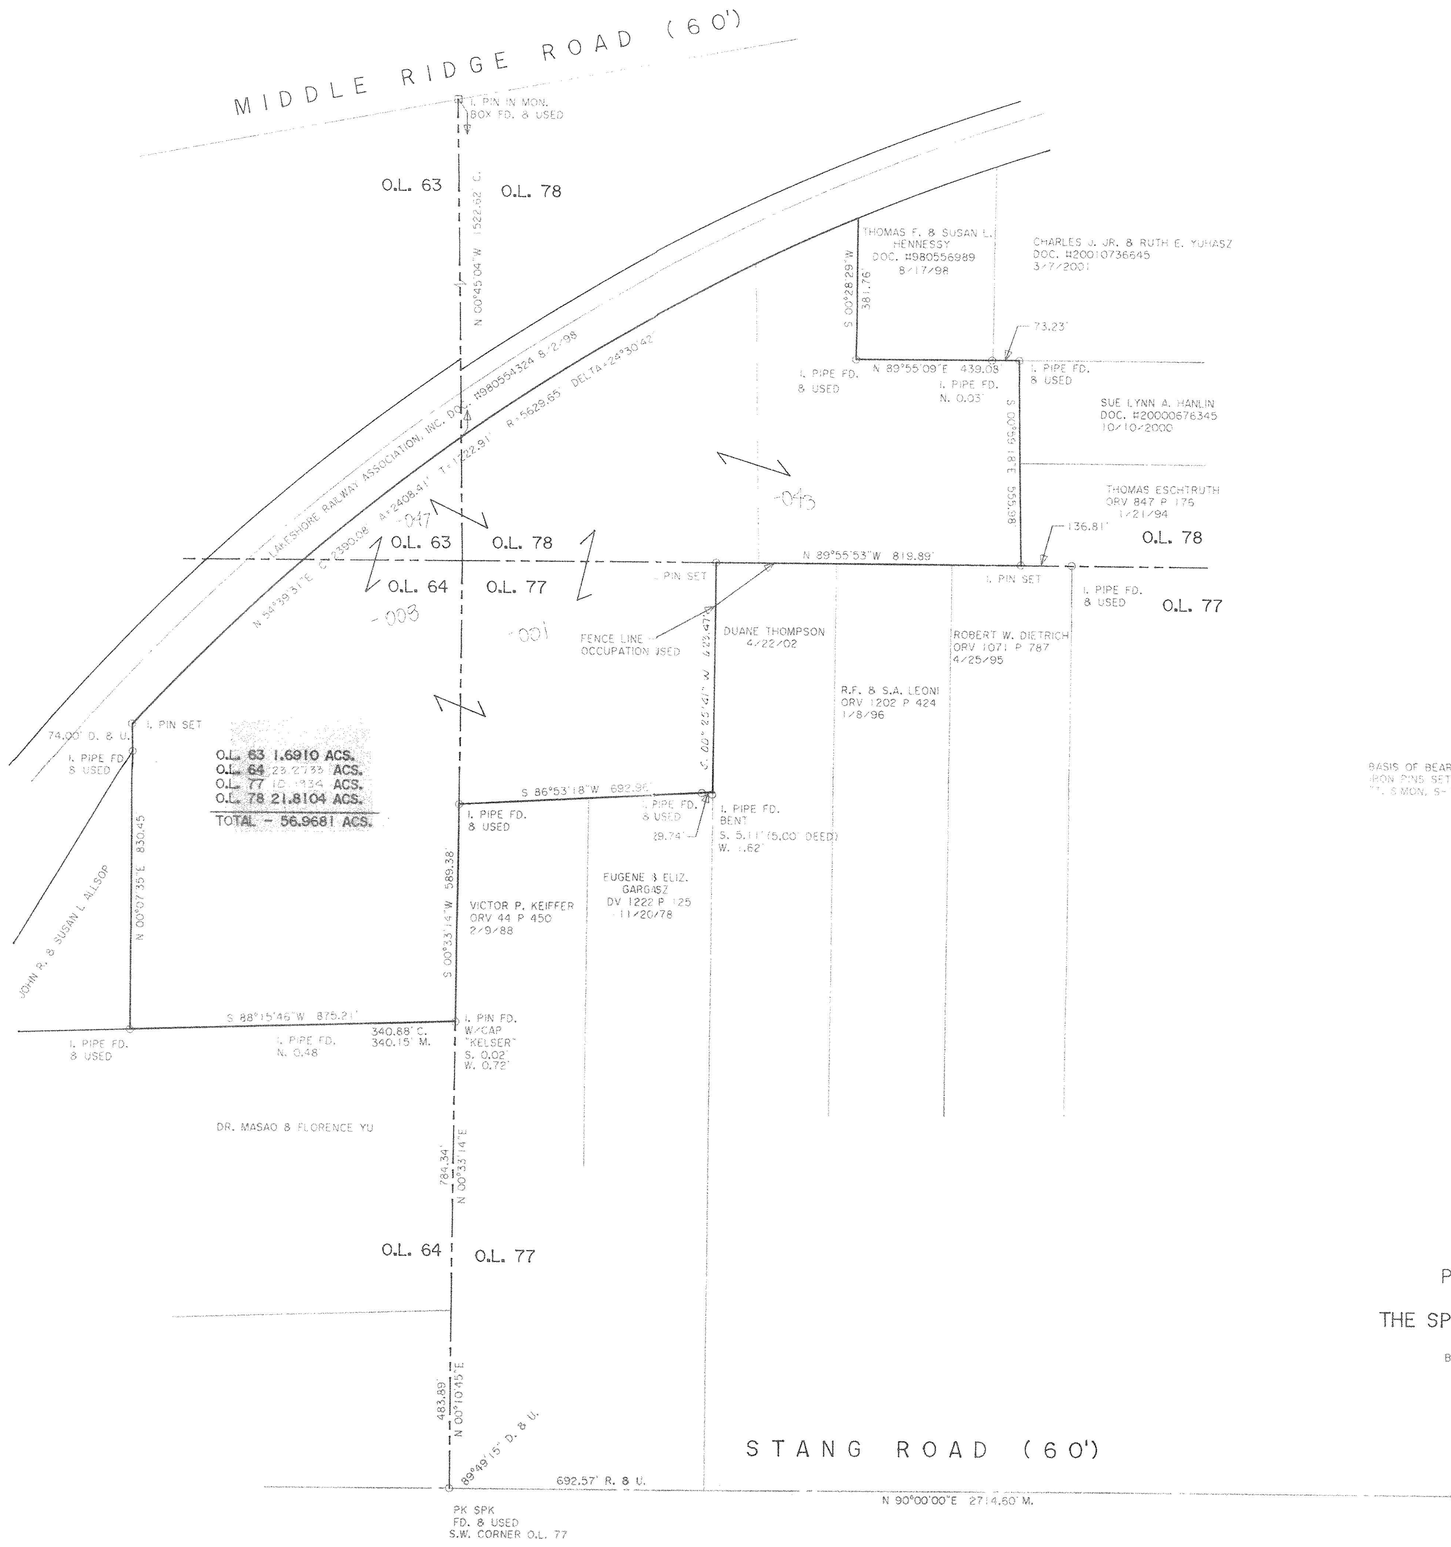

200 0 200 400 600
GRAPHIC SCALE - FEET

N

DIMENSIONS SHOWN ON THIS PLAT ARE EXPRESSED IN FEET AND DECIMAL PARTS THEREOF. ALL BEARINGS ARE TO AN ASSUMED MERIDIAN AND ARE USED TO INDICATE ANGLES ONLY. PERMANENT MONUMENTS WERE FOUND OR SET AT ALL POINTS INDICATED HEREON. ALL OF WHICH I CERTIFY TO BE CORRECT.

THOMAS A. SIMON
REG. PROFESSIONAL SURVEYOR
NO. S-7775

BASIS OF BEARINGS IS THE CENTERLINE OF STANG ROAD (NORTH 90°00'00" EAST).
IRON PINS SET ARE 5/8" DIAMETER, 30" LONG WITH PLASTIC CAPS "T. S MON. S-7775".

№ 01729

8-13-04
5-00-078-B
JHatfield
#04-01729

PLAT OF SURVEY & COMBINATION FOR THE SPORTSMAN'S GUN AND REEL CLUB, INC.

BEING KNOWN AS PARTS OF ORIGINAL AMHERST TOWNSHIP
LOT NOS. 63, 64, 77 AND 78

COUNTY OF LORAIN STATE OF OHIO
MAY, 2004 SCALE: 1" = 200'

THOMAS SIMON & ASSOCIATES, INC.
PROFESSIONAL LAND SURVEYORS

COBBLESTONE CORNER PROFESSIONAL CENTER
39049 CENTER RIDGE ROAD
NORTH RIDGEVILLE, OHIO 44039
(440) 327-2925
FAX 327-2964

JOB NO. 2004-023