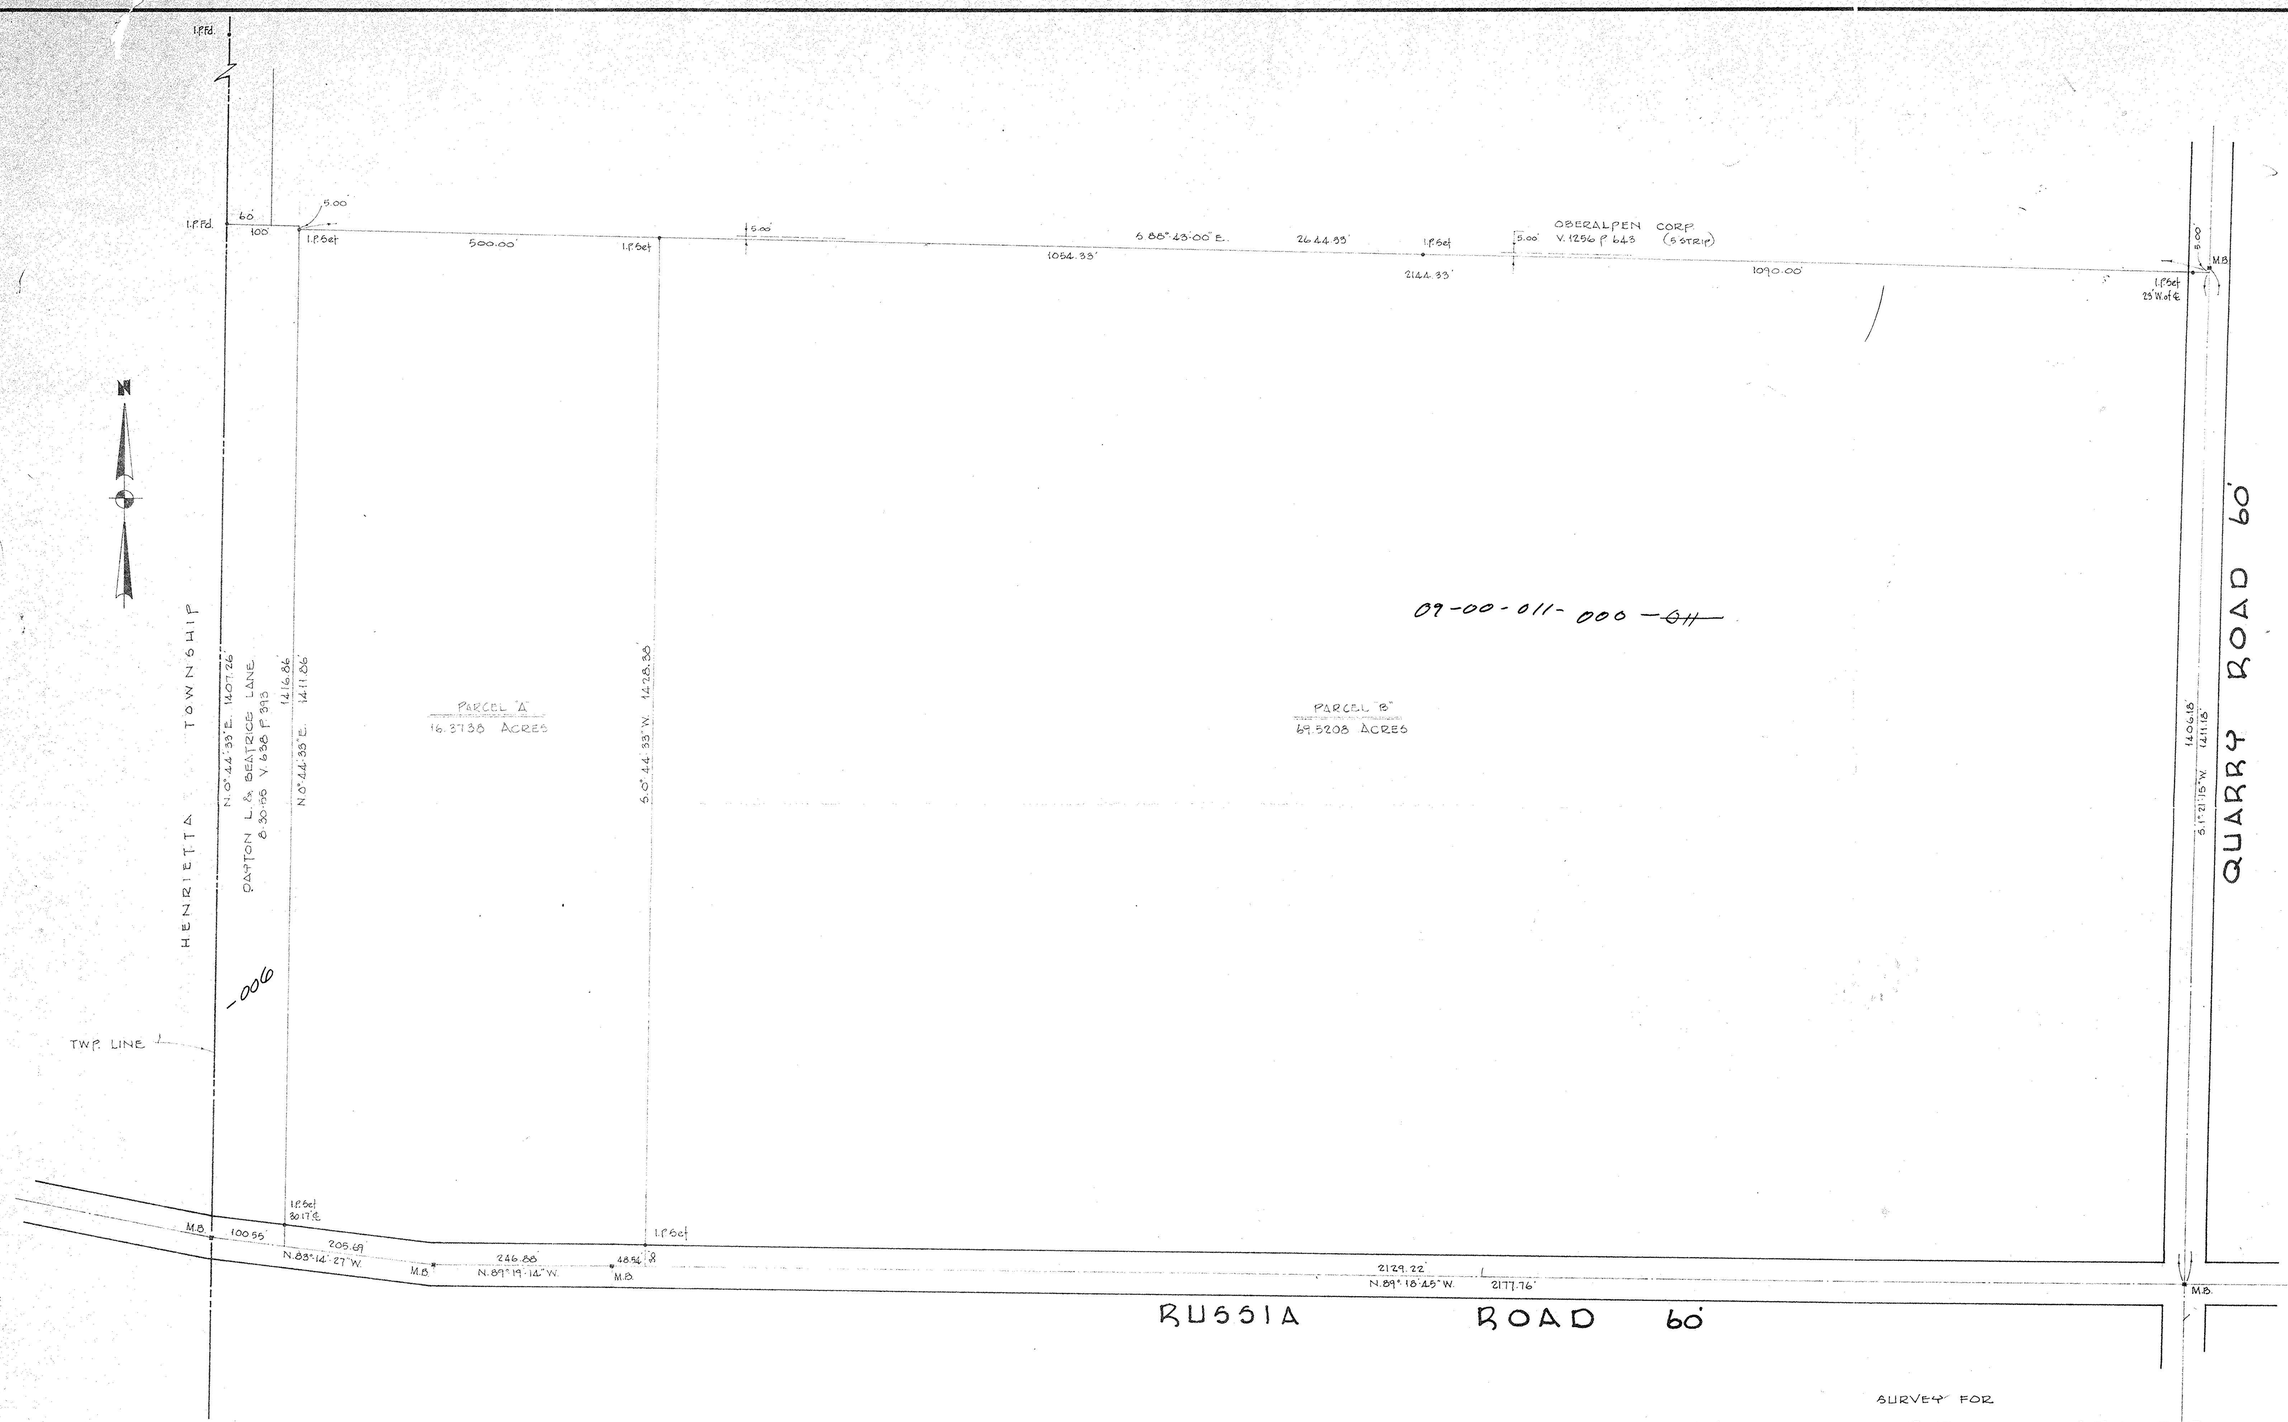

SURVEY FOR

ALMON R. BROCKSIEKER

PART OF O.L. 11 RUSSIA TOWNSHIP LORAIN COUNTY OHIO

SCALE 1" = 100' OCTOBER 18, 1984

LAUNDON • SIMON • CAHL & ASSOC.

ENGINEERS SURVEYORS

Job No 84-1327 F.B. 98 P 57