10-00-009-113

KLEINOEDER · SCHMIDT
and ASSOCIATES

ENGINEERS — SURVEYORS — CONSULTANTS in LAND PLANNING

ELYRIA · NORWALK · MEDINA OHIO

SURVEY

Sublot(s) 14 & 15

Subd'n MEADOW VIEW
P.V. 12 P.7

Township CARLISLE Tract

Orig. Lot(s) Sec. 9

County of LORAIN State of Ohio

Corporation

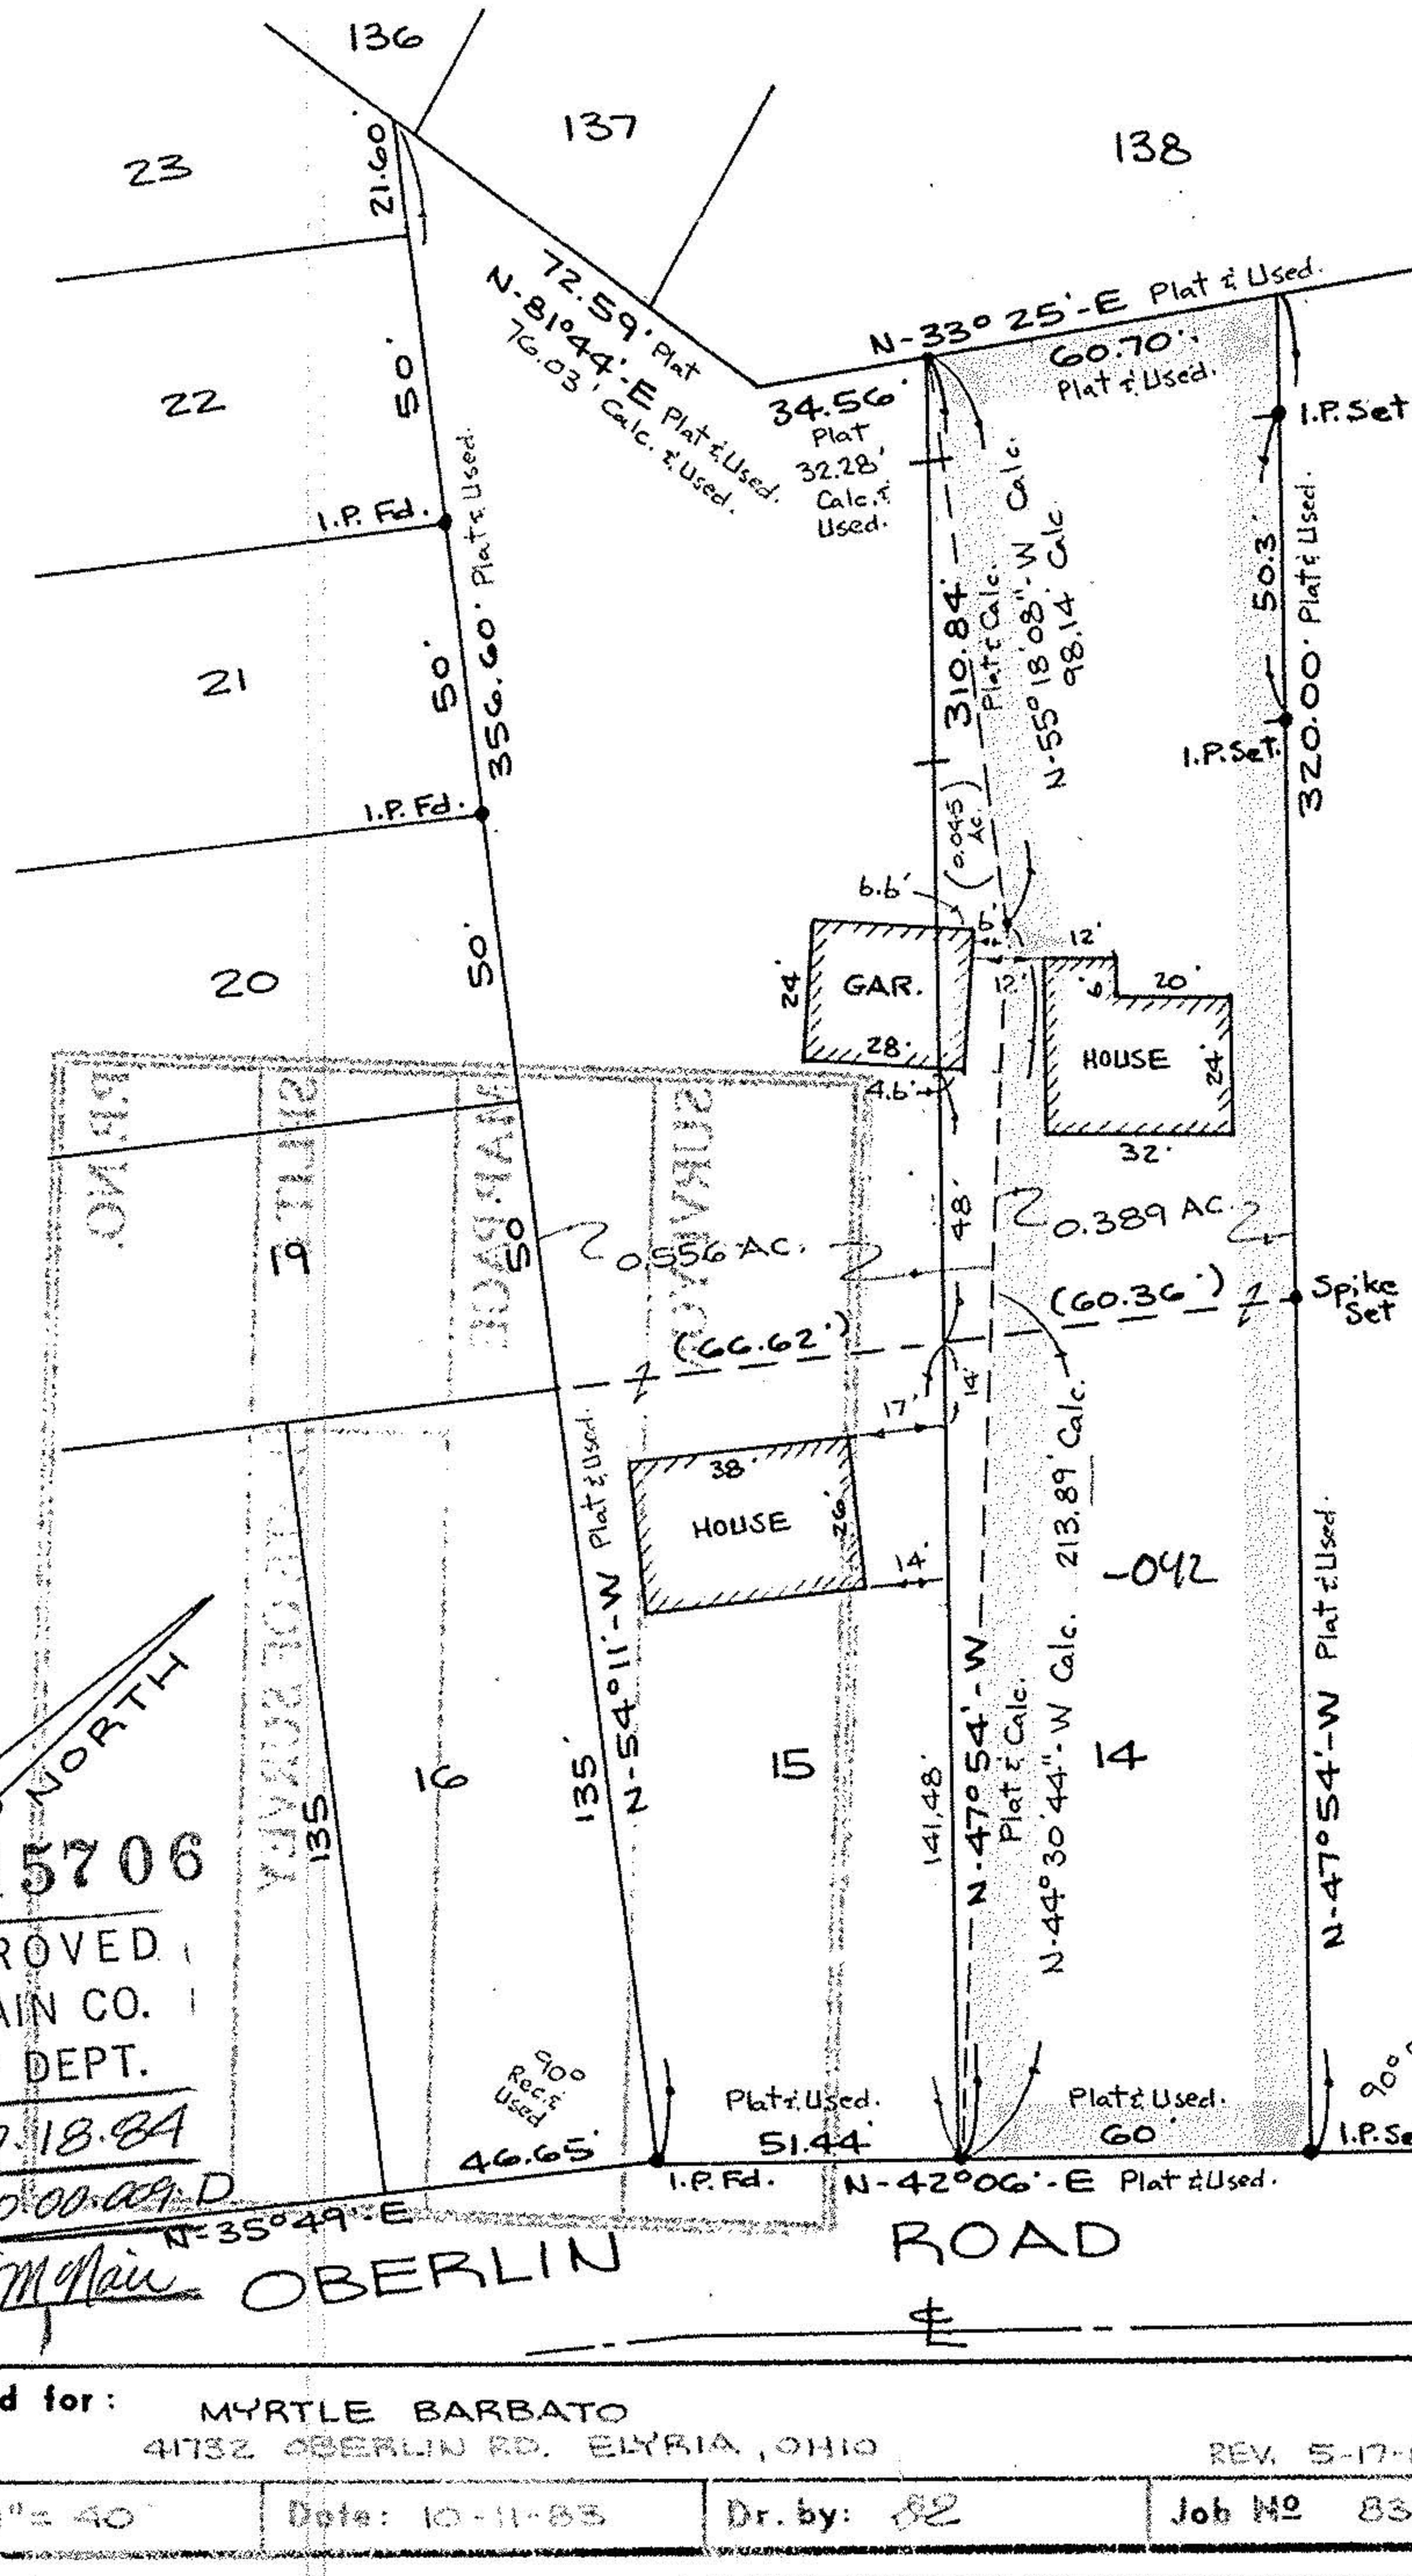

-042

#15706

APPROVED
LORAIN CO.
MAP DEPT.
DATE 7-18-84
PAGE 10.00.009.D
BY T. McNair
VOID AFTER

Prepared for: MYRTLE BARBATO
41732 OBERLIN RD. ELYRIA, OHIO

REV. 5-17-84

Scale: 1" = 40	Date: 10-11-83	Dr. by: BZ	Job No 83-127

9

10-00-009-113

#15706