10-00-014-H

LEWIS W. HALL

GEOPHYSICAL SURVEYS LAND SURVEYS TOPOGRAPHICAL SURVEYS

Registered Surveyor 201 EAST 14TH STREET ELYRIA, OHIO

No. 3975 Phone A/C 216 - 323-2062

10-00-014-000

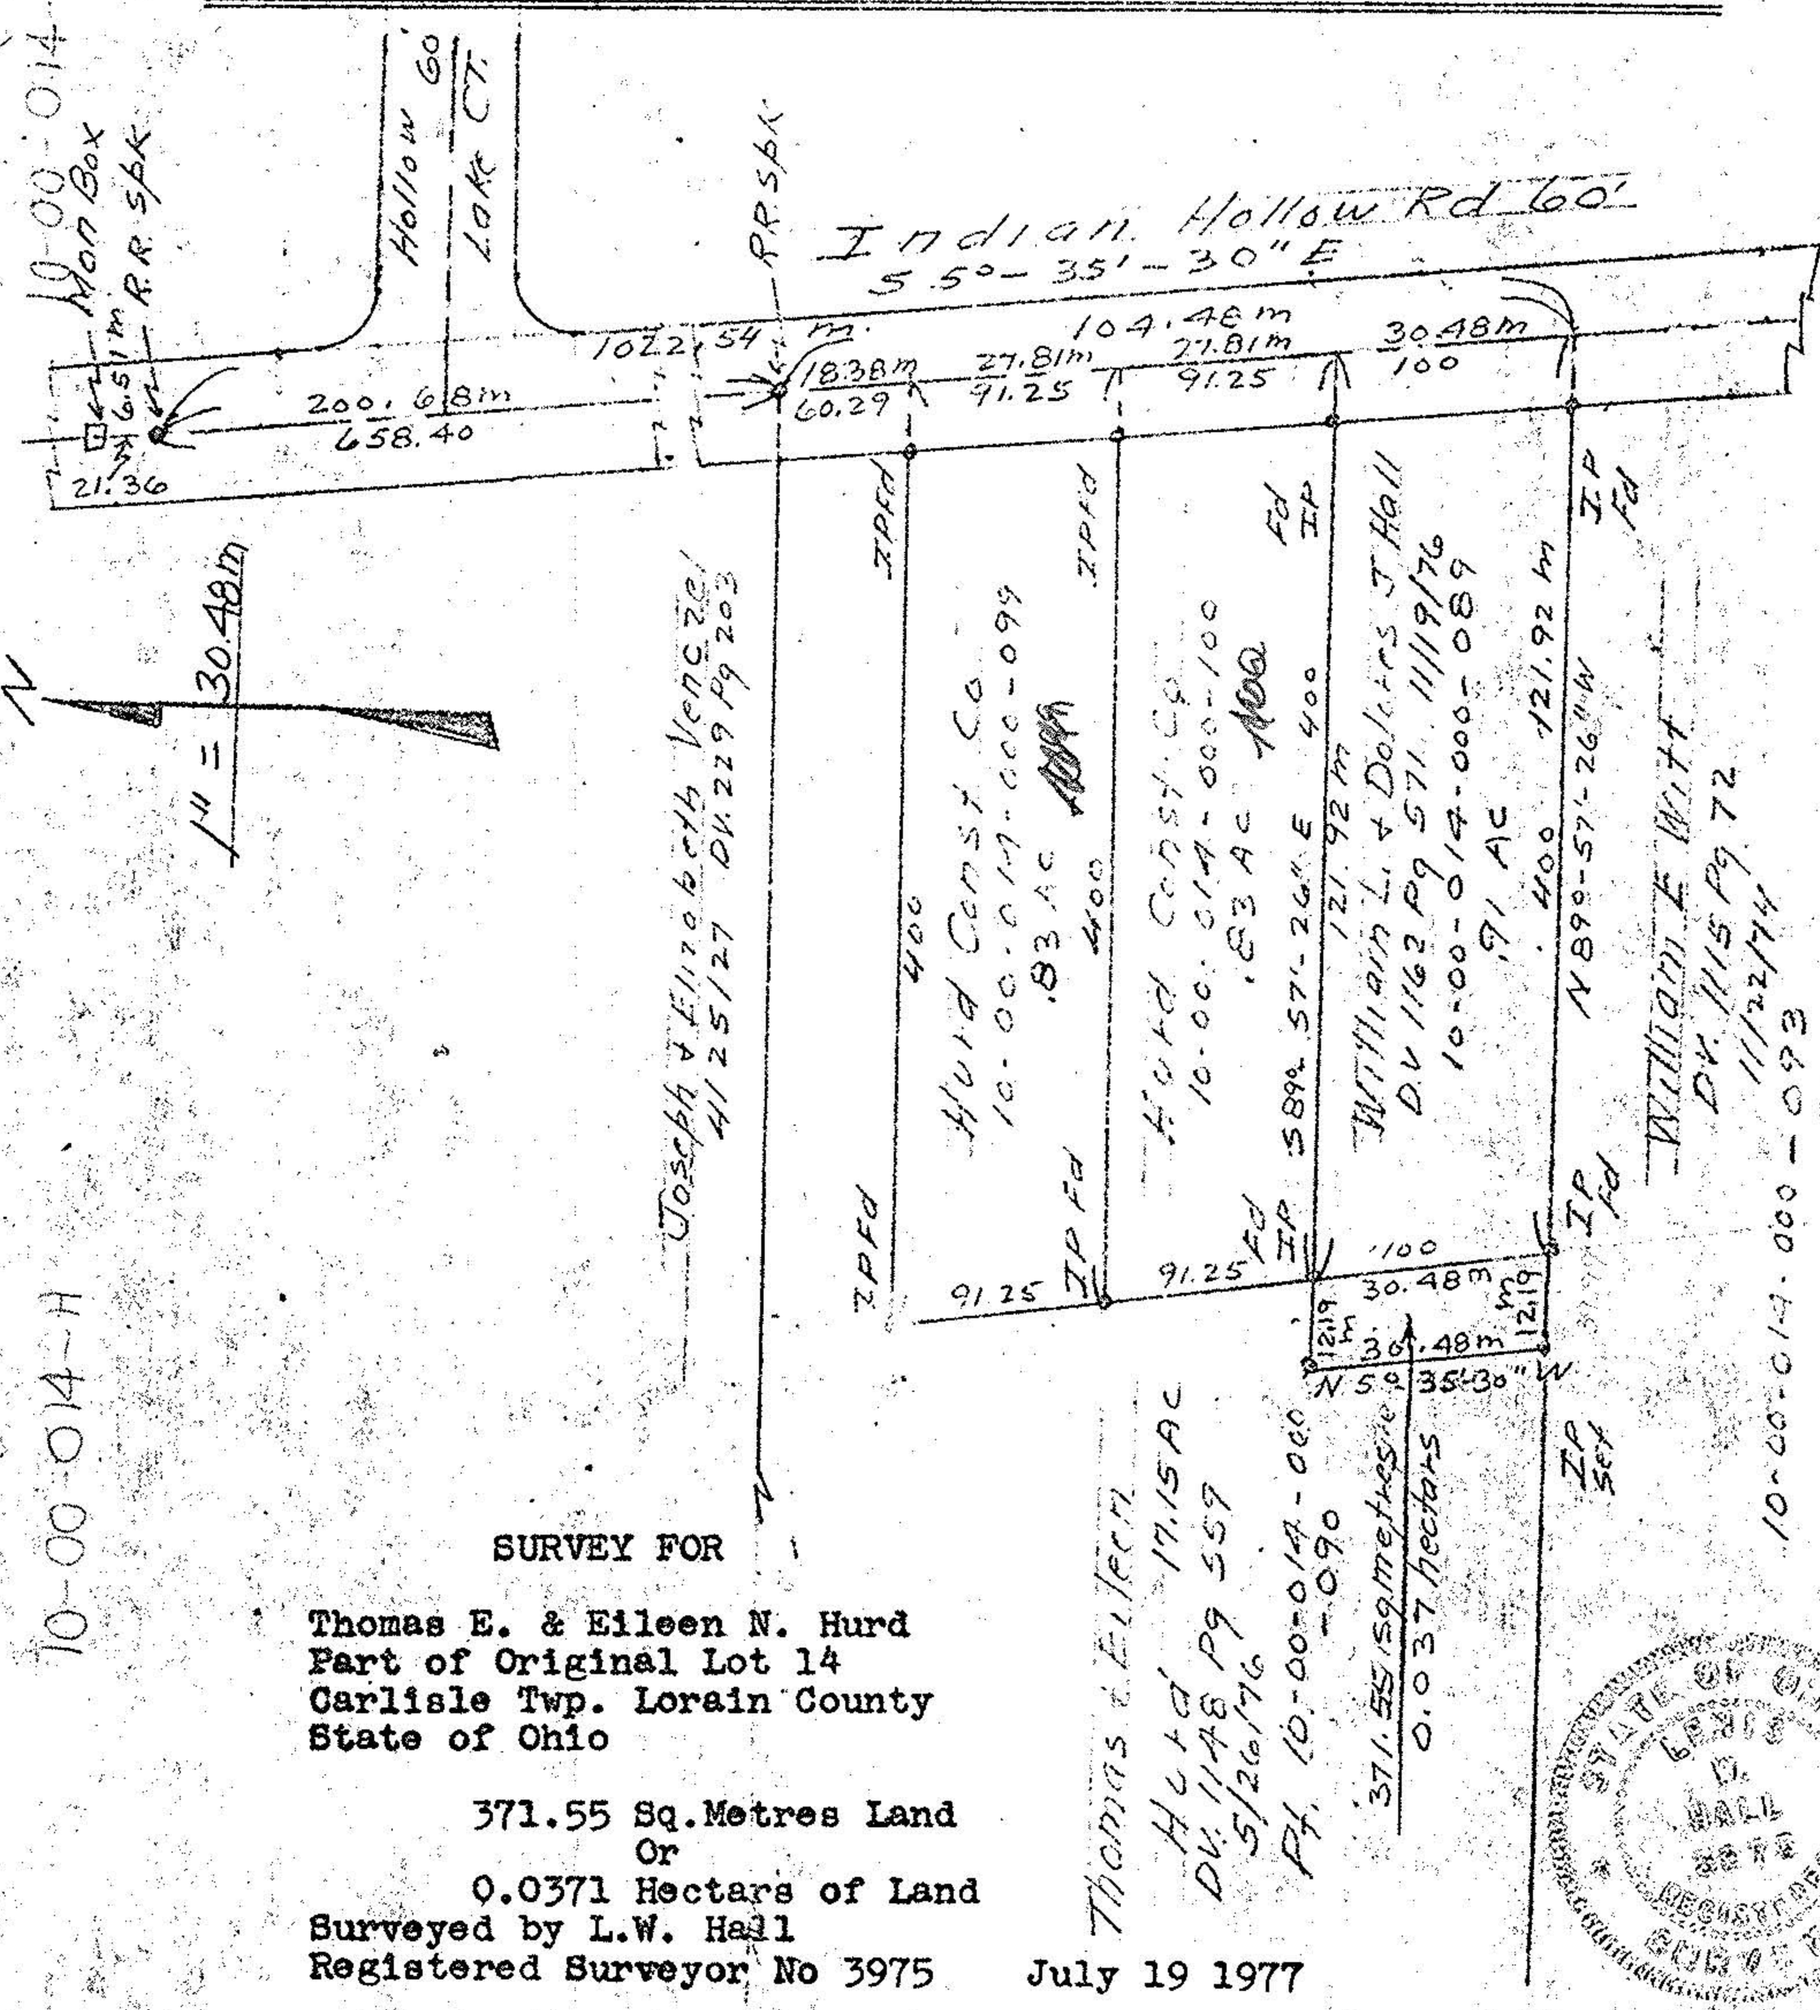

SURVEY FOR

Thomas E. & Eileen N. Hurd
Part of Original Lot 14
Carlisle Twp. Lorain County
State of Ohio

371.55 Sq. Metres Land
Or
0.0371 Hectars of Land
Surveyed by L.W. Hall
Registered Surveyor No 3975 July 19 1977

10-00-014-H

10-00-014-000