10-00-015-089

10-00-015-063

KLEINOEDER · SCHMIDT and ASSOCIATES

ENGINEERS — SURVEYORS — CONSULTANTS in LAND PLANNING

ELYRIA · NORWALK · MEDINA OHIO

PLOT PLAN

JOB Nº 82-52

SUBLOT ALL OF 163 & PART OF 164

SUBDIVISION BRENTWOOD ALLOTMENT Nº 4 P.V. 19 P. 20-21

OTHER 0.5162 AC.

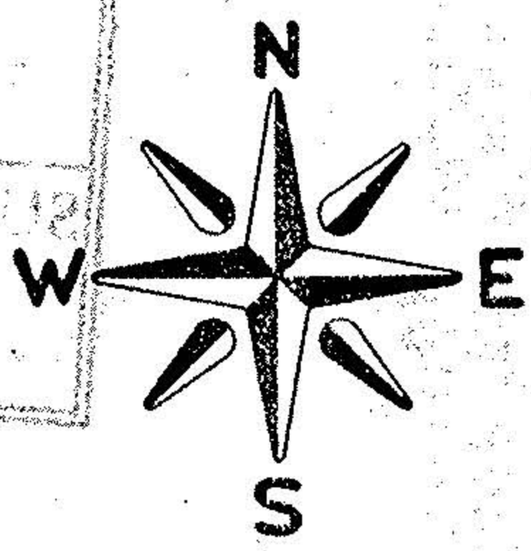

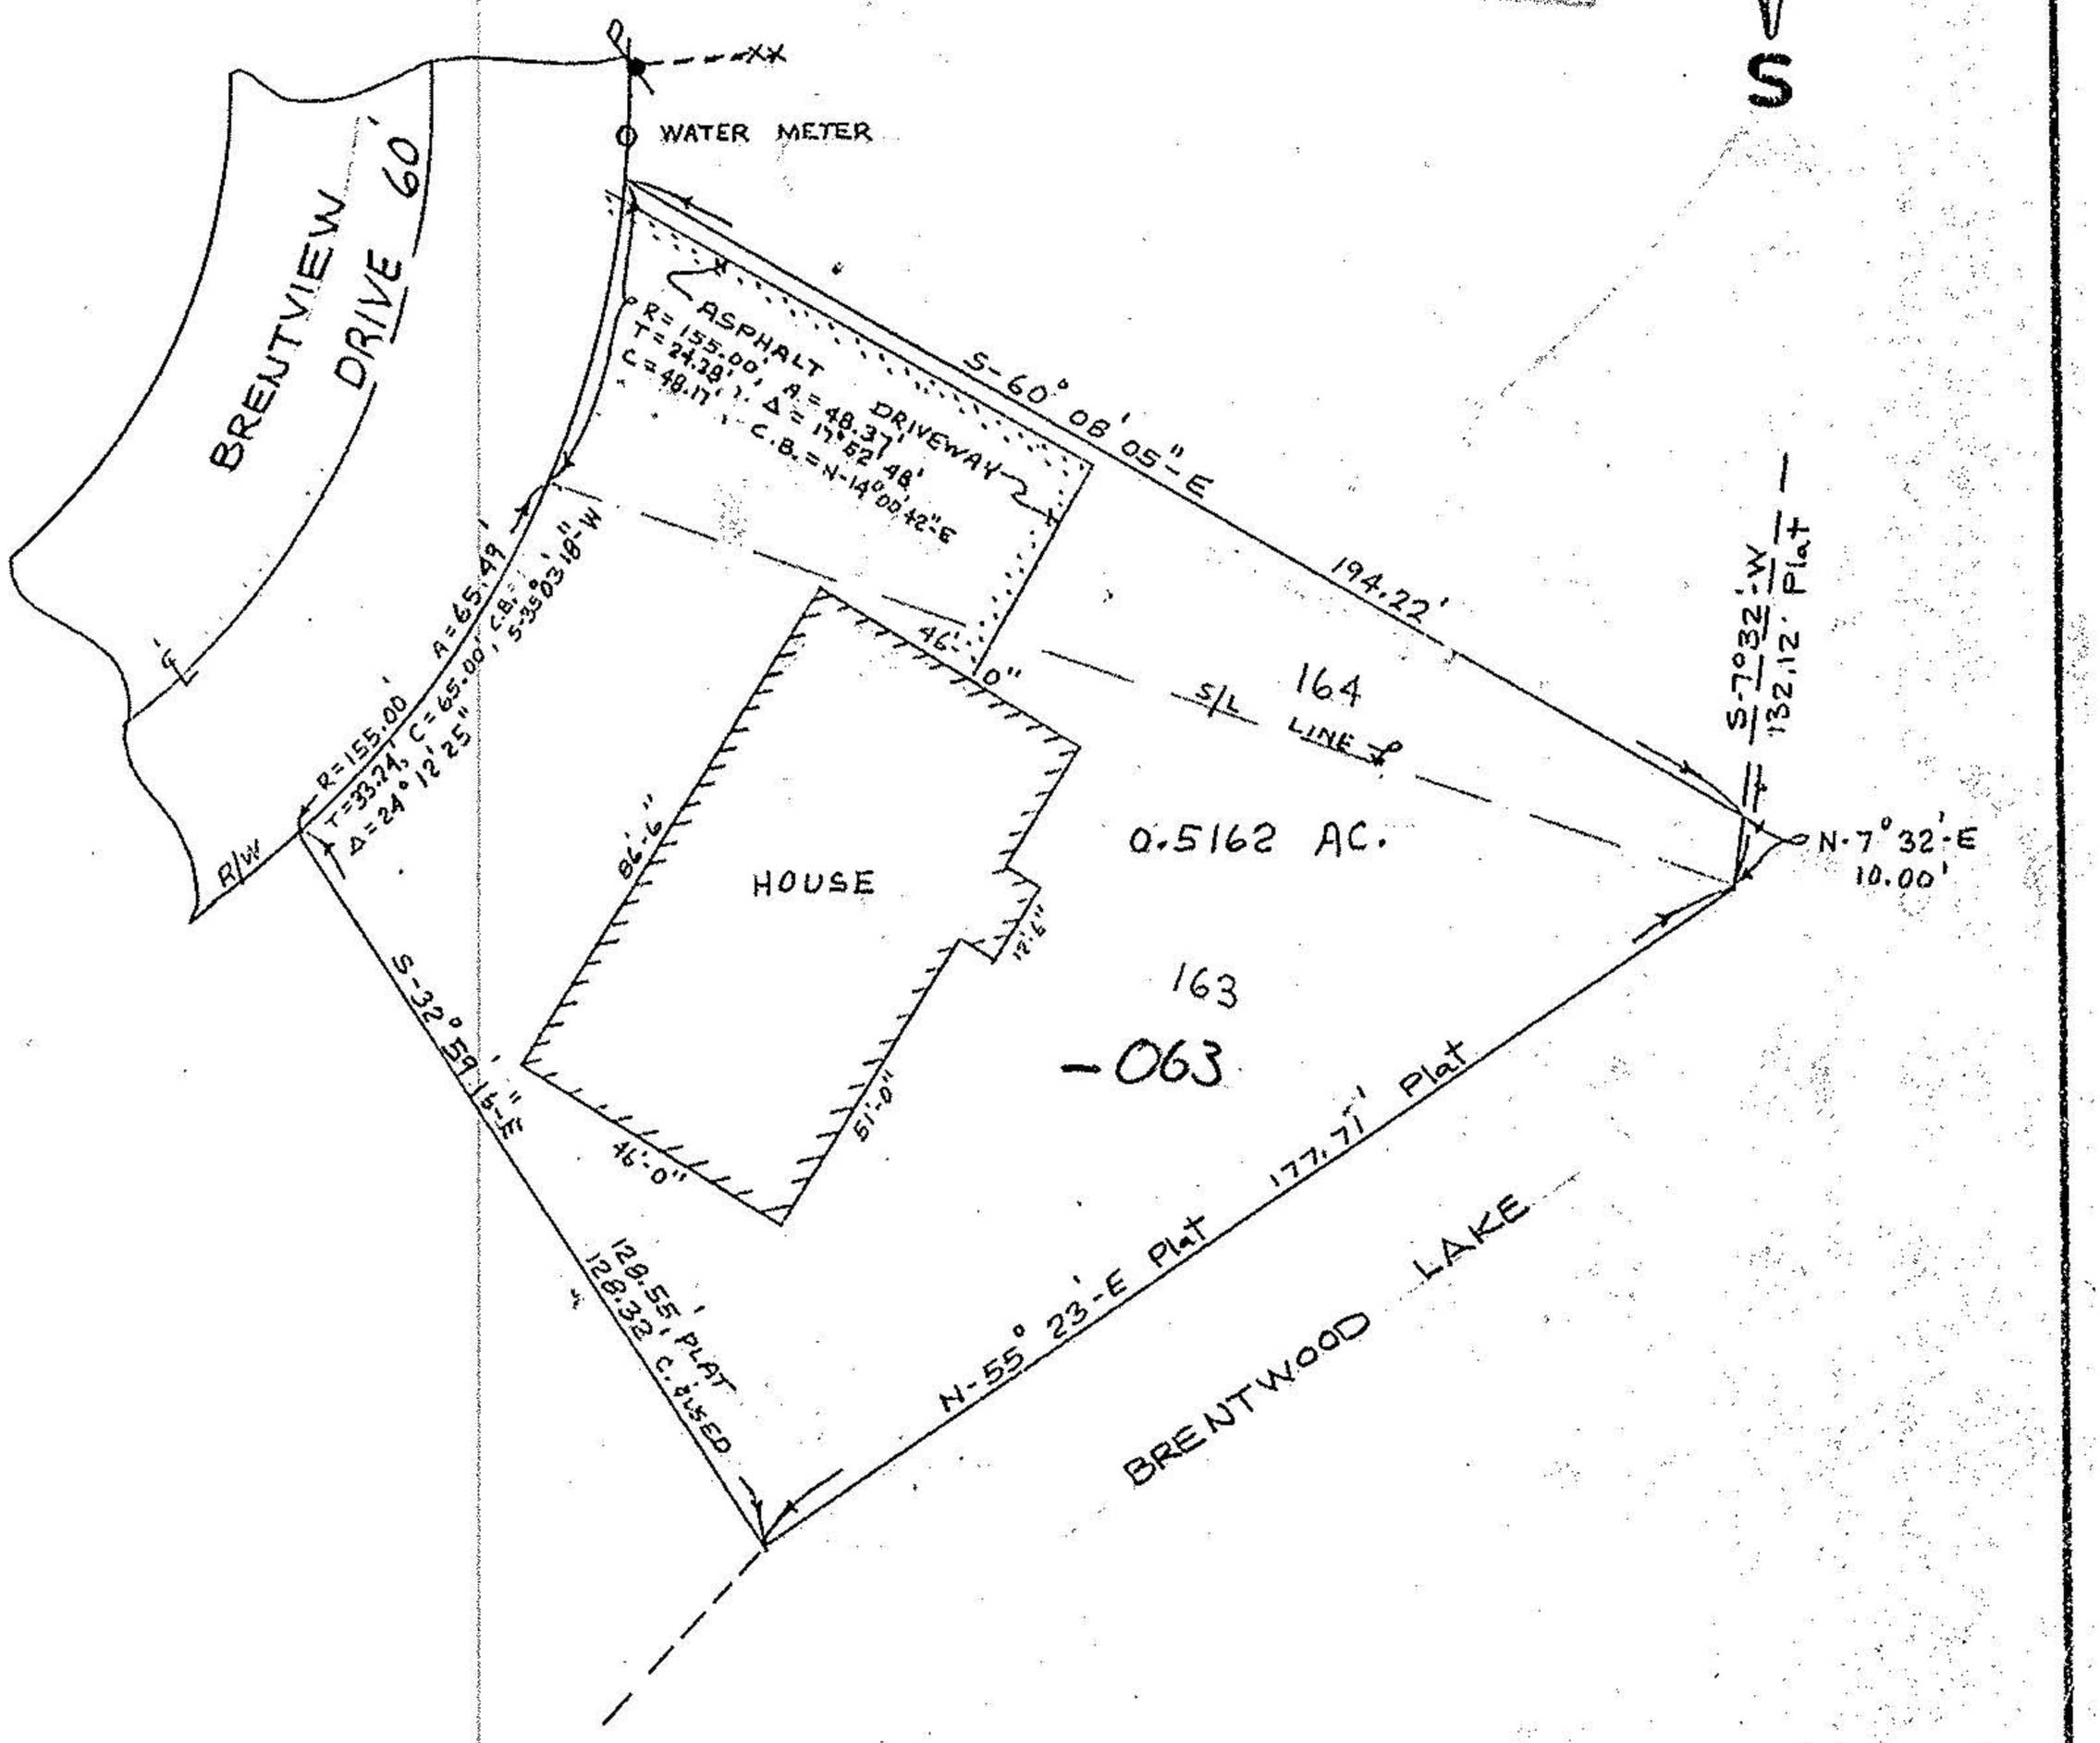

Prepared for: DEL SPITZER

Scale: 1" = 40' Date: JULY 15th., 1982 REV. 9-22-83

10-00-015-089