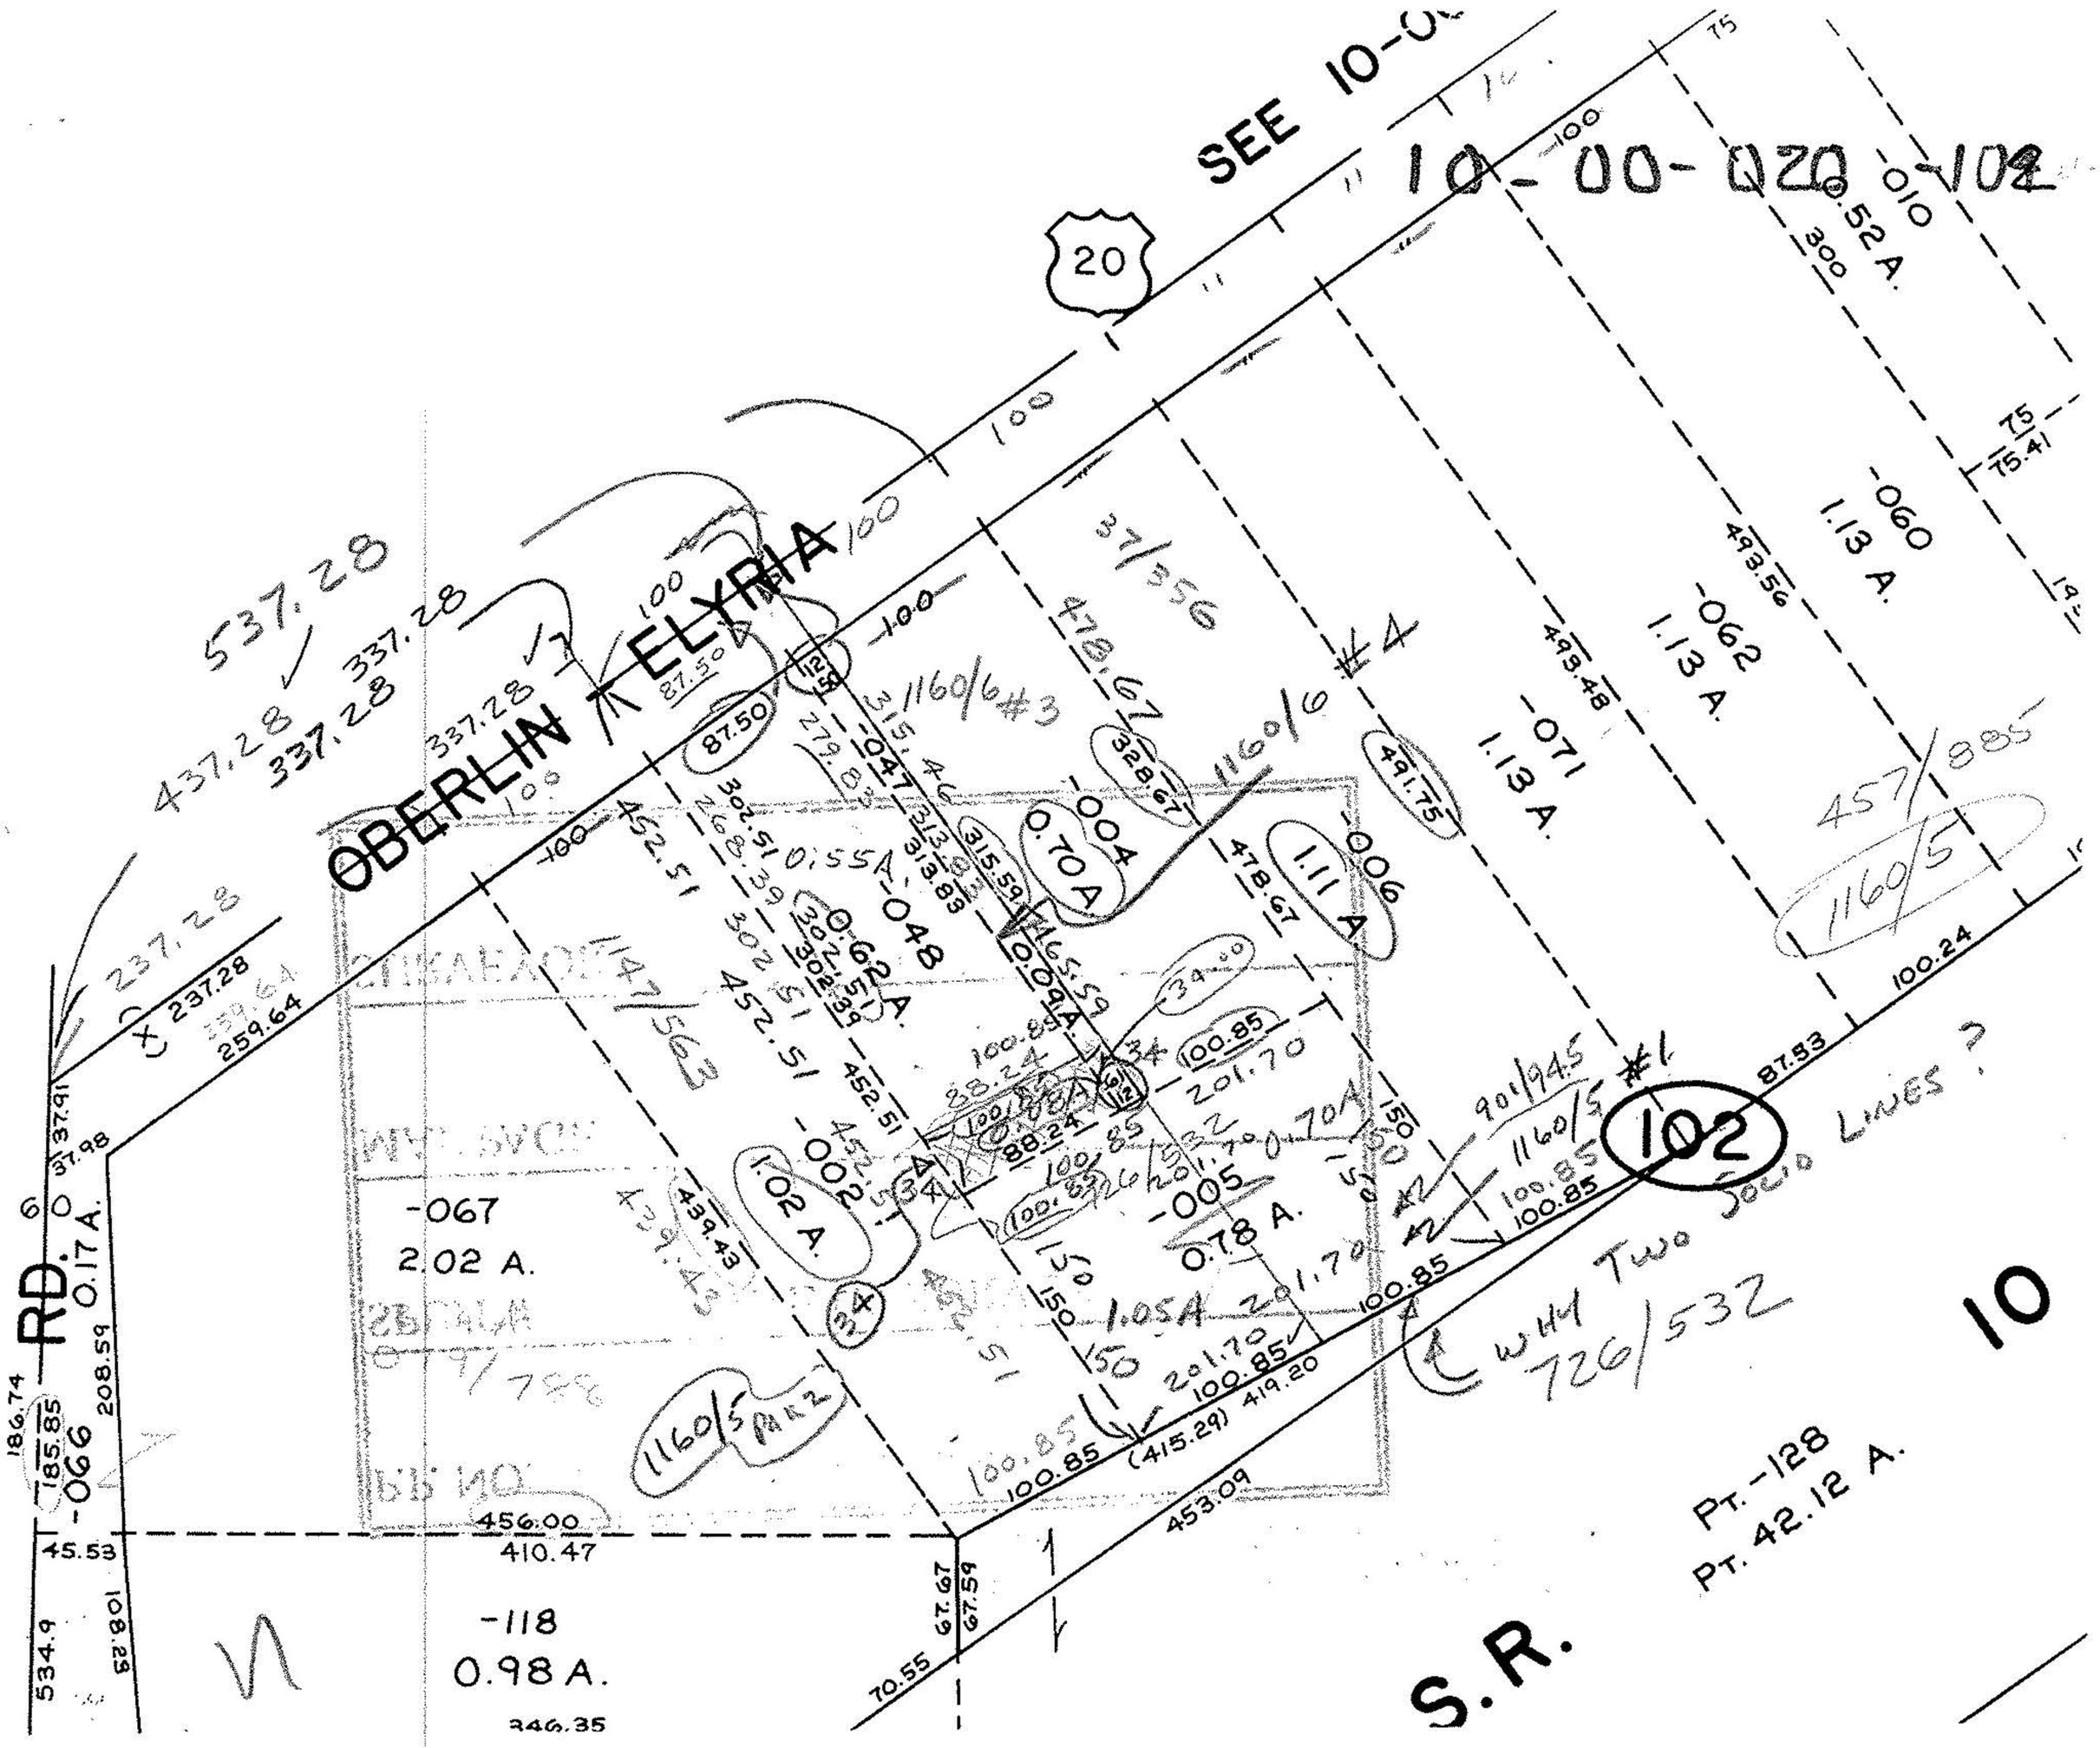

SEE 10-00
10-00-020-102
20
OBERLIN
ELYRIA
537.28
437.28
337.28
237.28
259.64
37.91
37.98
RD.
0.17 A.
208.59
186.74
185.85
-066
45.53
534.9
108.23
-067
2.02 A.
-118
0.98 A.
346.35
456.00
410.47
-002
1.02 A.
-004
0.70 A.
-005
0.78 A.
-006
1.11 A.
-071
1.13 A.
-062
1.13 A.
-060
1.13 A.
-010
0.52 A.
87.50
87.53
100.24
100.85
(415.29)
419.20
453.09
70.55
67.67
67.59
452.51
439.43
1160/6 #3
1160/6 #4
1160/5 #1
1160/5 PAR 2
37/356
478.67
328.67
491.75
493.48
493.56
457/885
1160/5
901/945
726/532
WHY TWO SOLID LINES?
102
10
S.R.
PT. -128
PT. 42.12 A.