P.P. NO. 10-00-022-000-033

SPLIT # | DATE OF SURVEY July 1974

MAP PAGE

SURVEYOR KSA

SURVEY OF PART OF CARLISLE TOWNSHIP SECTION 22

TOWNSHIP OF CARLISLE COUNTY OF LORAIN

STATE OF OHIO

SCALE : 1" = 100' JULY 19, 1974

PREPARED BY

KLEINOEDER-SCHMIDT & ASSOC.

REGISTERED ENGINEERS & SURVEYORS

ELYRIA OHIO

RECEIVED AUG 1 1974 LORAIN COUNTY METROPOLITAN PARK DISTRICT

Mr. John Solet requested change of frontage. Said it was not intent to loose the frontage on east side of Diagonal Rd. DLM

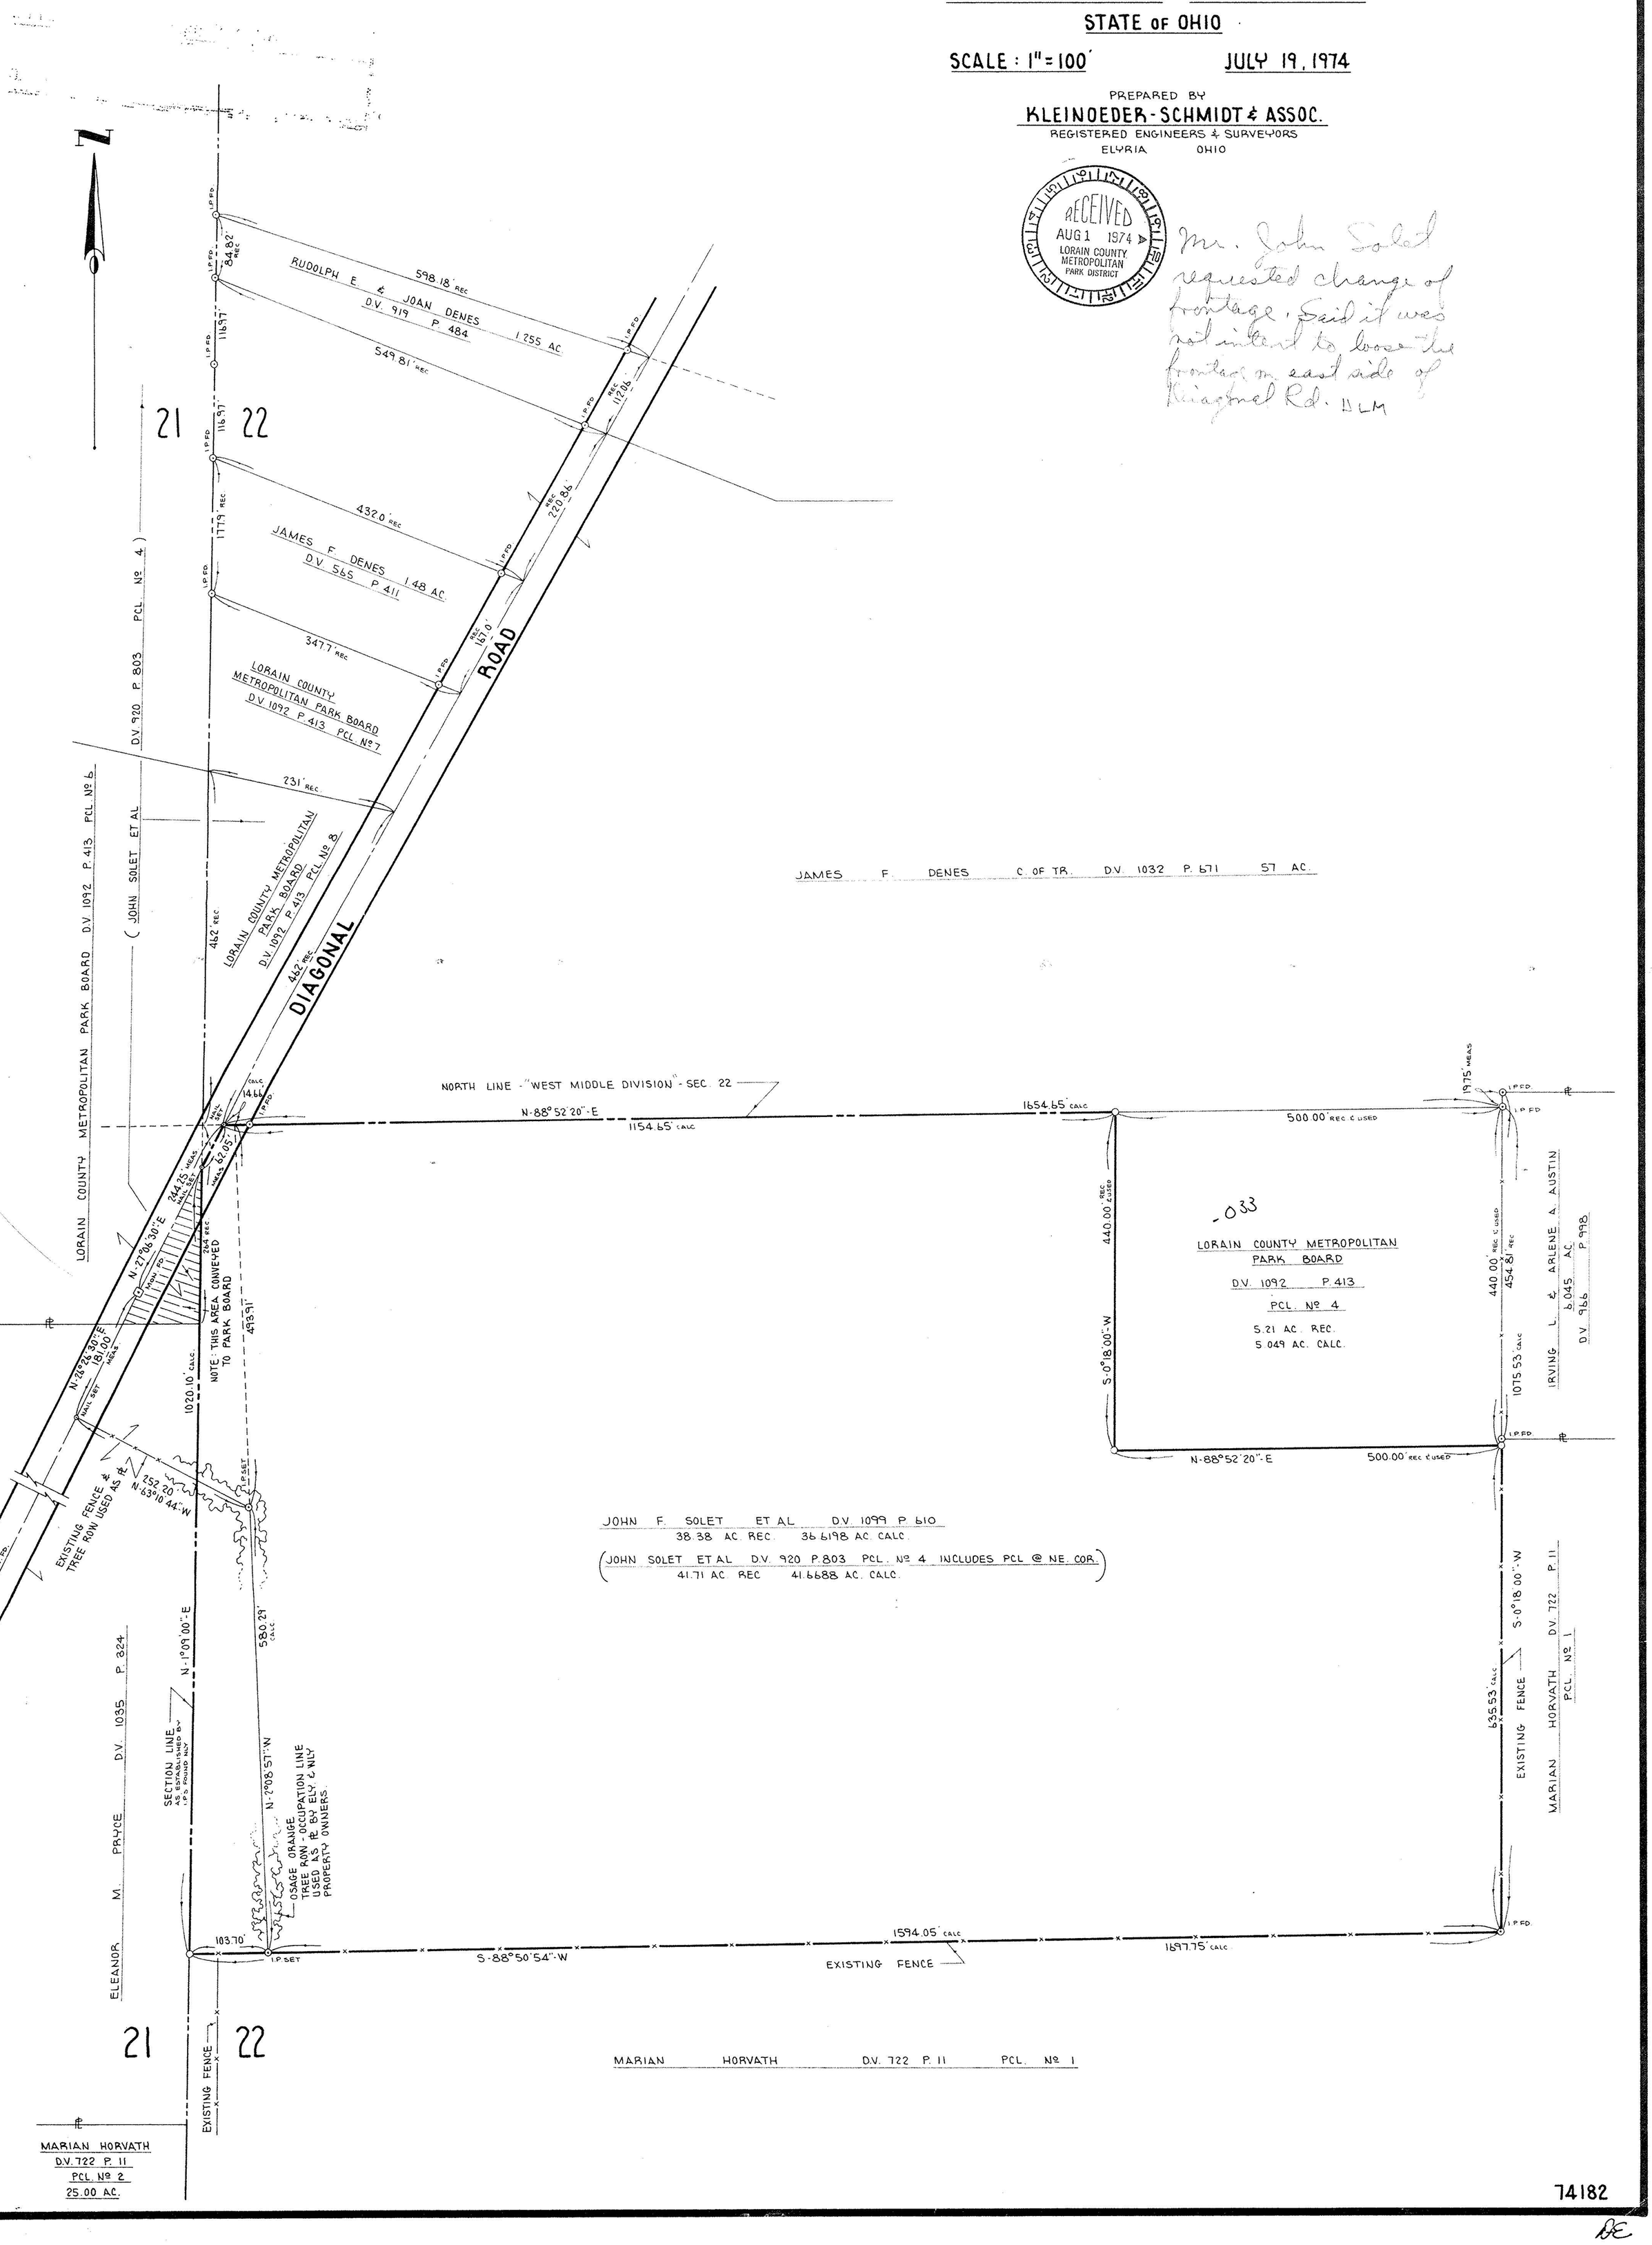

74182

90

DE

139