



No. 9613

PLOT PLAN

JOB NO. 73-55



Surveyors & Land Planners

SUBLOT PART OF SUBLOT 3

SUBDIVISION WILDWOOD ESTATES P.Y. 30 PG. 26 & 27

OTHER CARLSLE TOWNSHIP LOT NO. 6

#9613
10-00-006 A

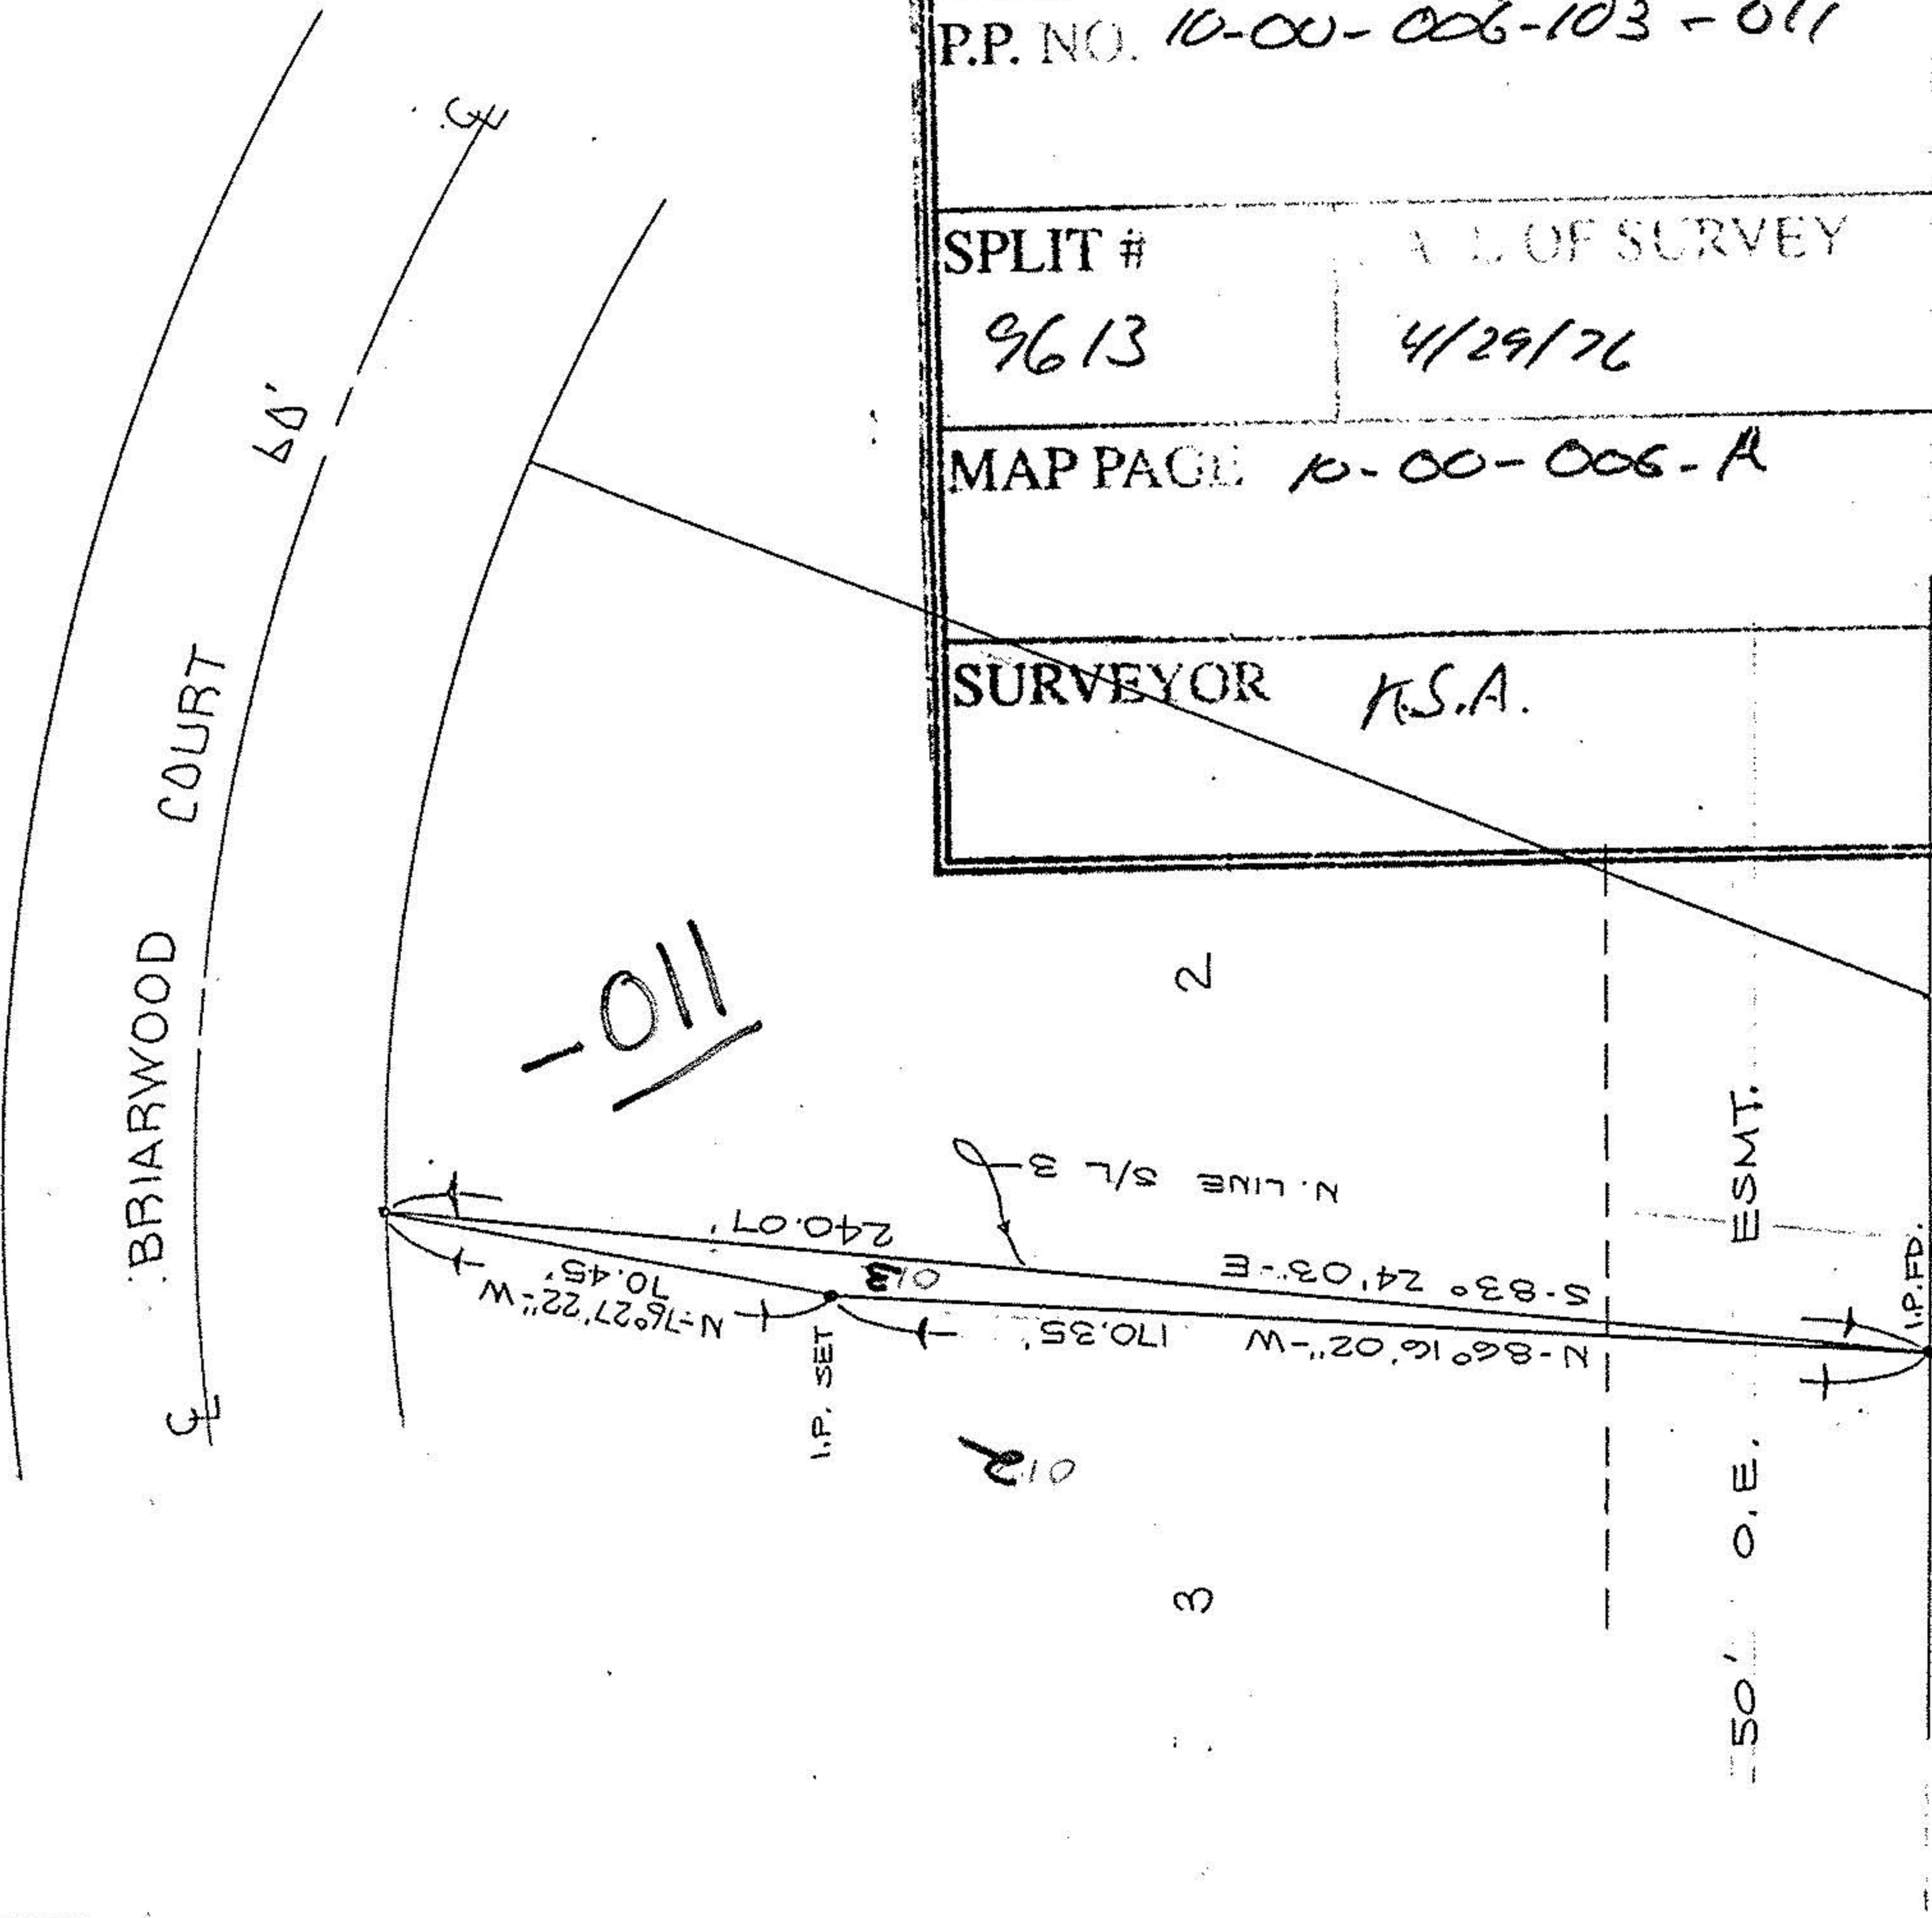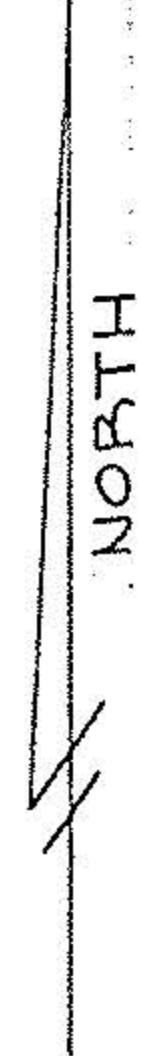

P.P. NO. 10-00-006-103-011	
SPLIT # 9613	A L OF SURVEY 4/29/76
MAP PAGE 10-00-006-A	
SURVEYOR R.S.A.	

Prepared for: RUSS GARRETSON

Scale: 1" = 40' Date: 4/29/76