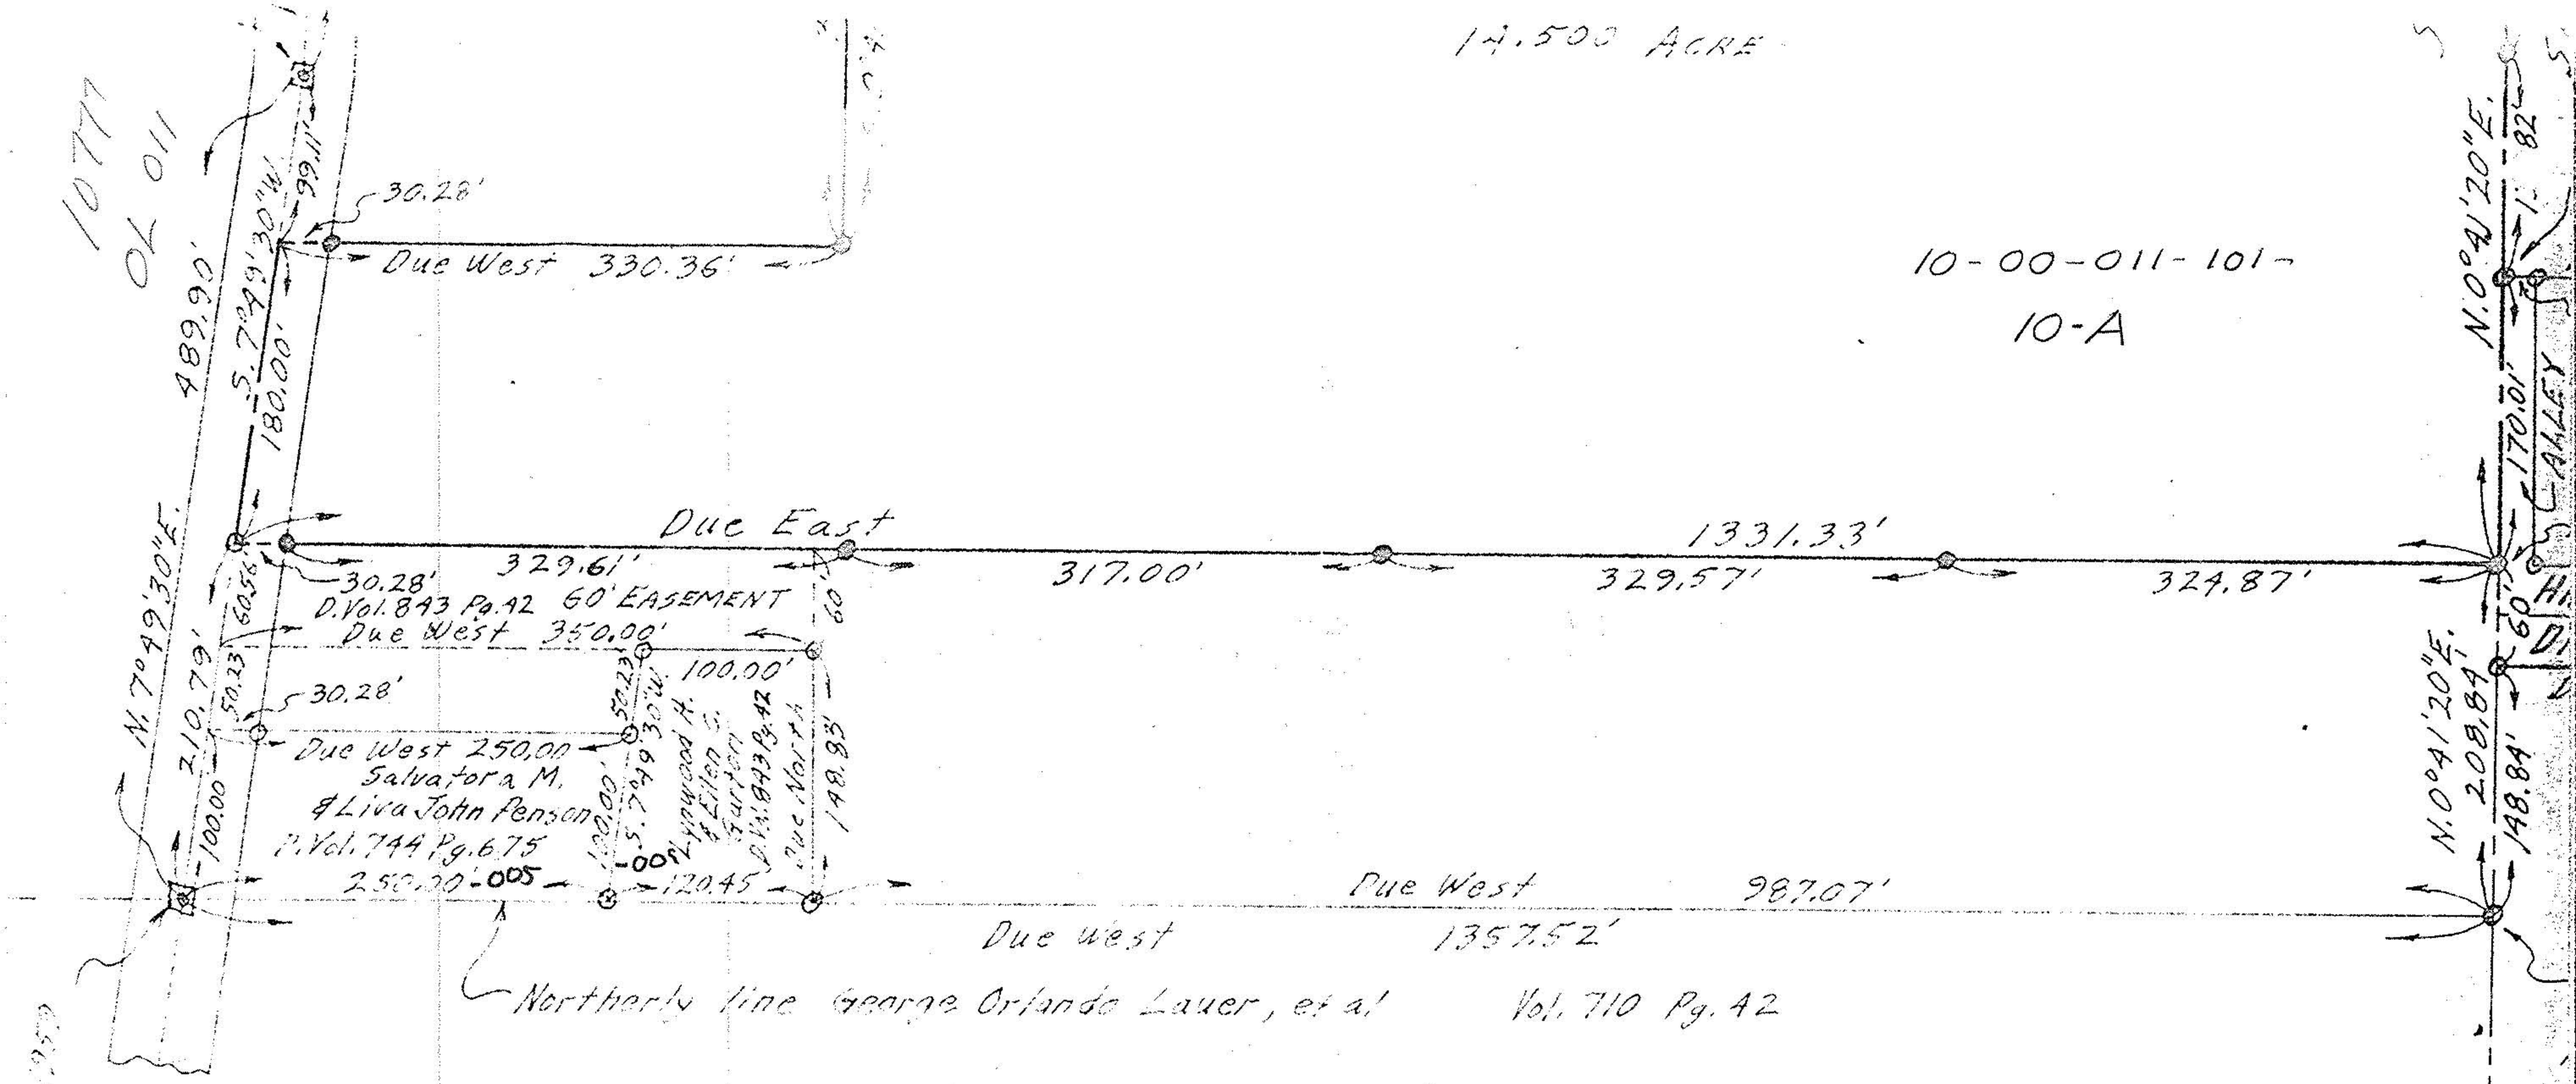

NOTES:

- ● indicates iron pin set June 1977.
- o indicates iron pin set February of 1970 or previous surveys.

PLAT OF SURVEY FOR
DOMINIC & MARY PIAZZA

SECTION NO. 11 CARLISLE TOWNSHIP
LORAIN COUNTY OHIO

SCALE: 1" = 100' JUNE - 1977

Gary E. Penfound Reg. Surveyor No. 4457