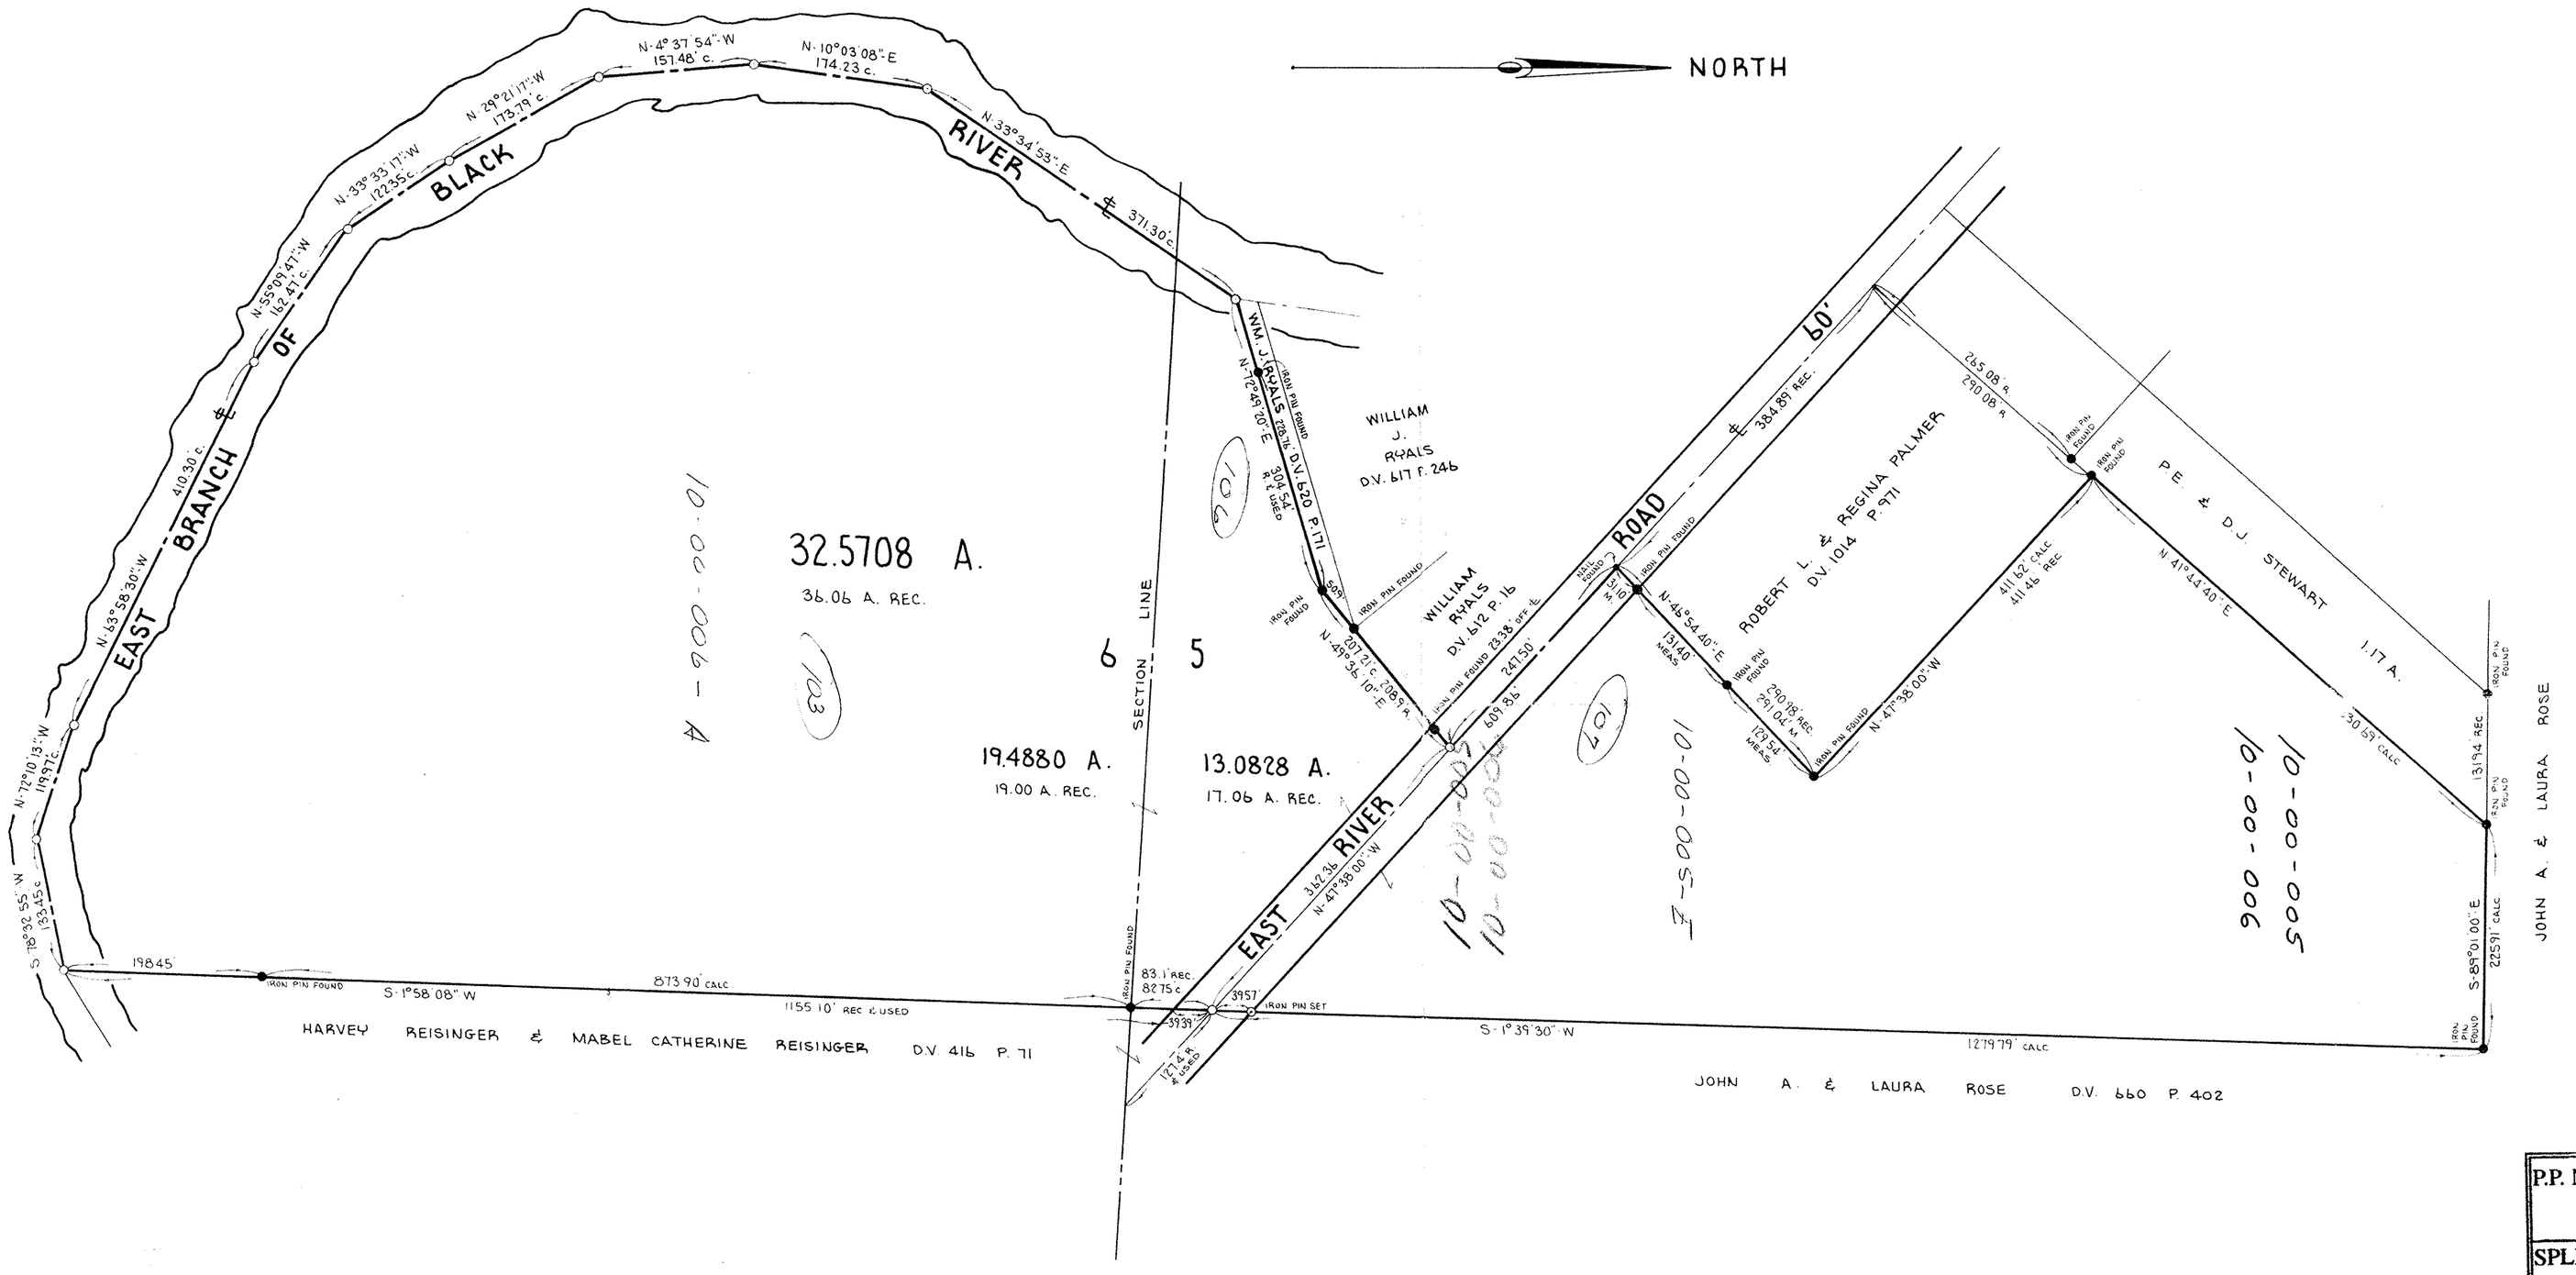

P.P. NO.	10-00-005-106 & 107 10-00-006-103-
SPLIT #	DATE OF SURVEY
MAP PAGE	10-00-005-E 10-00-006-A
SURVEYOR	WSA.

No.	Date	Description	By
		REVISIONS	

PROJECT

BOUNDARY SURVEY OF PALMER PROPERTY

PART OF CARLISLE TOWNSHIP SECTIONS NUMBERS 5 AND 6

TOWNSHIP OF CARLISLE
COUNTY OF LORAIN
STATE OF OHIO

PREPARED FOR:

WILLIAM RYALS

ELYRIA OHIO

Drawn by:	DE.
Checked by:	
App. by:	
Scale:	1" = 100'
Date:	MAY 1974

SCHMIDT and Associates
Elyria, Ohio
Norwalk, Ohio
SURVEYORS and CONSULTANTS in LAND PLANNING

REFERENCES

SHEET NO. 1 of 1

JOB NO. 7355