

09-00-023 A

09-00-023-000
107

Map of Survey Part of O.L. 23 Russia Twp. Lorain Co. Ohio
Scale 1" = 100' Sept. 10, 1977 By Arnold F. Koepf Registered Surveyor No. 4306



RECENTLY SPLIT OFF TO
Dennis Pray Vern. Pray Vol. 1186-242

S. Corp S. Amherst Village Sept 10-1977

PROPOSED SPLIT

CAUTION

027

09-00-023A
11084


029

30



035

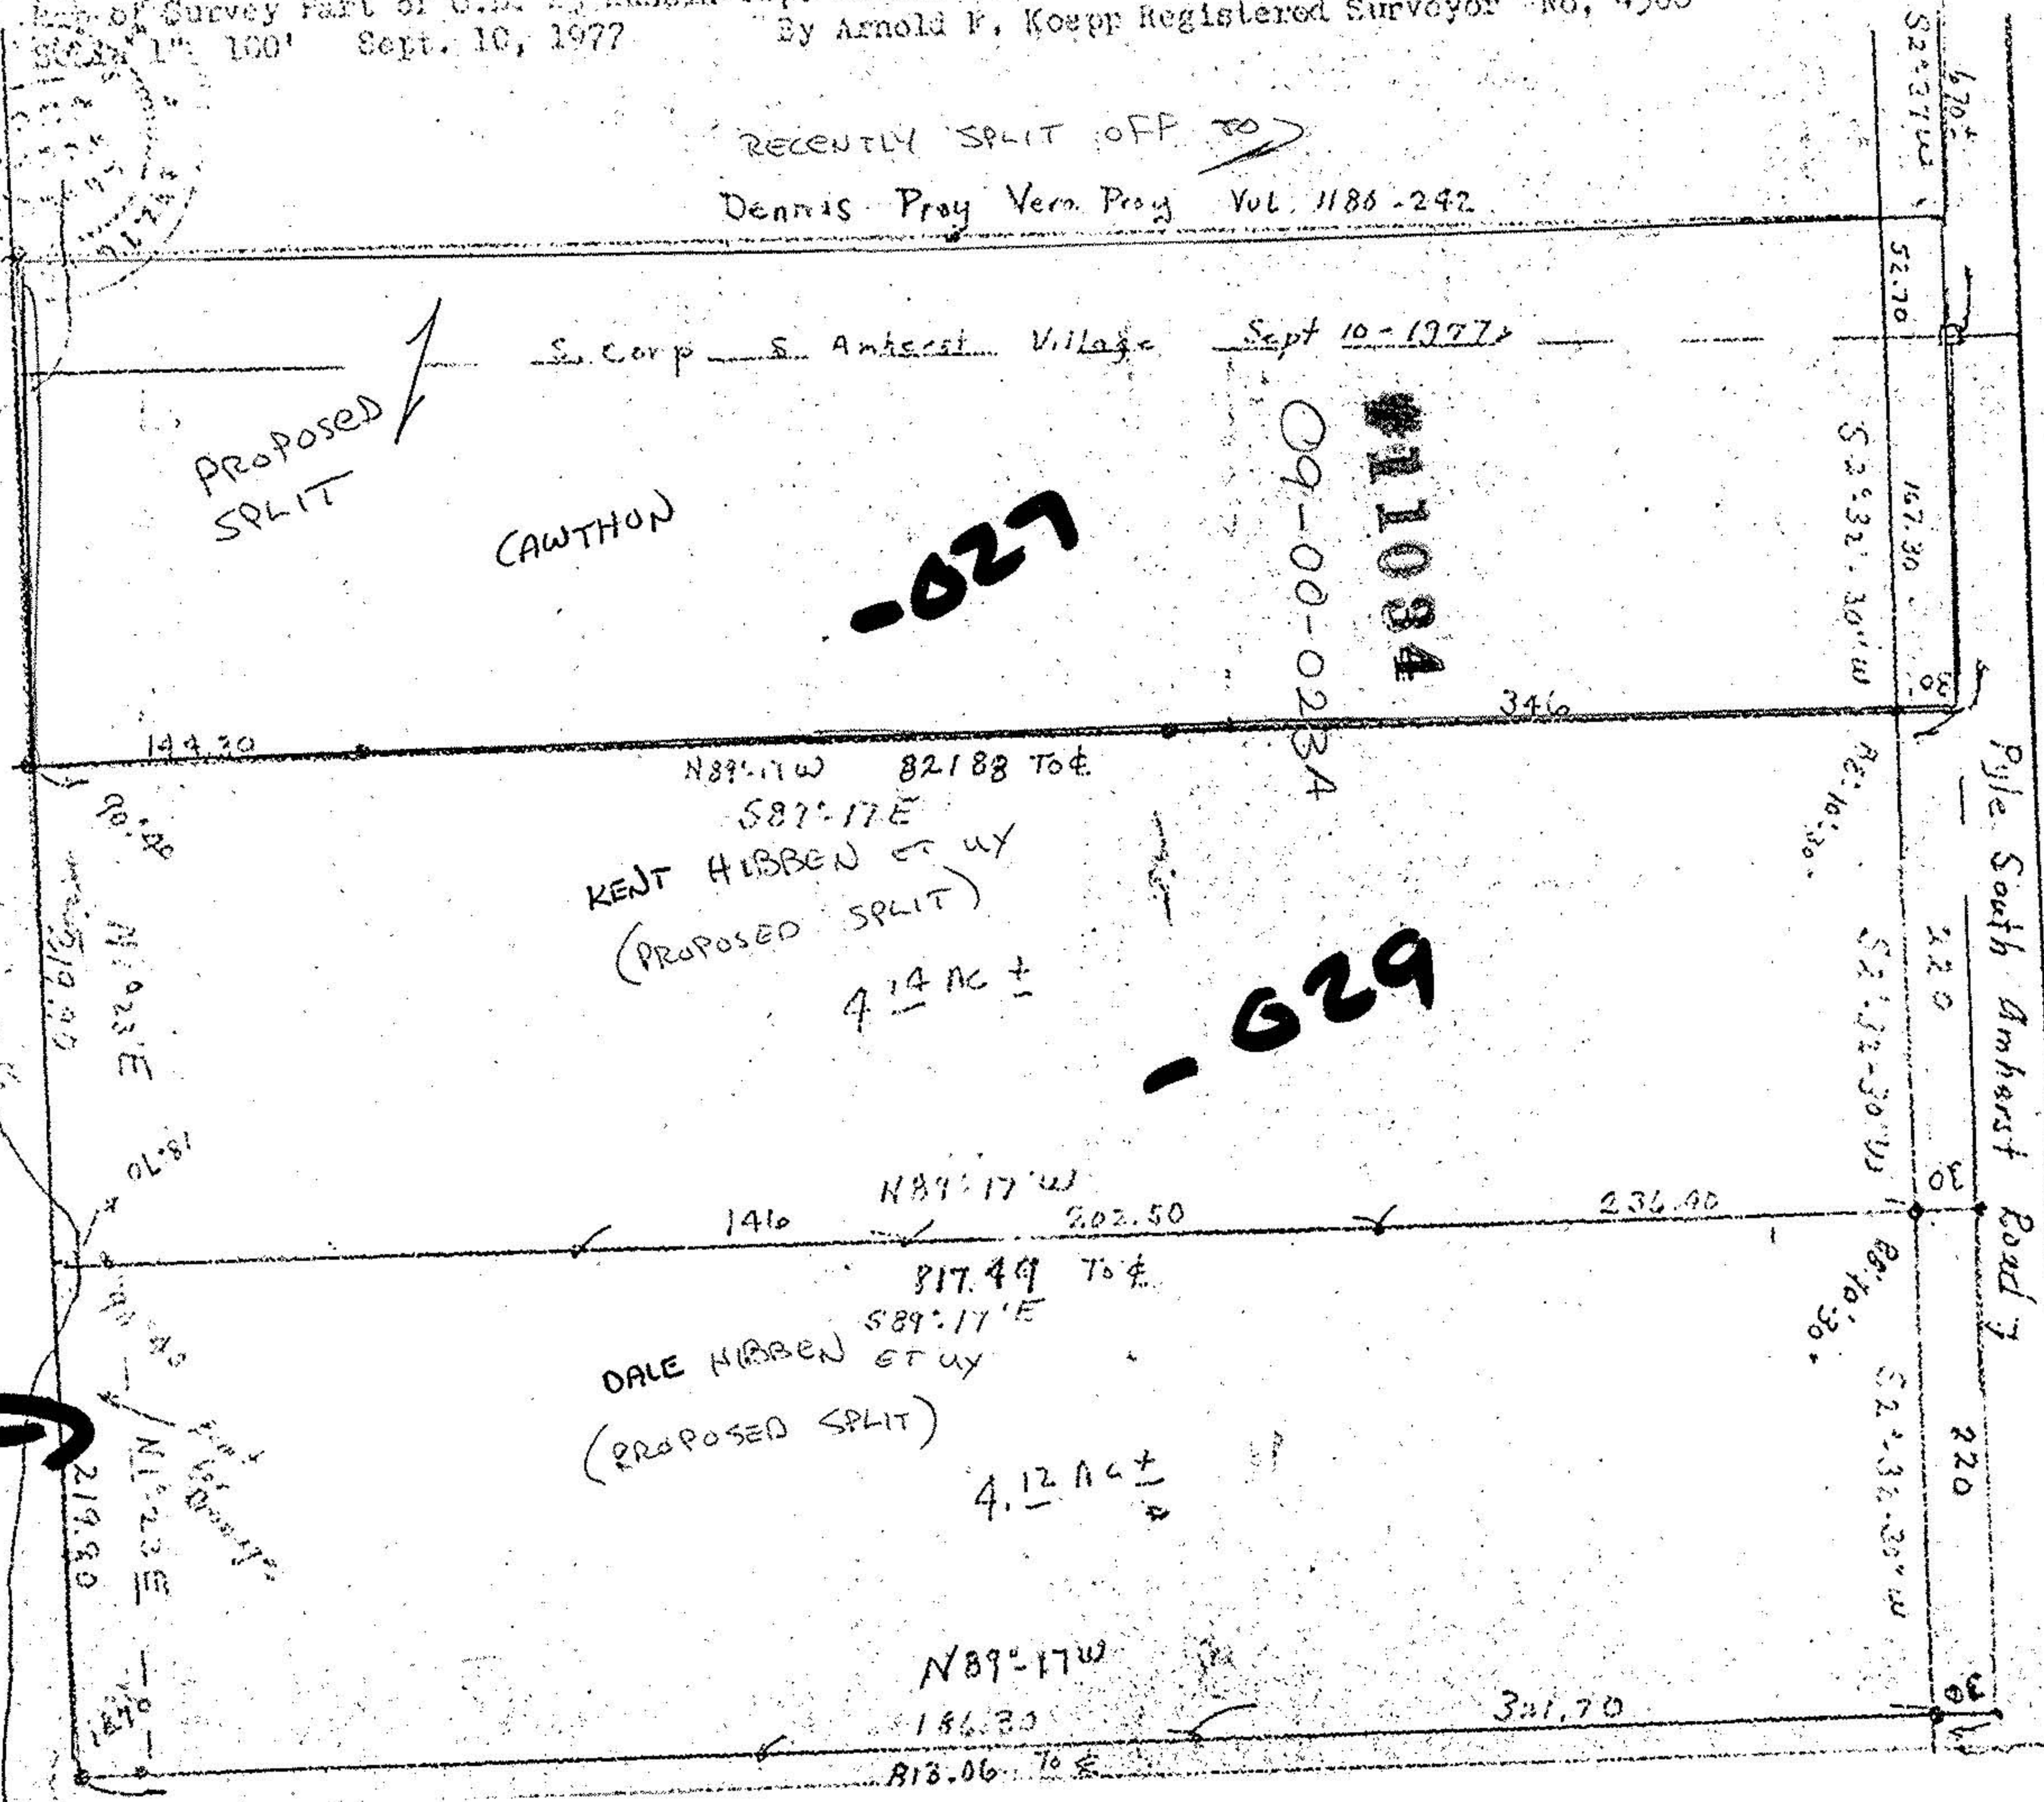

144.30

N89°17'W 821.88 To E

S87°17'E

KENT HIBBEN et ux
(PROPOSED SPLIT)
4.14 AC ±

346

N10°23'E

18.70

146

N89°17'W

202.50

DALE HIBBEN et ux
(PROPOSED SPLIT)
4.12 AC ±

236.40

219.90

N1°23'E

N89°17'W

186.30

S87°17'E 813.06 To E

341.70

S2°31'W

52.70

S2°32'30" W

157.30

N2°10'30"

S2°32'30" W

S2°10'30"

S2°32'30" W

Pyle South Amherst Road

220

30

220

30