9-00-003-B

Scale 1" 150' June 27, 1977
By Arnold F. Koepp Registered Surveyor No. 4306
Lot Surveys June-9-13-78

9-00-003-B

11939

Chuliks want to be sure they are purchasing Parcel No 1

Page 9-00-003-B
Coming out of -058
25.66
3.69
21.97A R

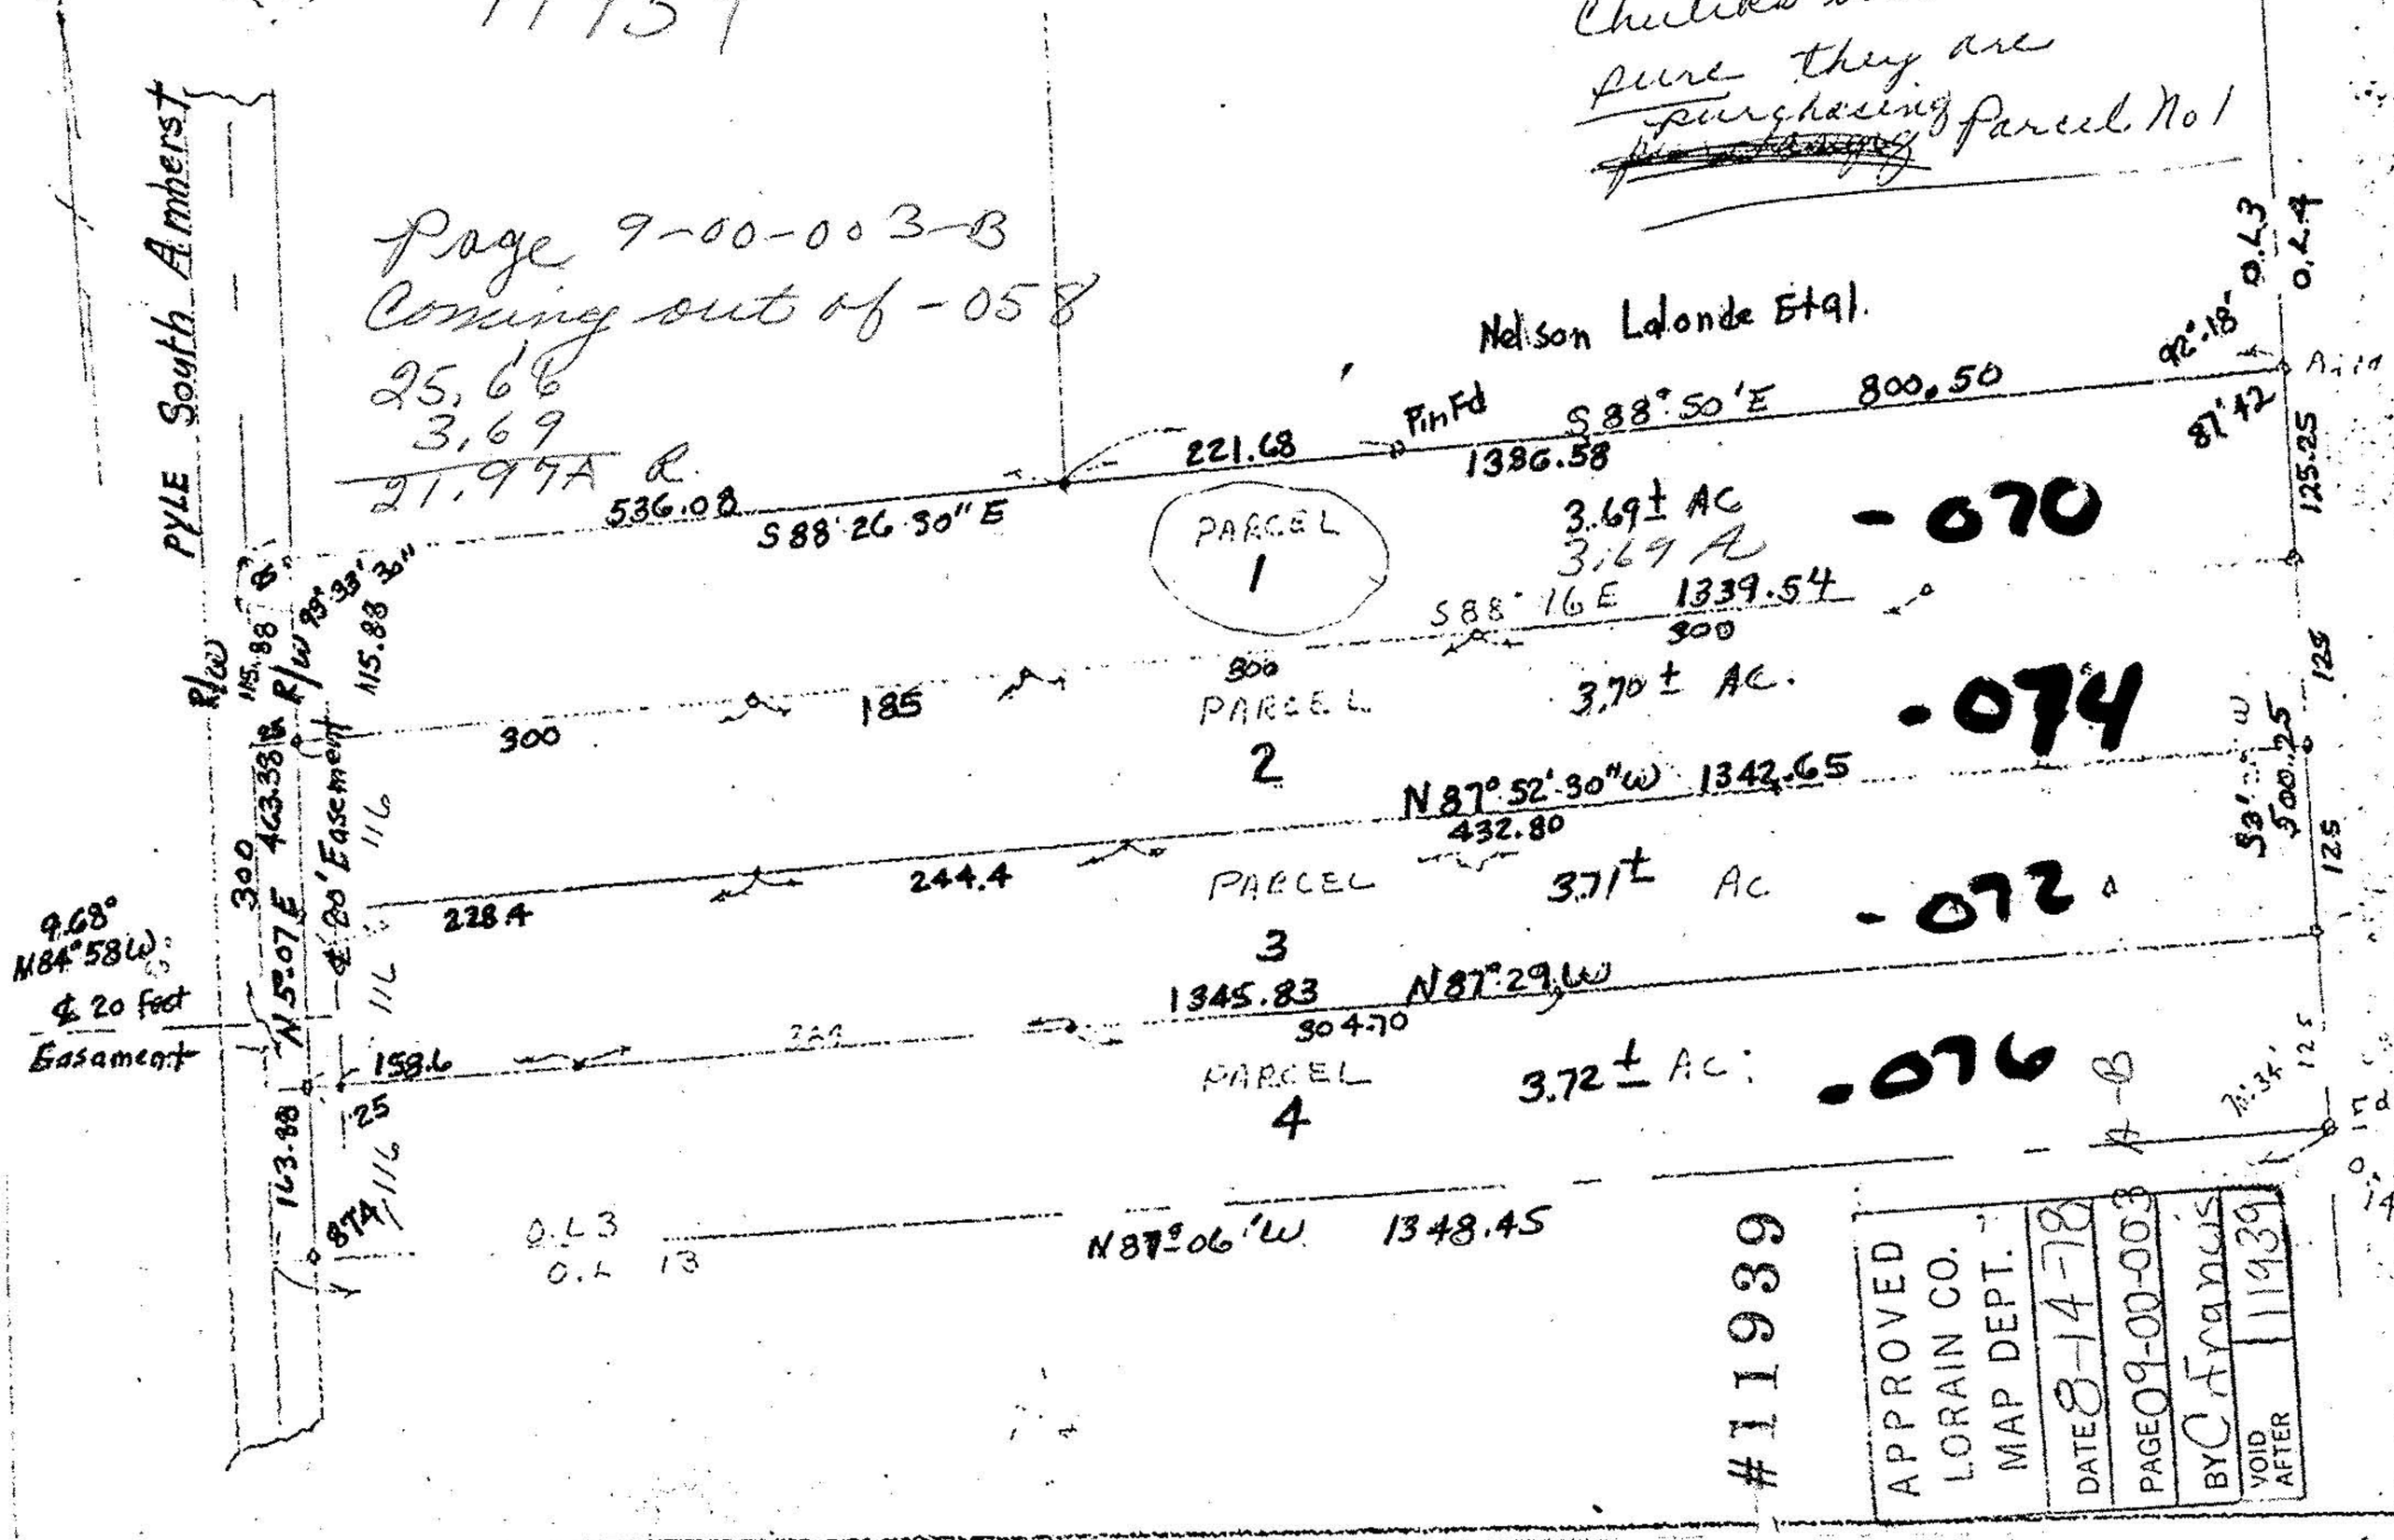

#11939

APPROVED
LORAIN CO.
MAP DEPT.
DATE 8-14-78
PAGE 09-00-003
BY C Francis
VOID AFTER 11939