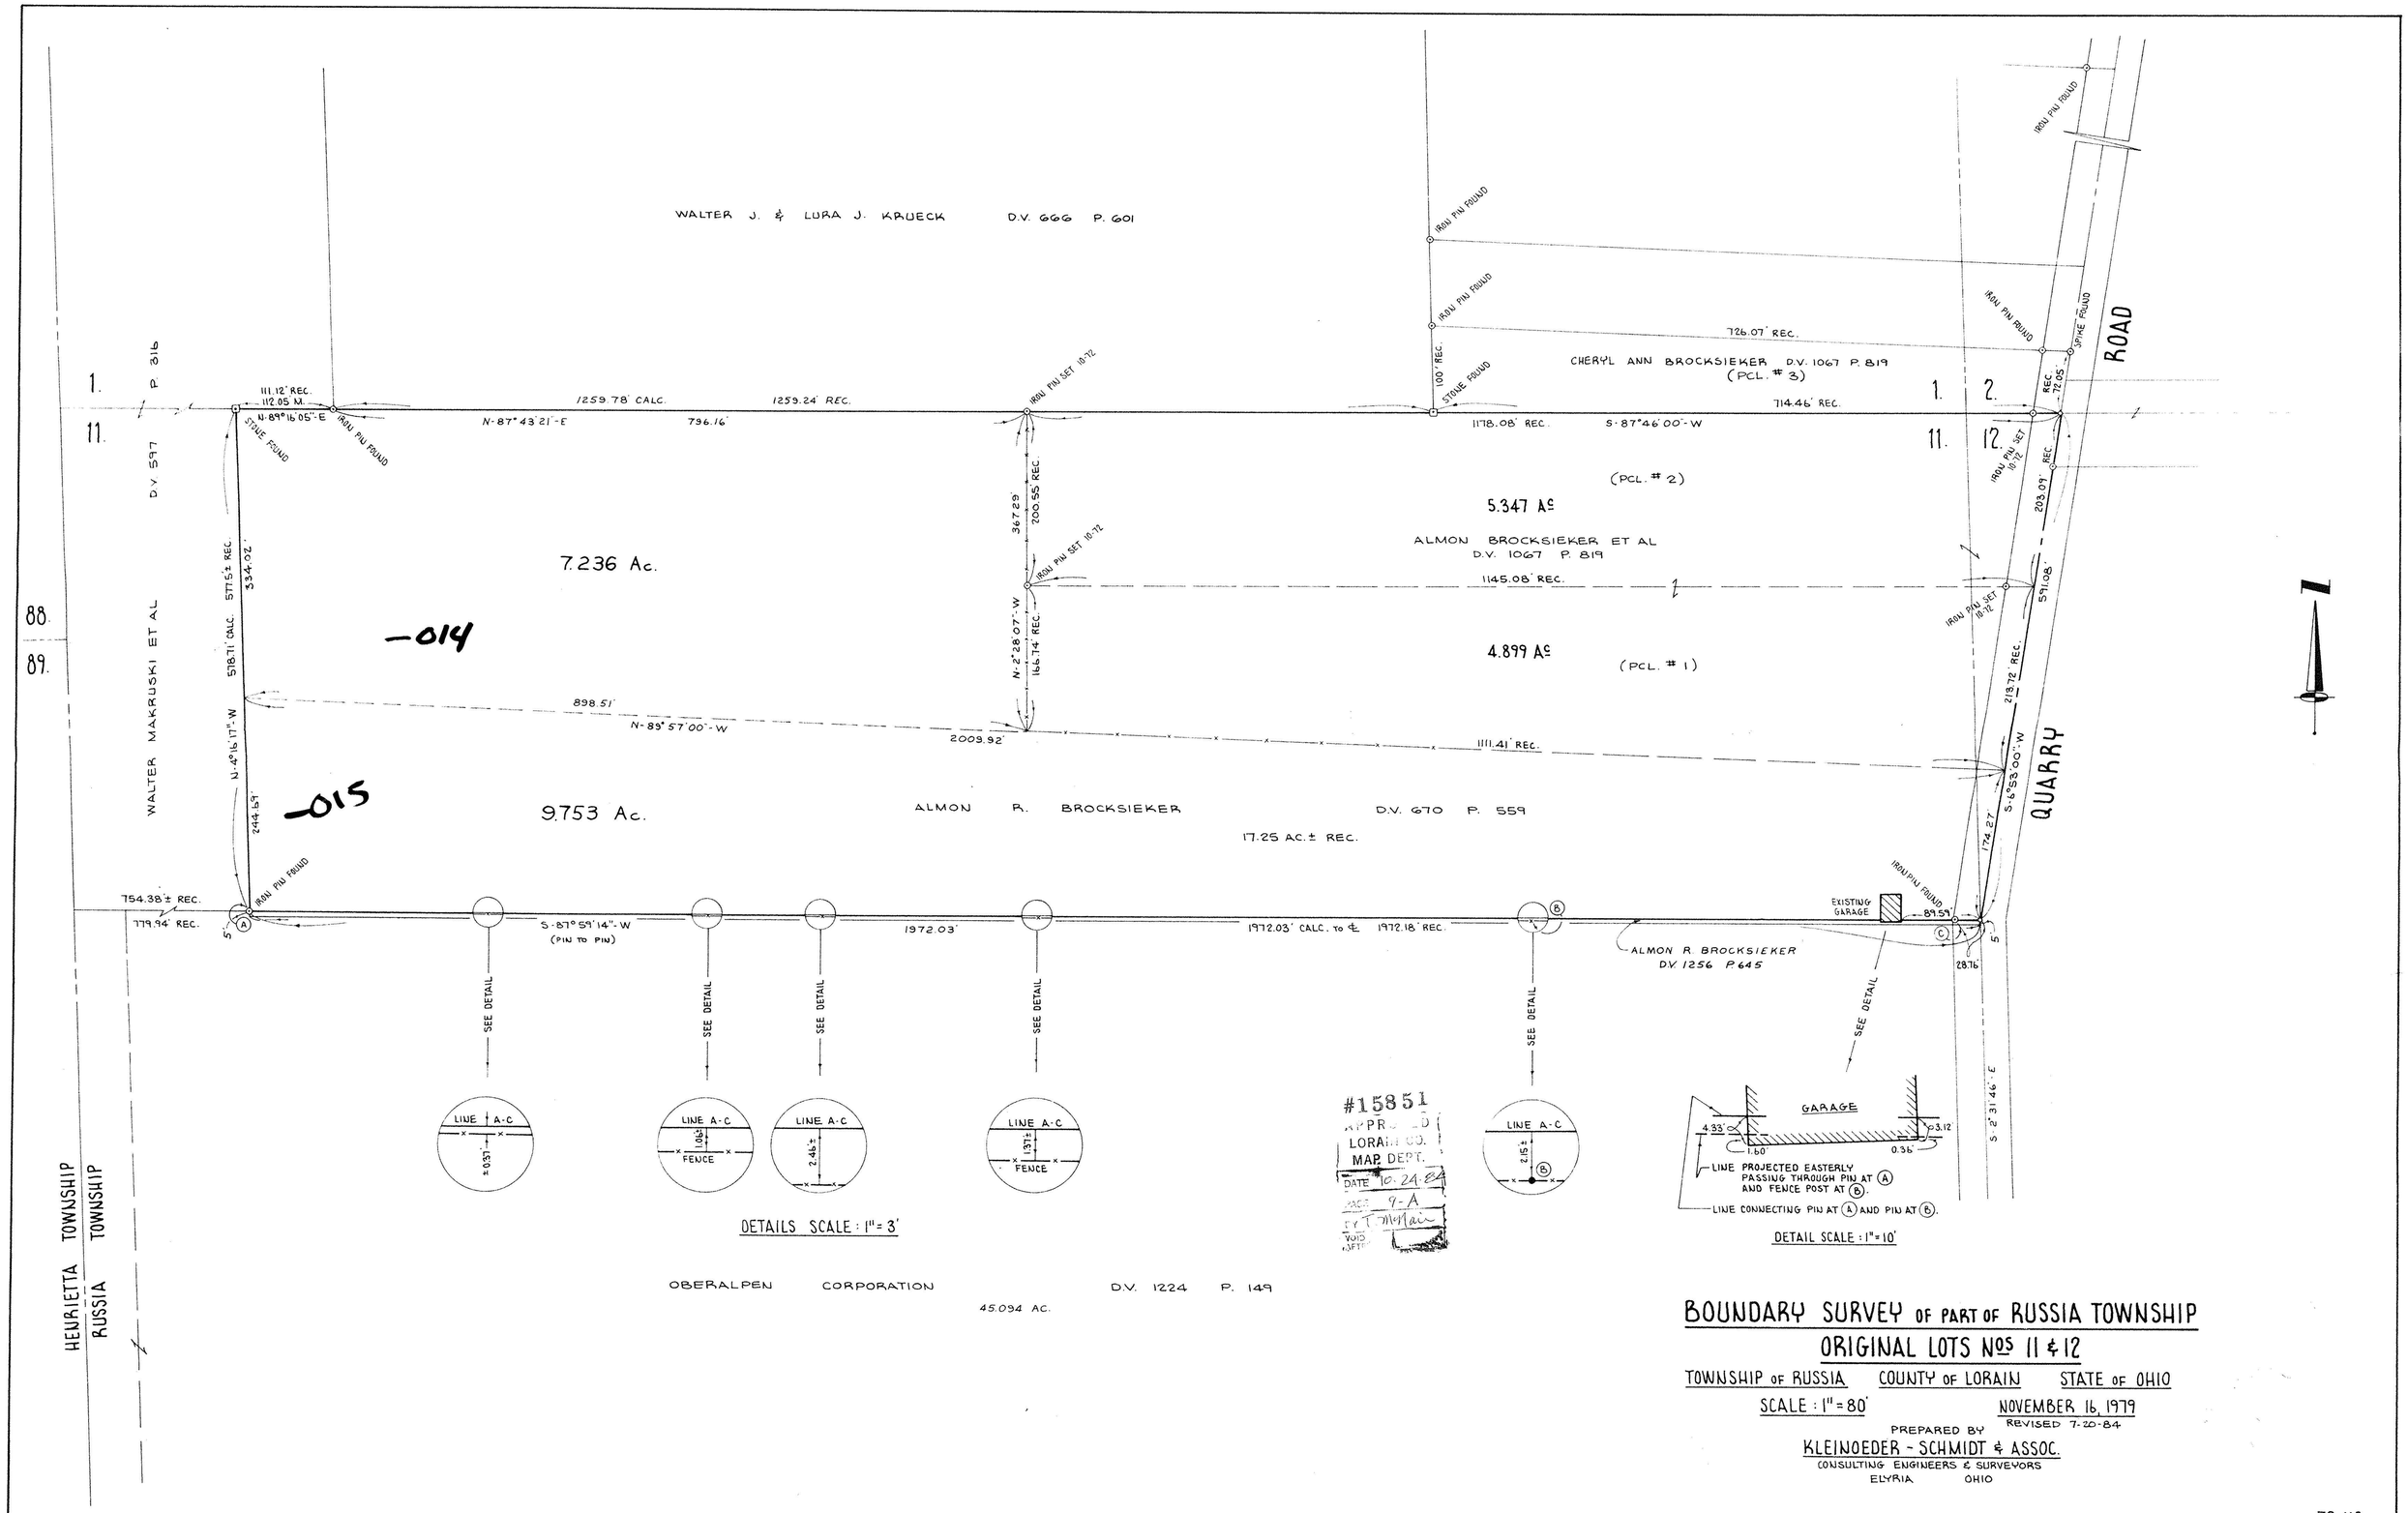

BOUNDARY SURVEY OF PART OF RUSSIA TOWNSHIP
ORIGINAL LOTS Nos 11 & 12

TOWNSHIP OF RUSSIA COUNTY OF LORAIN STATE OF OHIO

SCALE : 1" = 80' NOVEMBER 16, 1979
REVISED 7-20-84

PREPARED BY
KLEINOEDER - SCHMIDT & ASSOC.
CONSULTING ENGINEERS & SURVEYORS
ELYRIA OHIO

72-113