12-E

O.L.93

MAP OF SURVEY
FOR
THOMAS TEHOKE

Pcl. No. 2

Being part of original Columbia Township Lot No. 93 in the Township of Columbia, County of Lorain and State of Ohio

Scale 1" = 100'

April 1977

Richard Mackay

Registered Ohio Surveyor No. 4195

SLABE & MACKAY

CIVIL ENGINEERS & SURVEYORS

JUN 23 1977

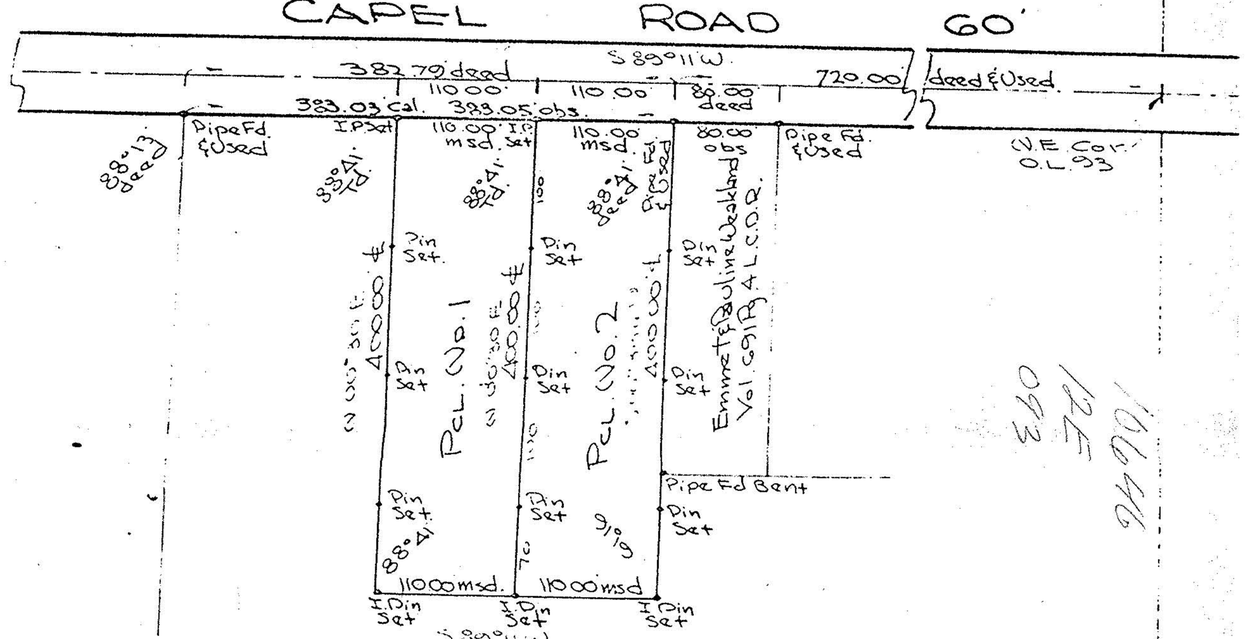

10645
12E
OL 93

12-00-093-000

12-E

O.L.93

MAP OF SURVEY
FOR
THOMAS TEHOKE

Pcl. No. 2

Being part of original Columbia Township Lot No. 93 in the Township of Columbia, County of Lorain and State of Ohio

Scale 1" = 100'

April 1977

Richard Mackay

Registered Ohio Surveyor No. 4195

SLABE & MACKAY

CIVIL ENGINEERS & SURVEYORS

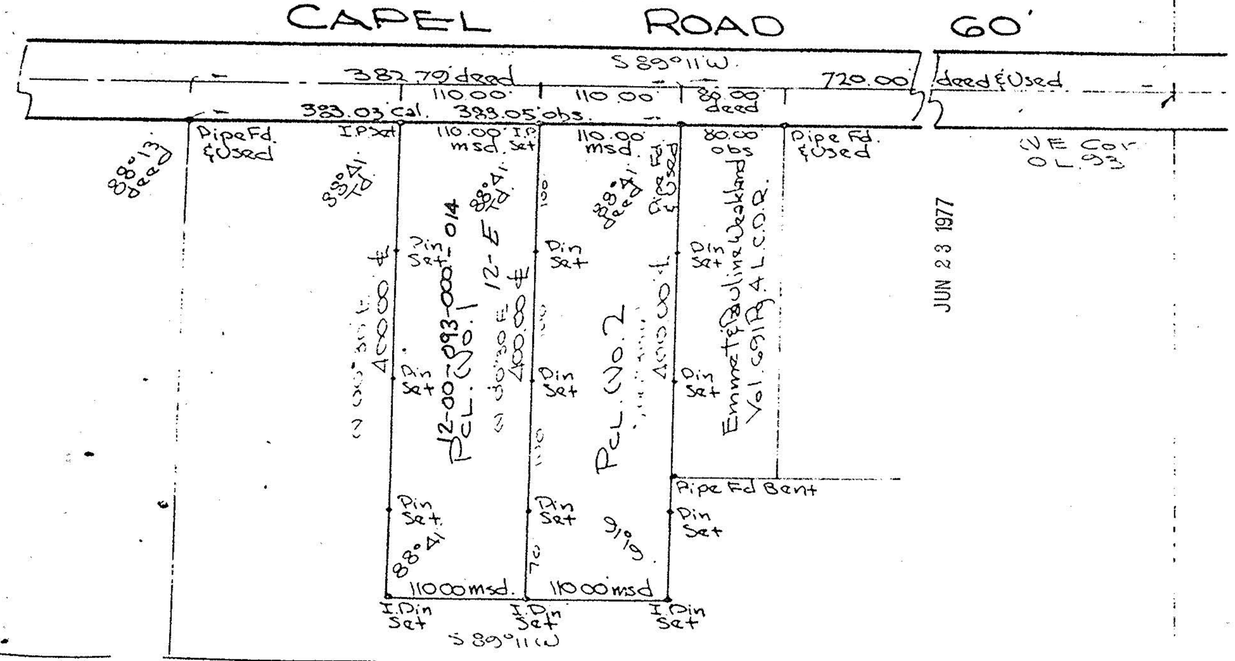

JUN 23 1977