LAUNDON . SIMON . CAHL & ASSOC. INC.
CONSULTING ENGINEERS & SURVEYORS
219 COURT ST. ELYRIA, OHIO 44035

SURVEY FOR:

PASQUALE & GILDA DIFILIPPO

Orig. Lot 62	City of	Date OCT. '88 Scale 1"=100'
Orig. Sec	Village of	Dwn. by R.G.S. Chkd. by C.J.
Tract	County of LORAIN	Job No. 88-1765 F.B.
Township of RUSSIA	State of OHIO	Printed OCT 25 1988

#18200

09-00-062-000 -009

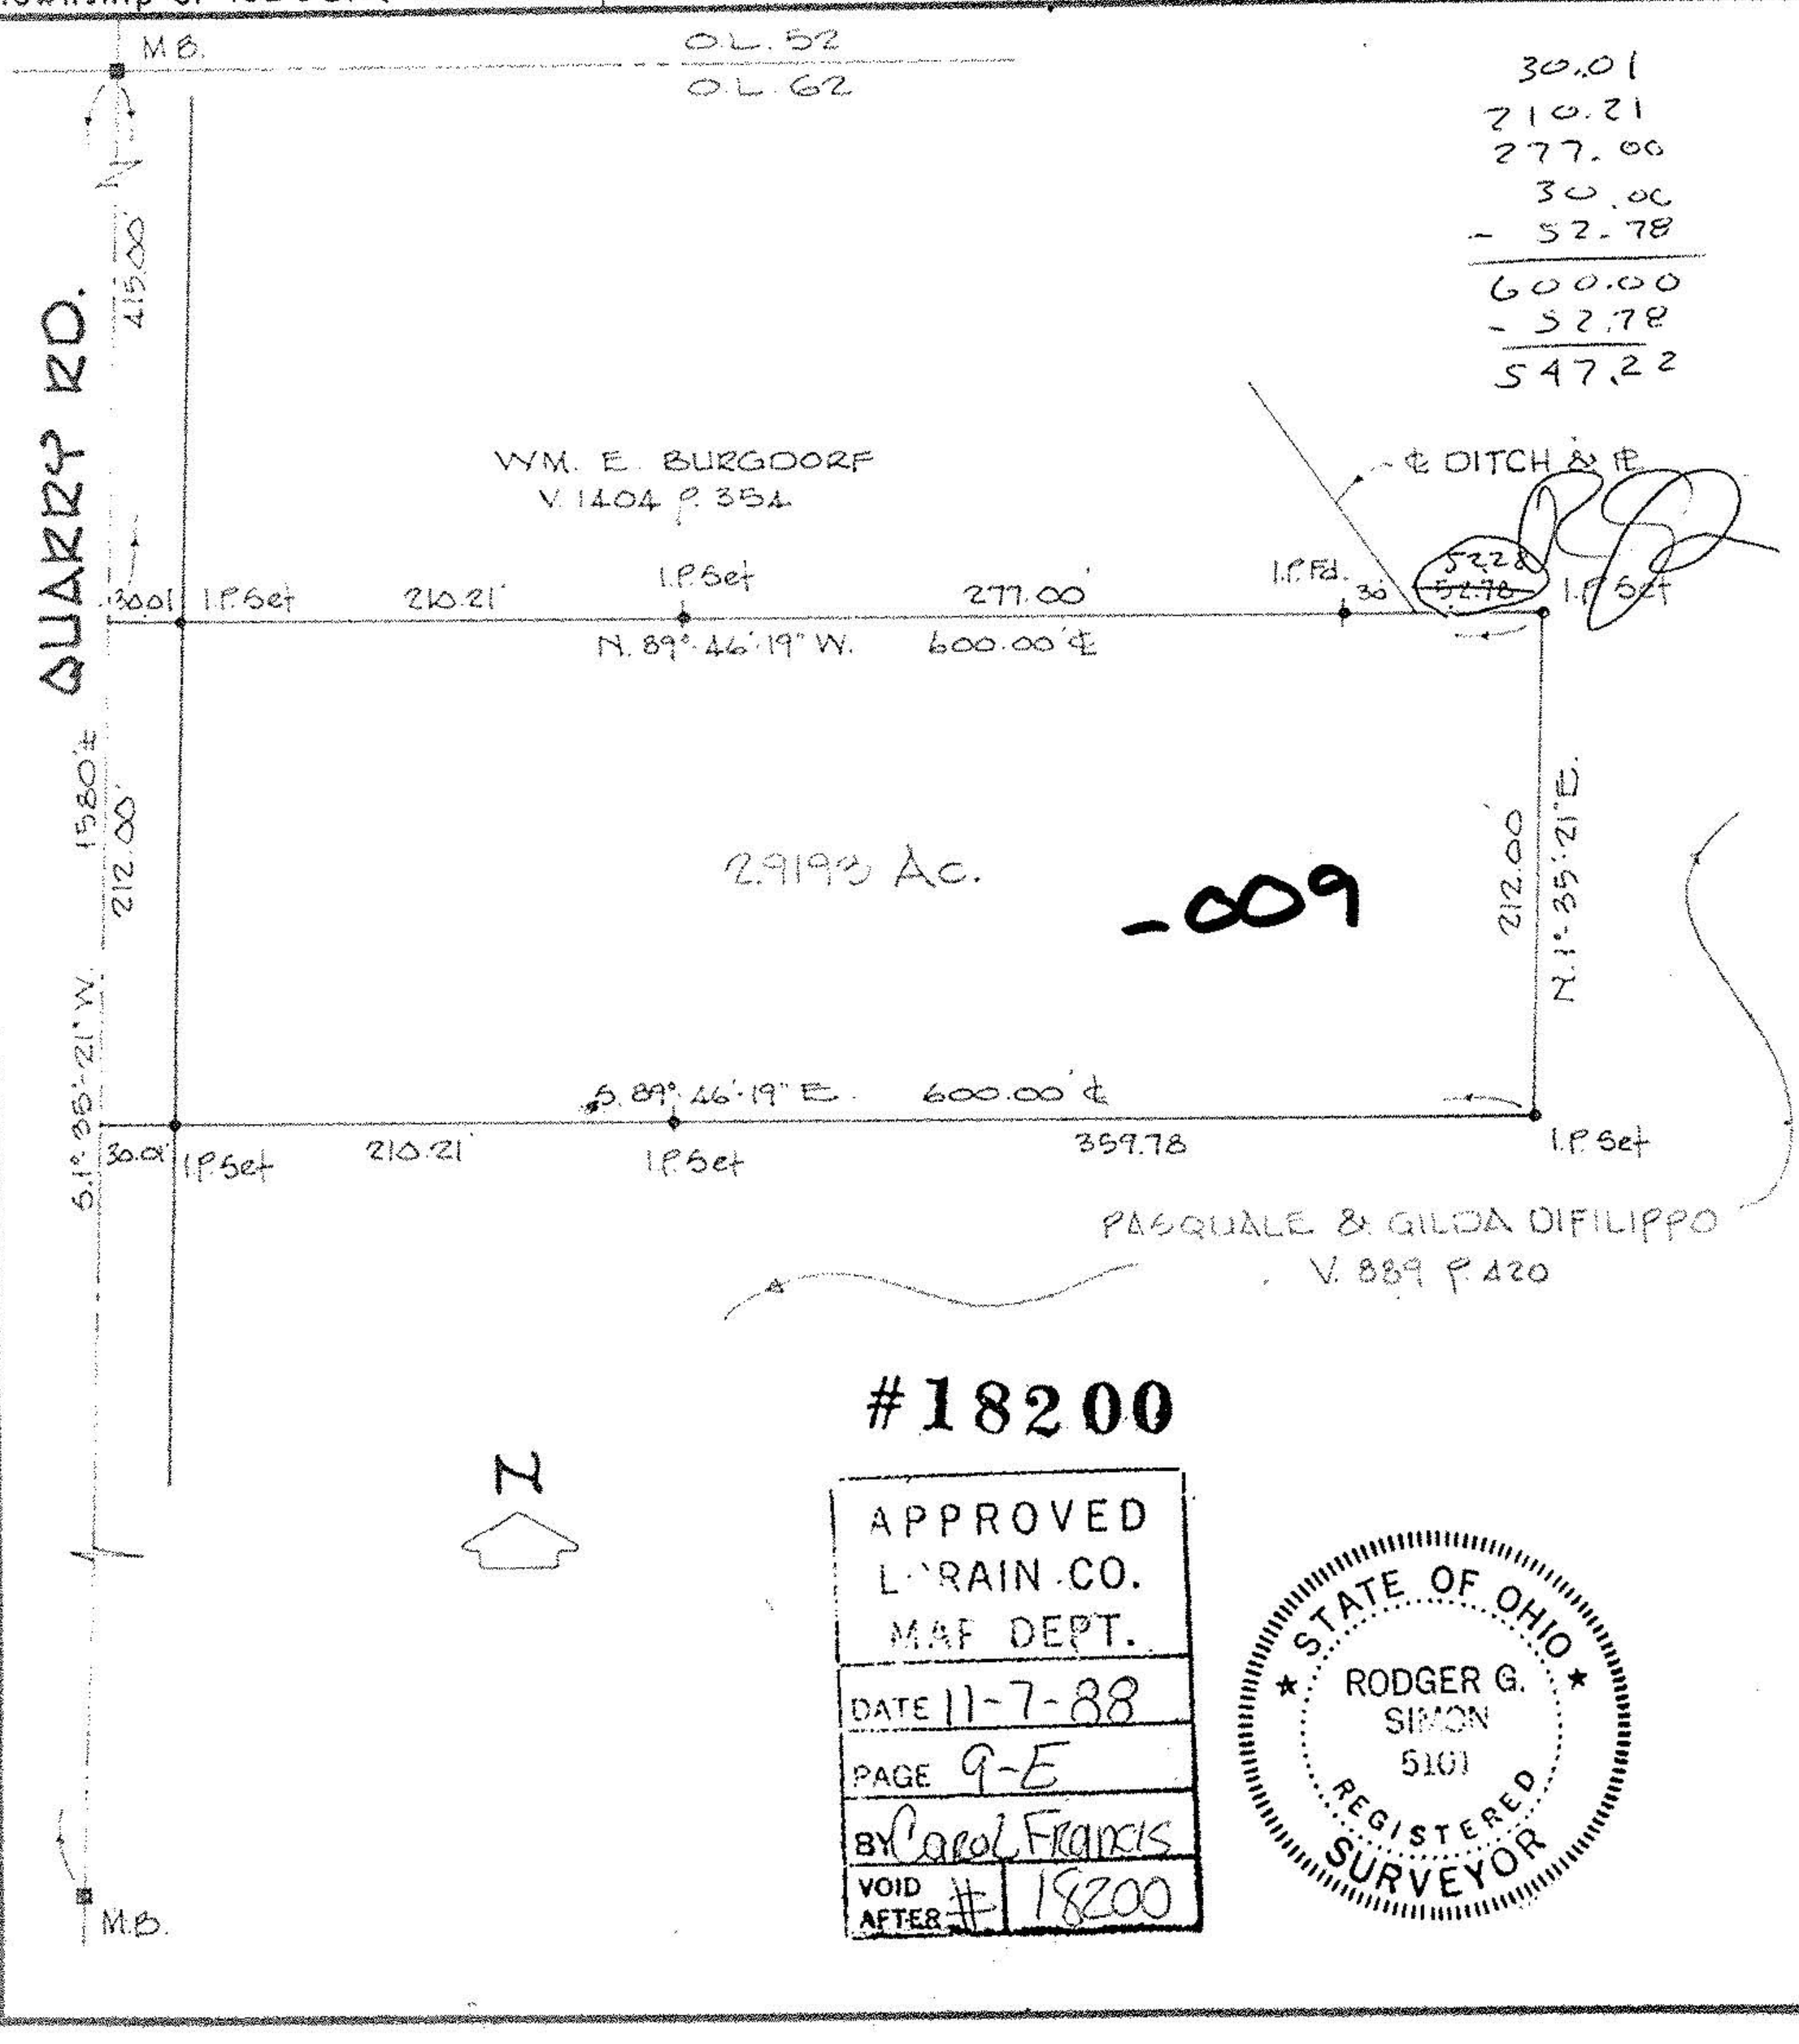

#18200

APPROVED
L'RAIN CO.
MAP DEPT.
DATE 11-7-88
PAGE 9-E
BY Carol Francis
VOID AFTER # 18200

STATE OF OHIO
RODGER G. SIMON
5101
REGISTERED SURVEYOR

9-E