

MAP OF SURVEY AND LOT SPLIT

SURVEYOR'S STATEMENT



Thomas M. Spezek 11-23-92
 REV. 2-5-93

PREPARED FOR


ROBERT L. KING

SITUATED IN THE TOWNSHIP OF RUSSIA, COUNTY OF LORAIN, STATE OF OHIO AND BEING PART OF ORIGINAL RUSSIA TOWNSHIP LOT NO. 31

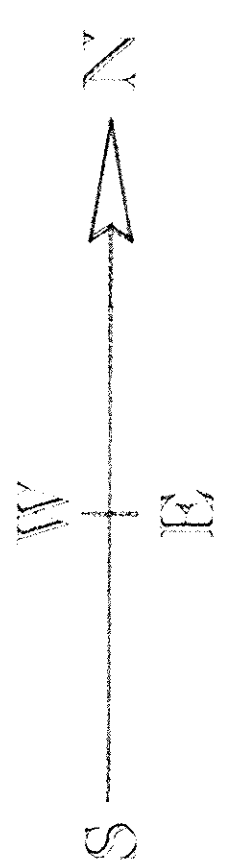

SCALE: 1" = 100'

11-23-92
 REV. 2-5-93

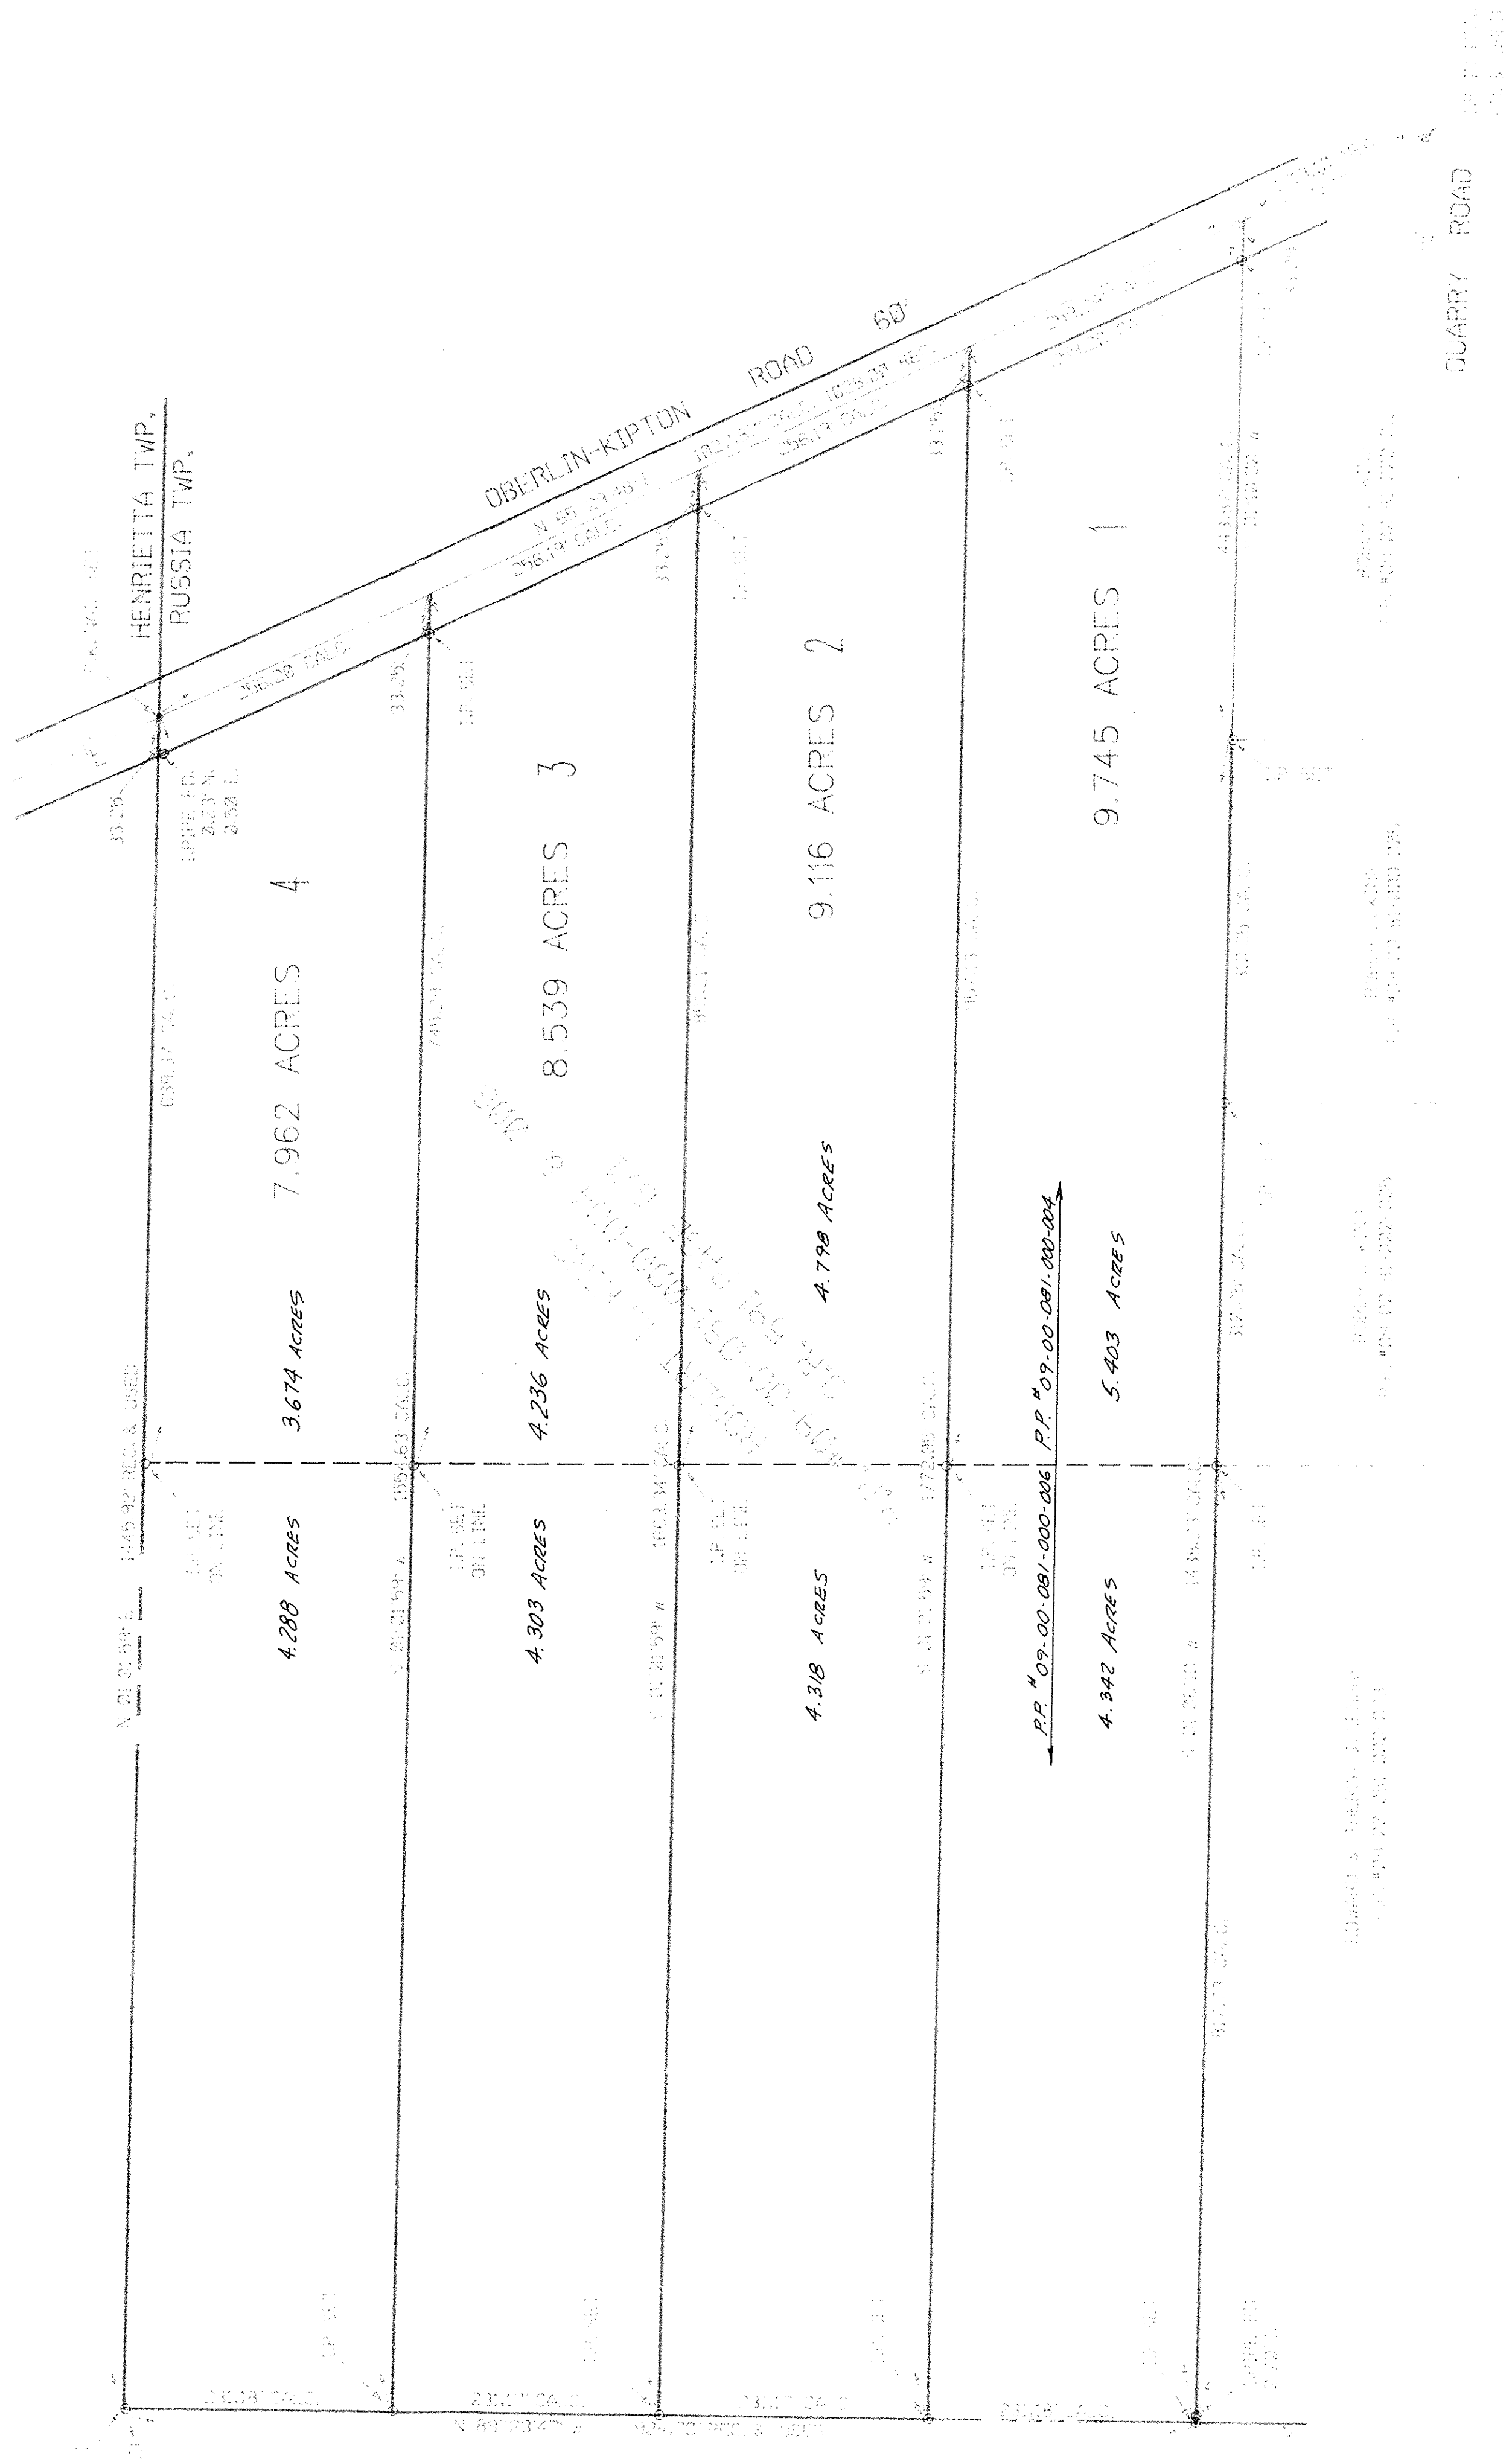

P.P. NO. 09-00-081-000-004,004	
SPLIT #	DATE OF SURVEY
20225	11-23-92
MAP PAGE	9-5
SURVEYOR Thomas M. Spezek	

20225	
APPROVED LORAIN CO. MAP DEPT.	
DATE	2-10-93
PAGE	9-5
BY	FRANCIS
VOID AFTER #	20225