MAP OF SURVEY AND LOT SPLIT

PREPARED FOR

ROBERT L. KING

SITUATED IN THE TOWNSHIP OF RUSSIA, COUNTY OF LORAIN, STATE OF OHIO
AND BEING PART OF ORIGINAL RUSSIA TOWNSHIP LOT NO. 81

S — W — E — N

SCALE : 1" = 100'

SURVEYOR'S STATEMENT

DISTANCES ARE EXPRESSED IN FEET AND DECIMALL PARTS THEREOF. BEARINGS ARE TO AN ASSUMED MERIDIAN AND ARE USED TO INDICATE ANGLES ONLY. PERMANENT MONUMENTS WERE FOUND OR SET AS INDICATED HEREON. ALL OF WHICH I DECLARE TO BE CORRECT TO THE BEST OF MY ABILITIES AND BELIEF.

Thomas M. Snezek (signature) — 11-23-92

THOMAS M. SNEZEK, R.L.S. 7051 — DATE

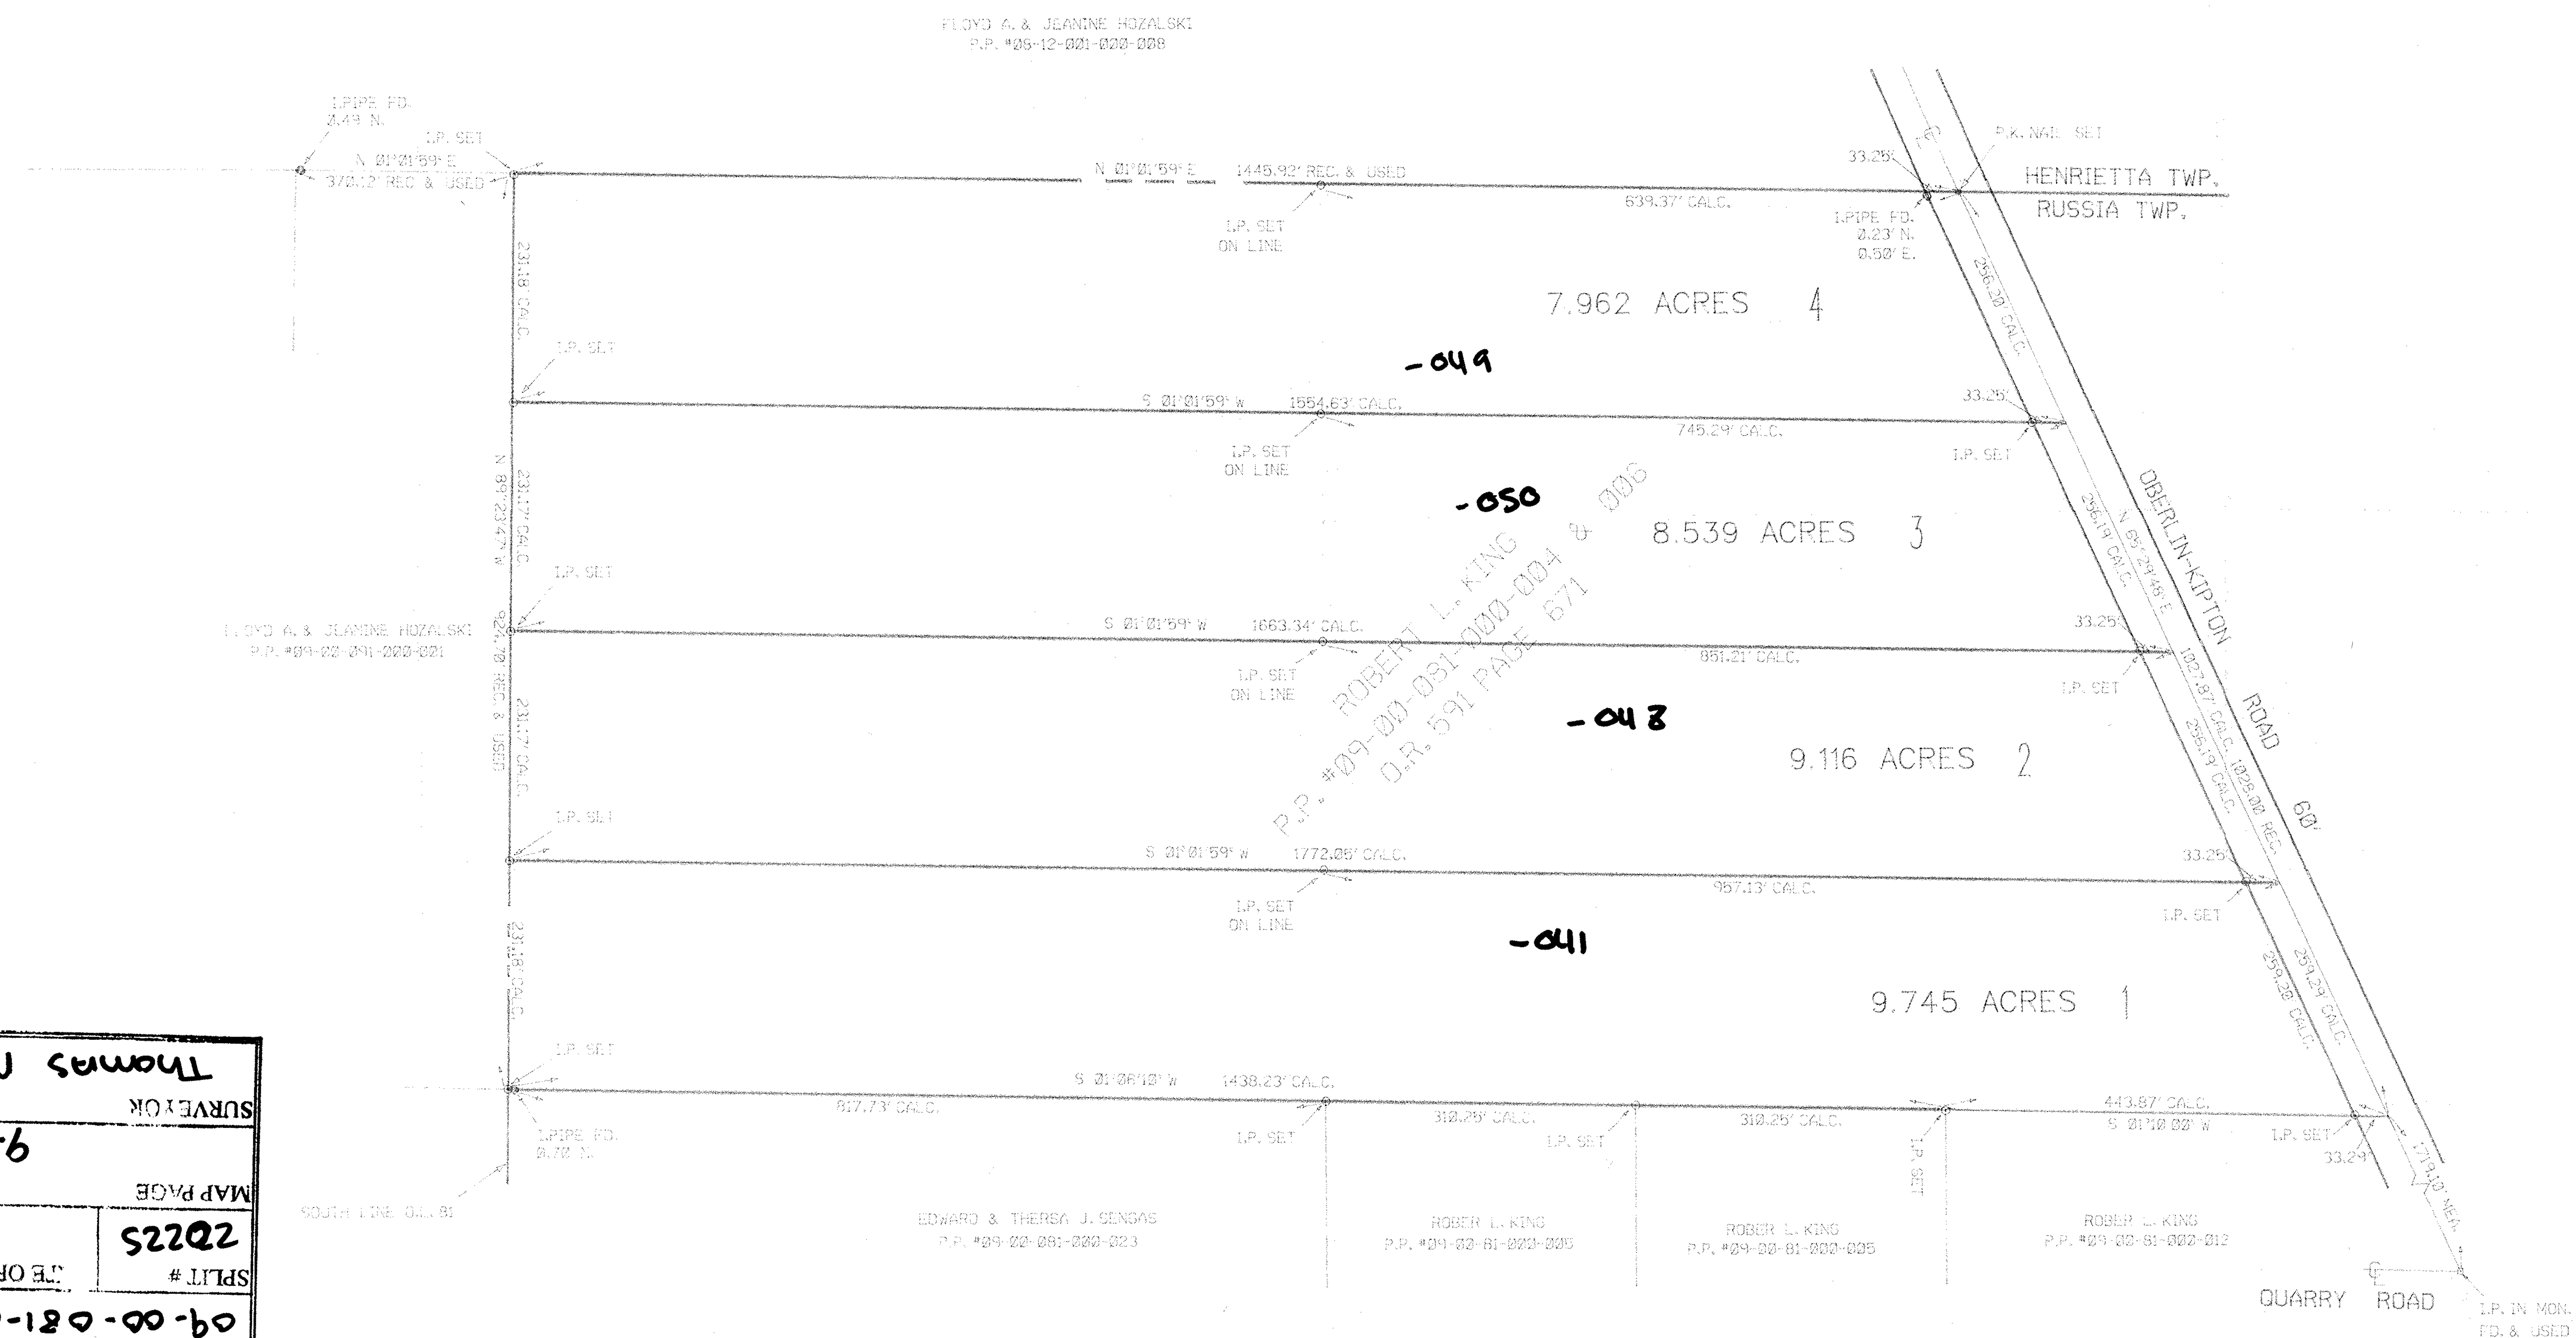

P.P. NO.	09-00-081-000-048, 041, 050, 049
SPLIT #	20225
[illegible]TE OF SURVEY	
MAP PAGE	9-E
SURVEYOR	Thomas M. Snezek