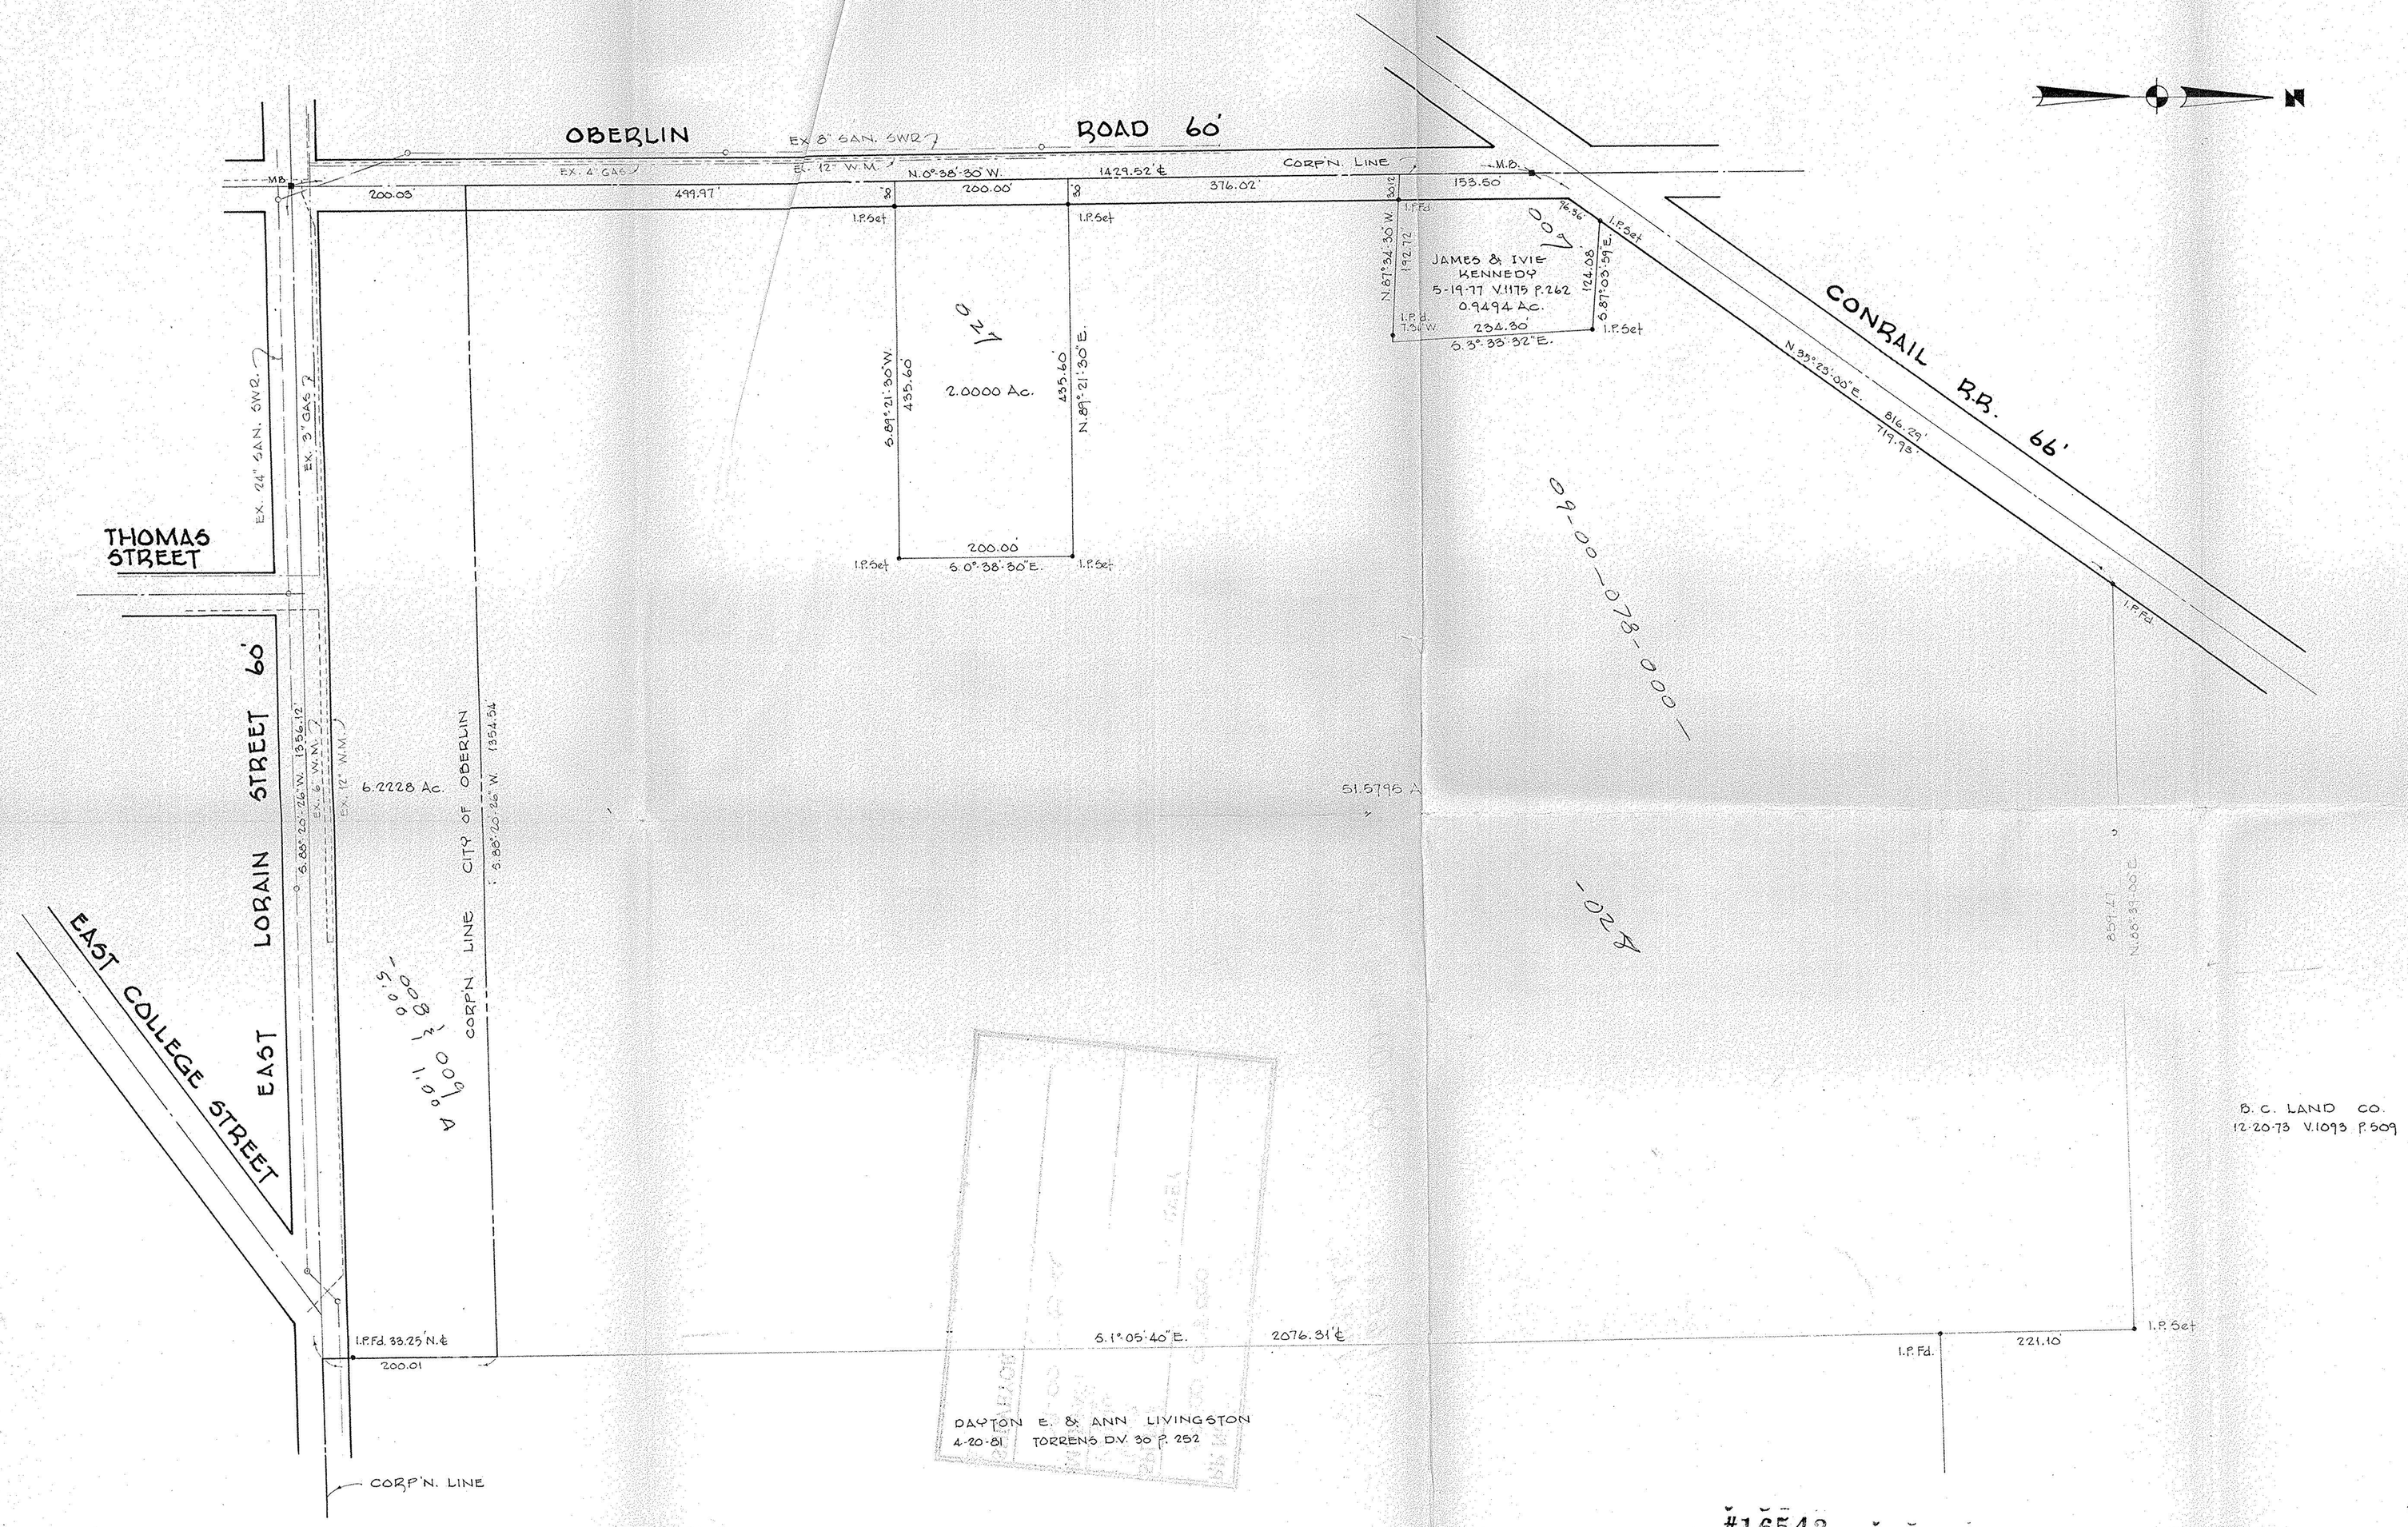

44.00
mailed in
retain in file

#16542
APPROVED
LORAIN CO.
MAP DEPT.
DATE 1-14-86
PAGE 9-00-078-A
BY T. McNair
VOID

#16546
APPROVED
LORAIN CO.
MAP DEPT.
DATE 1-15-86
PAGE 9-00-078-A
BY T. McNair
VOID

SURVEY FOR

C.M. & M. DEVELOPMENT INC.

PART OF O.L. 78 RUSSIA TOWNSHIP — CITY OF OBERLIN
COUNTY OF LORAIN — STATE OF OHIO
SCALE 1" = 100' — JANUARY, 1984
LAUNDON · SIMON · CAHL & ASSOC.
ENGINEERS — SURVEYORS
JOB No 84-1255 — F.B. 176 P. 35

Rev. 5/9/84 - Acreage for annexation R.G.S.

167

FEB 06 1985