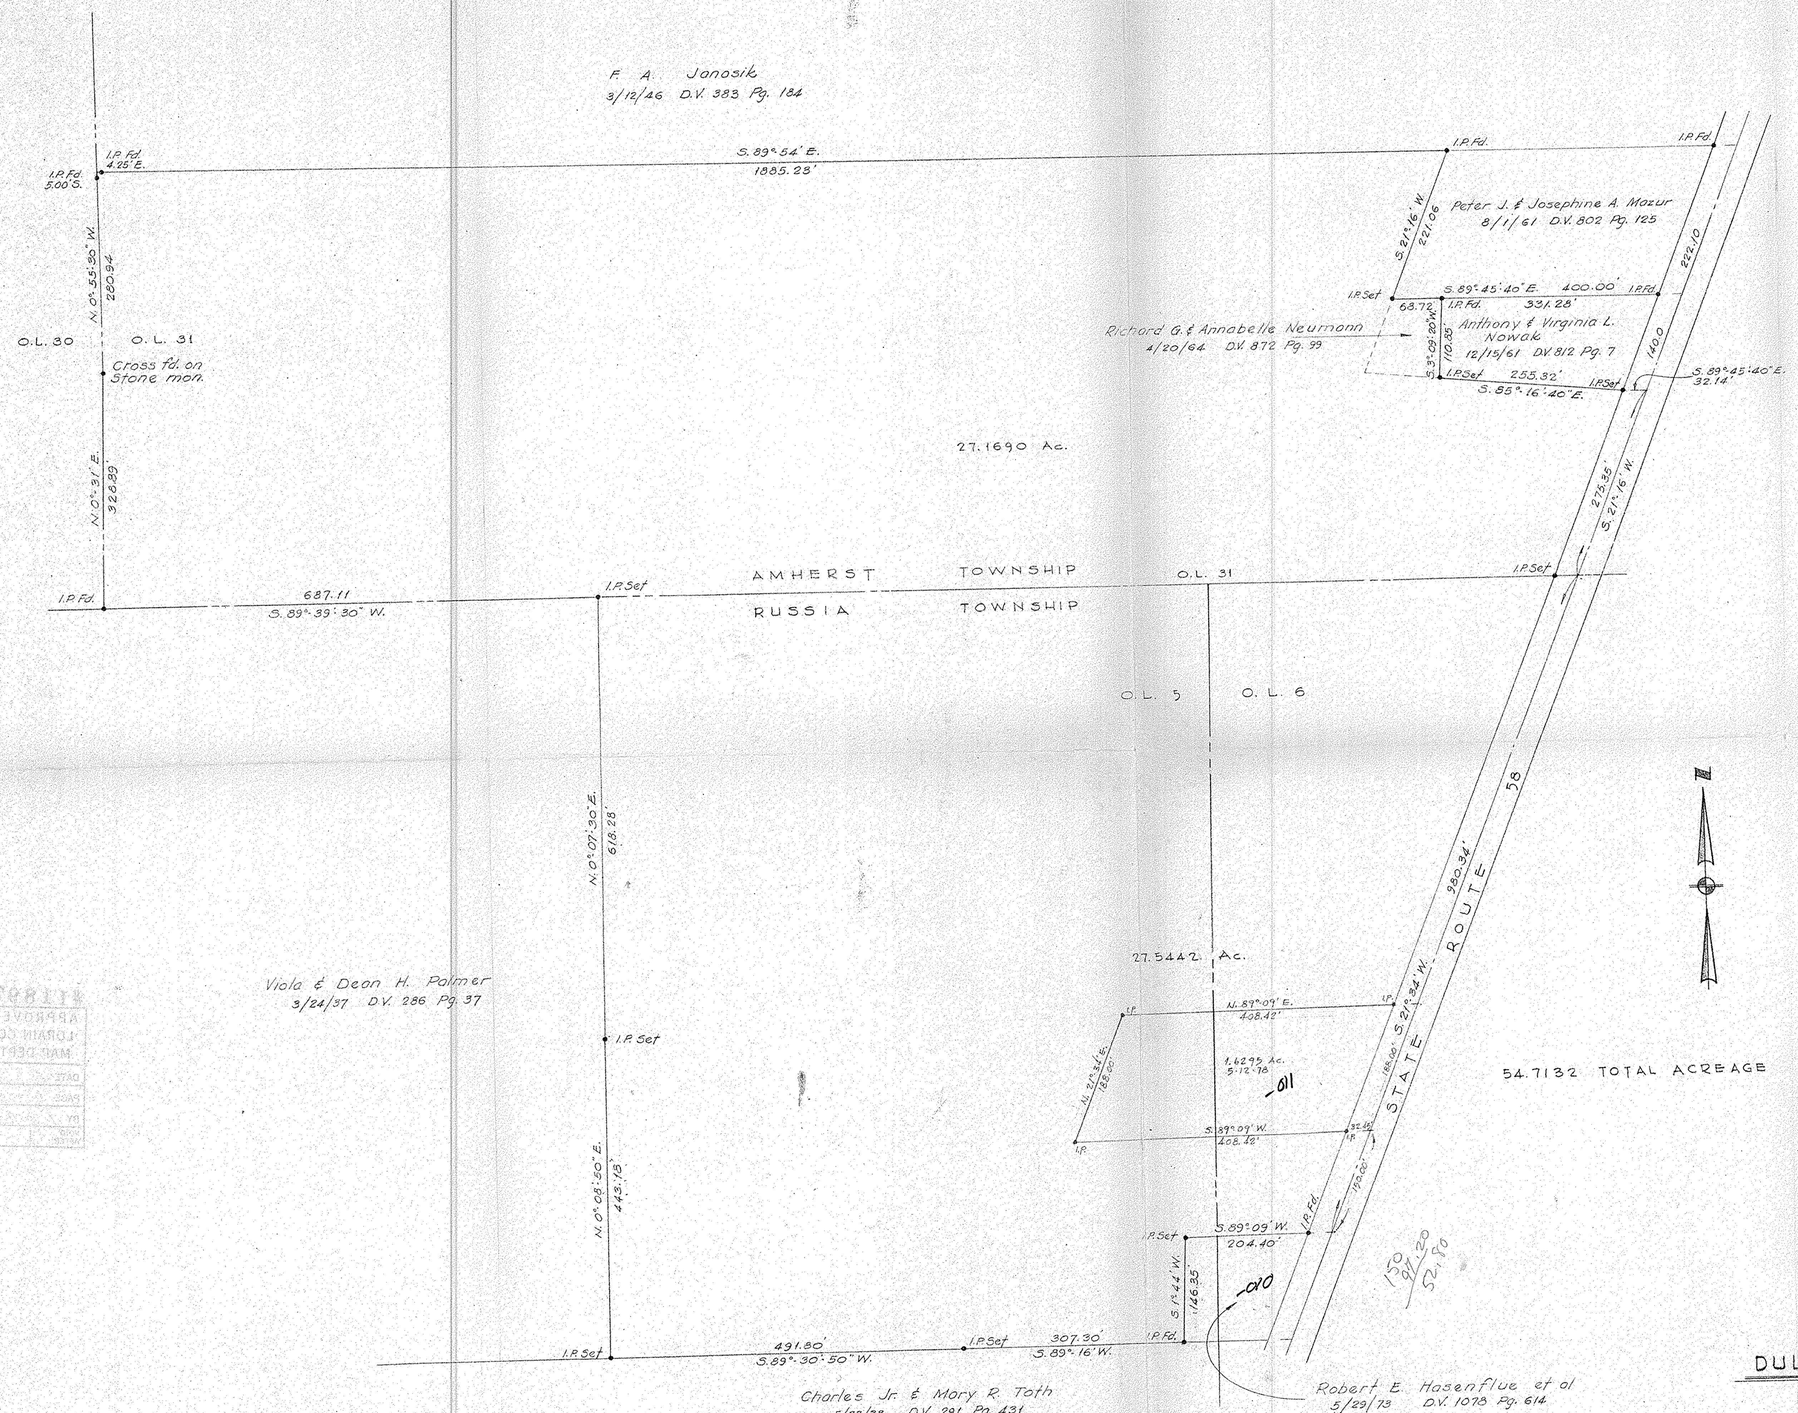

#11897

APPROVED
LORAIN CO.
MAP DEPT.
DATE 8-8-78
PAGE 9-B-C
BY T. McClain
VOID AFTER 11897

SURVEY FOR

DULIO GOLF ENTERPRISES INC.

O.L. 31 AMHERST TOWNSHIP
O.L.'s 5 & 6 RUSSIA TOWNSHIP
LORAIN COUNTY OHIO
SCALE 1"=100' SEPT. 1973
LAUNDON · SIMON · CAHL & ASSOC.
ENGINEERS & SURVEYORS

JUL 31 1978

REVISED 5-12-78 1.6295 ACRE PARCEL CUT

Job No. 73-159