
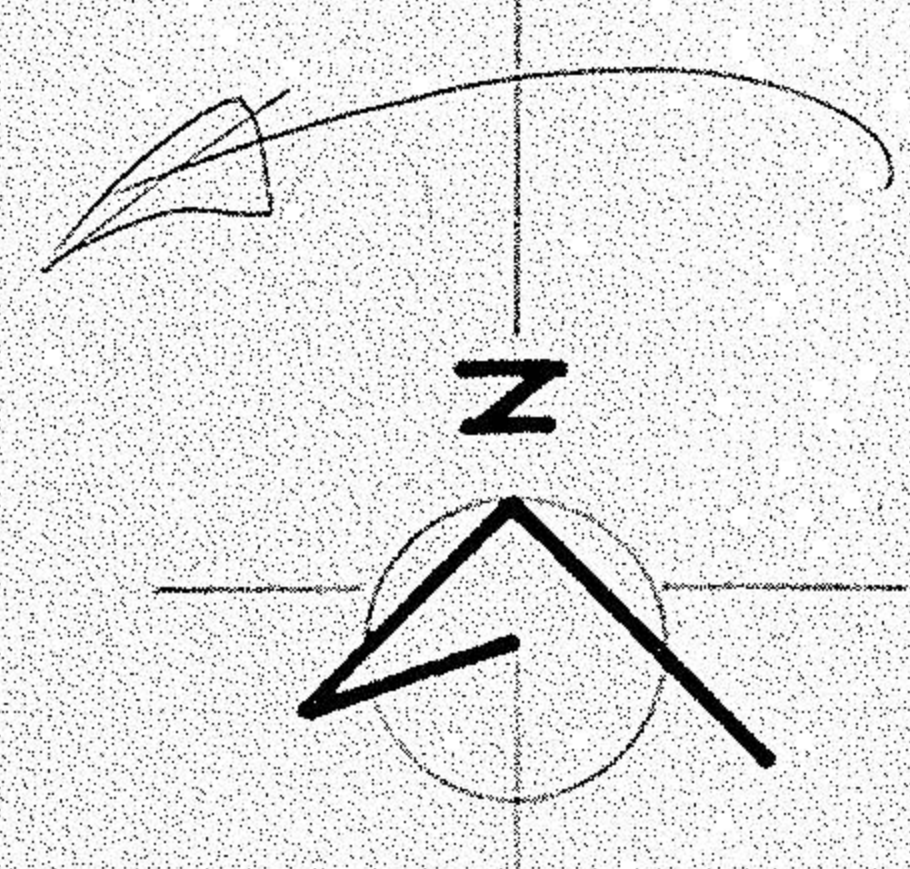


5-00-013-101

5-00-013 5-00-013-A 05-00-013-101

5-00-013-A

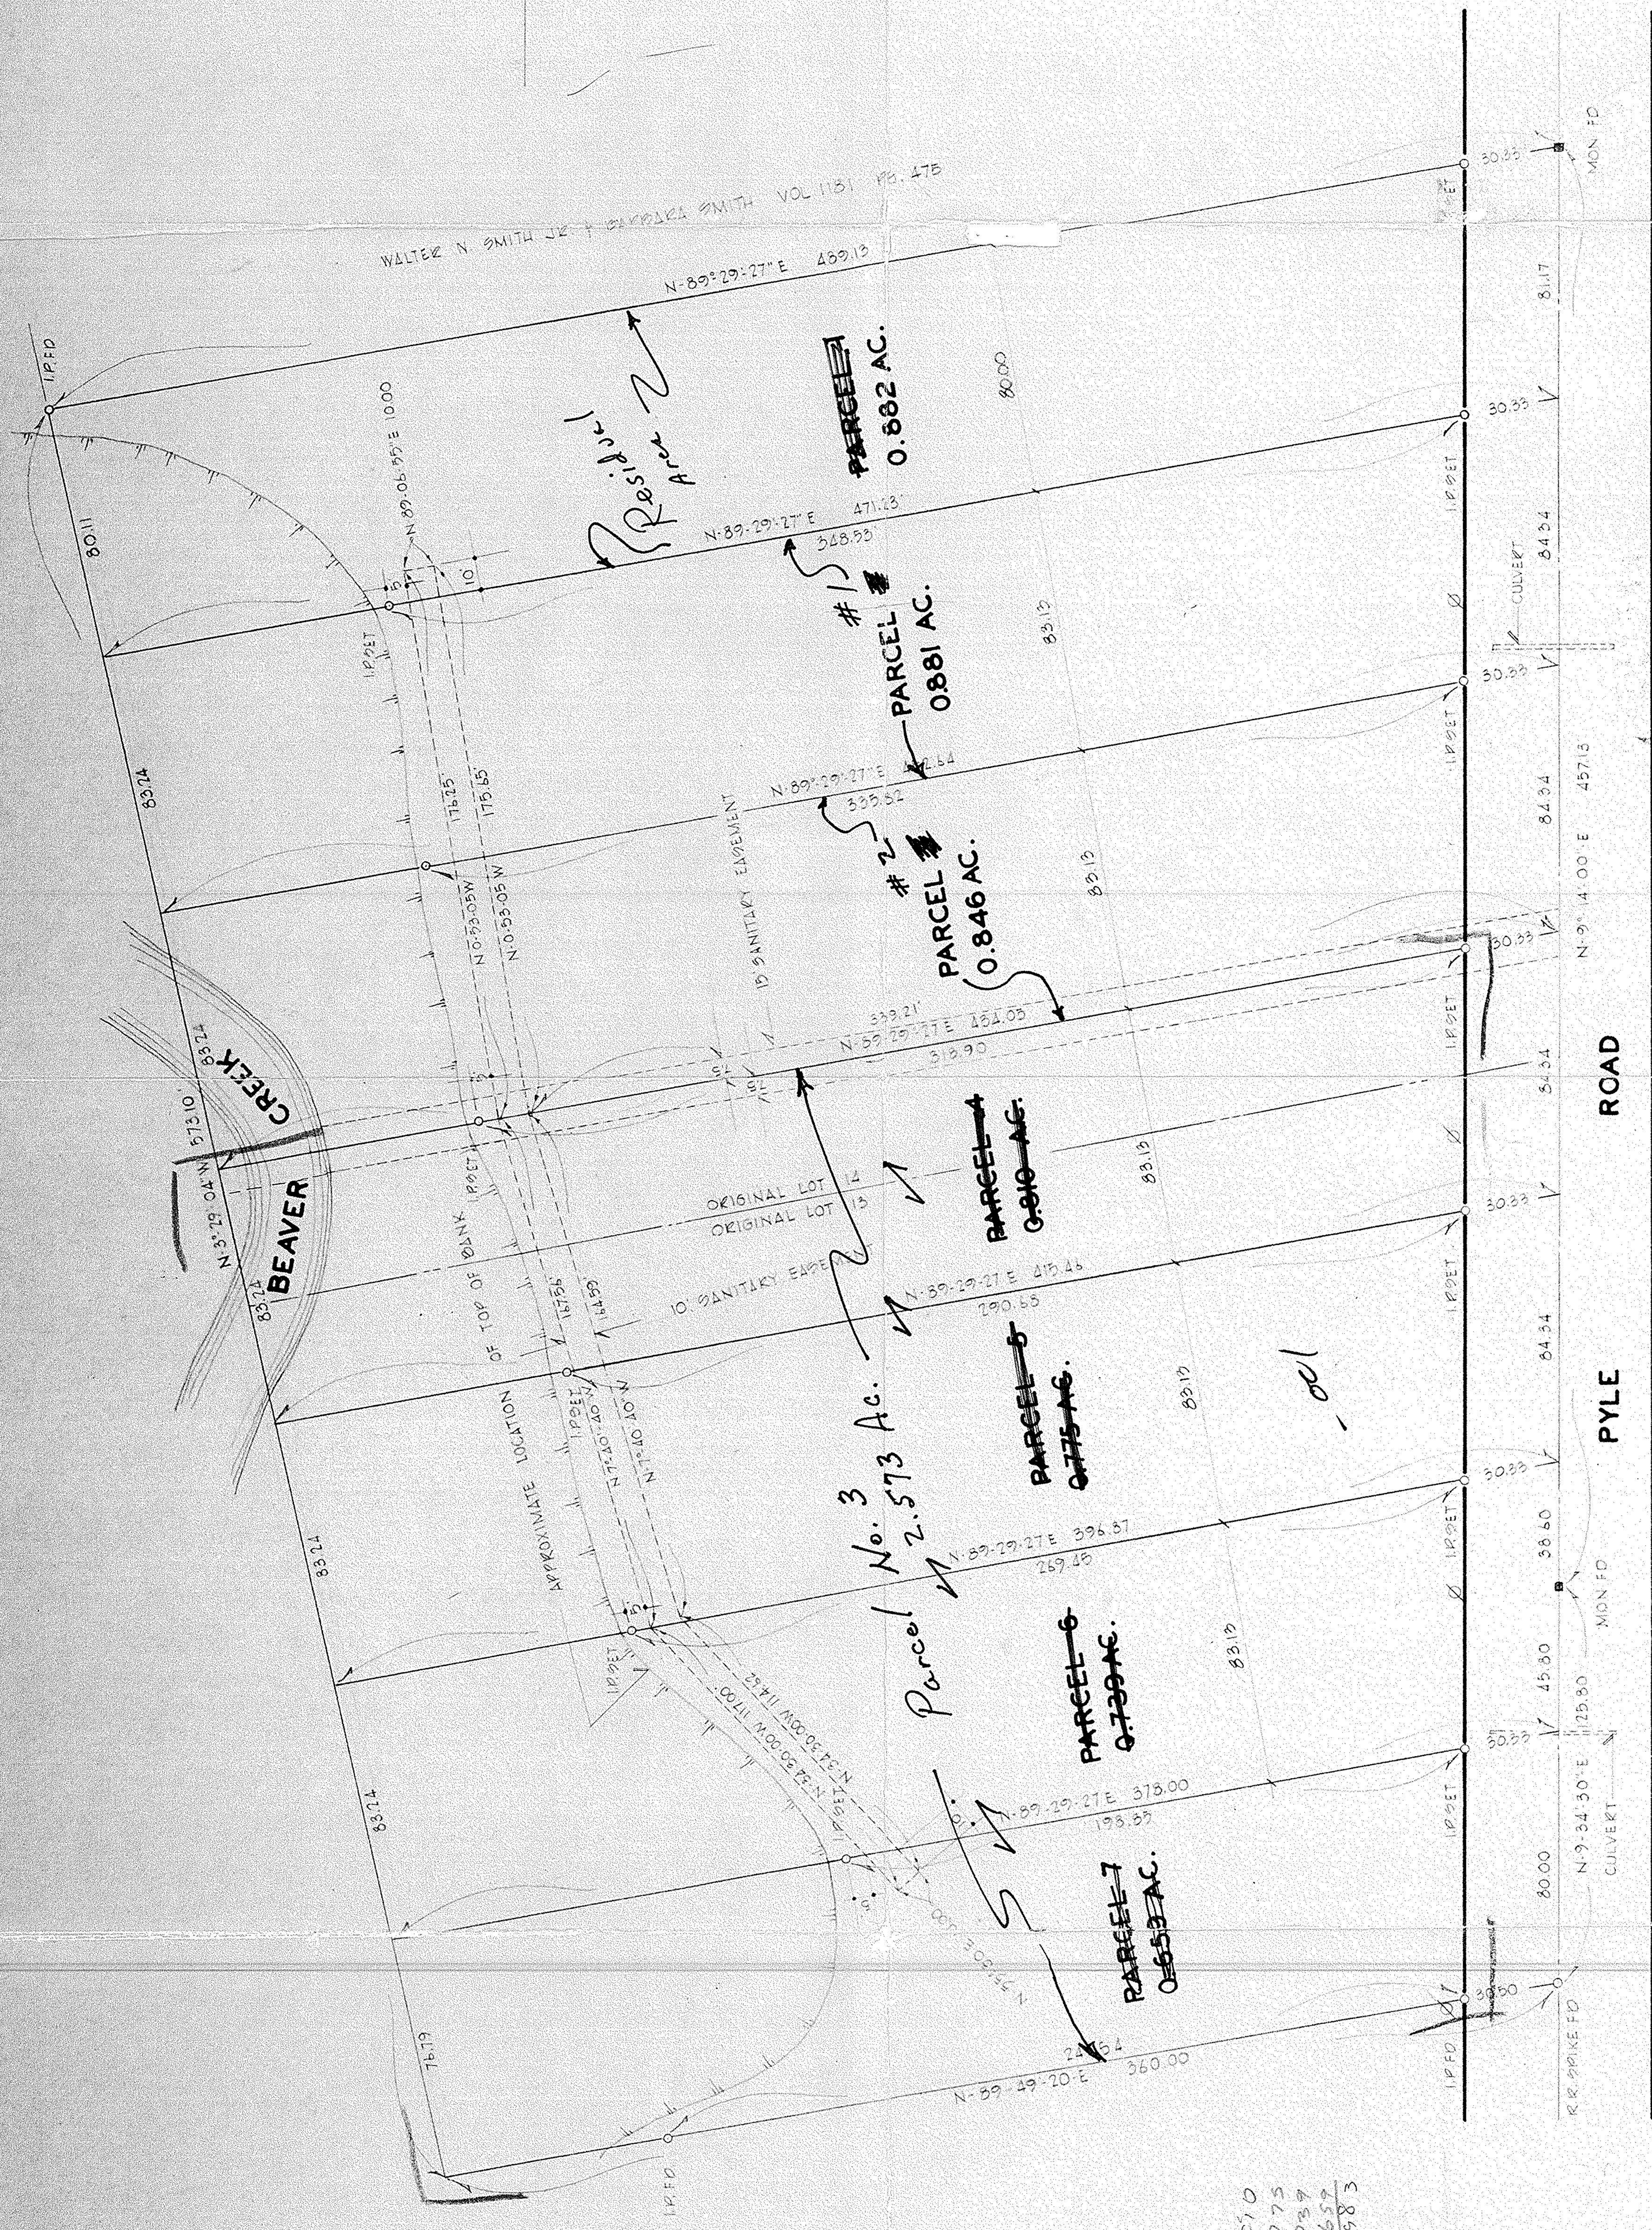

 N-89°29'27" E 439.19

#13577
 APPROVED
 LORAIN CO.
 MAP DEPT.
 DATE 5-13-80
 PAGE 5-00-013-A
 BY T. Marshall
 VOID AFTER

2.573
 .41
 2.983

DATE	5-13-80
PAGE	5-00-013-A
BY	T. Marshall
VOID AFTER	

MR. LARRY MARSHALL
 M & E CONSTRUCTION

SURVEY AND LOT SPLIT OF PART OF O.L. NOS 13 & 14 OF AMHERST TWP. LORAIN CO. OHIO

SCALE 1" = 30'

MARCH 1980

APPROVED
 AS TO DESCRIPTION ONLY
 Date 5-8-80
 City of Lorain
 PE [Signature]

APPROVED BY THE LORAIN CITY PLANNING COMMISSION
 DATE 5-8-80
 SECRETARY LORAIN CITY PLANNING COMMISSION

norman hura
 S E T A I C O S S S

