


09-00-055-000

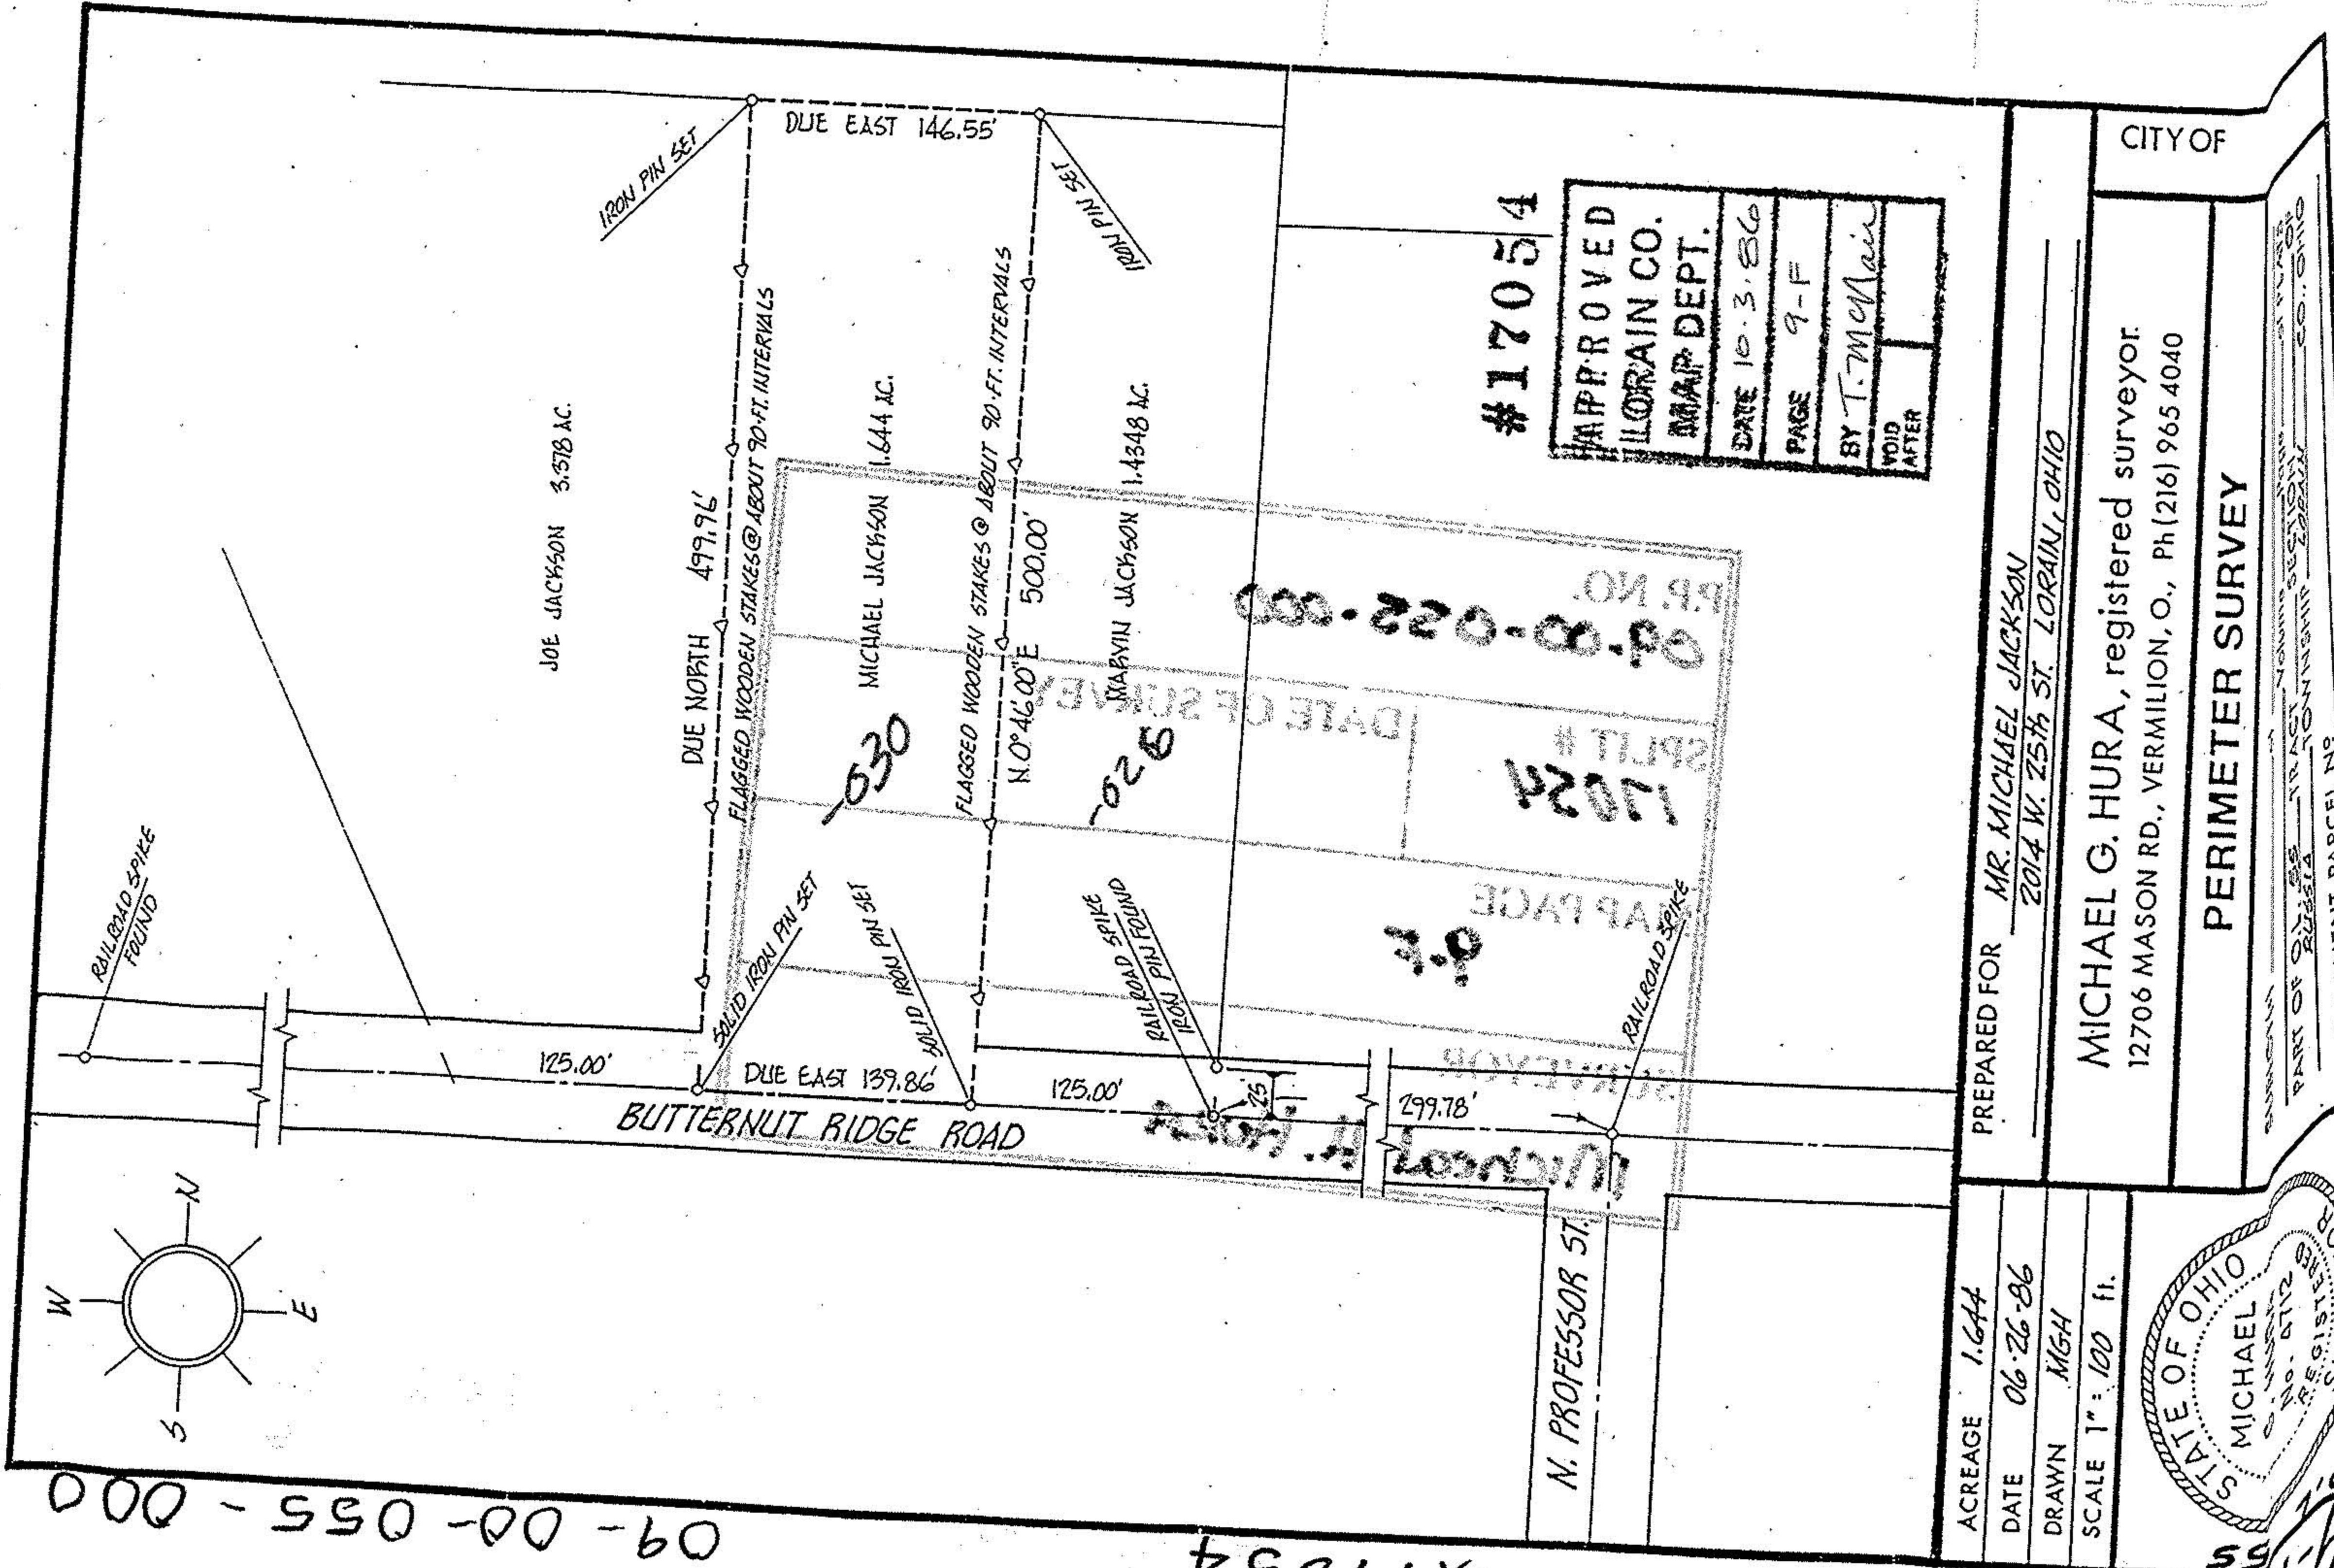

#17054


APPROVED
LORAIN CO. MAP DEPT.
DATE 10-3-86
PAGE 9-F
BY T. McMain
VOID AFTER

PREPARED FOR MR. MICHAEL JACKSON
2014 W. 25TH ST. LORAIN, OHIO

MICHAEL G. HURA, registered surveyor.
 12706 MASON RD., VERMILION, O., Ph (216) 965 4040

PERIMETER SURVEY

ACREAGE 1.644
 DATE 06-26-86
 DRAWN MGH
 SCALE 1" = 100 ft.

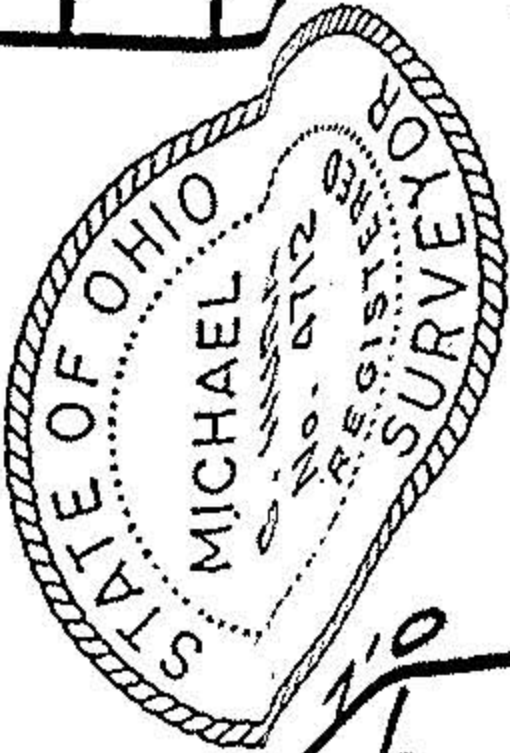

CITY OF _____
 PART OF _____
 PERMANENT PARCEL NO _____