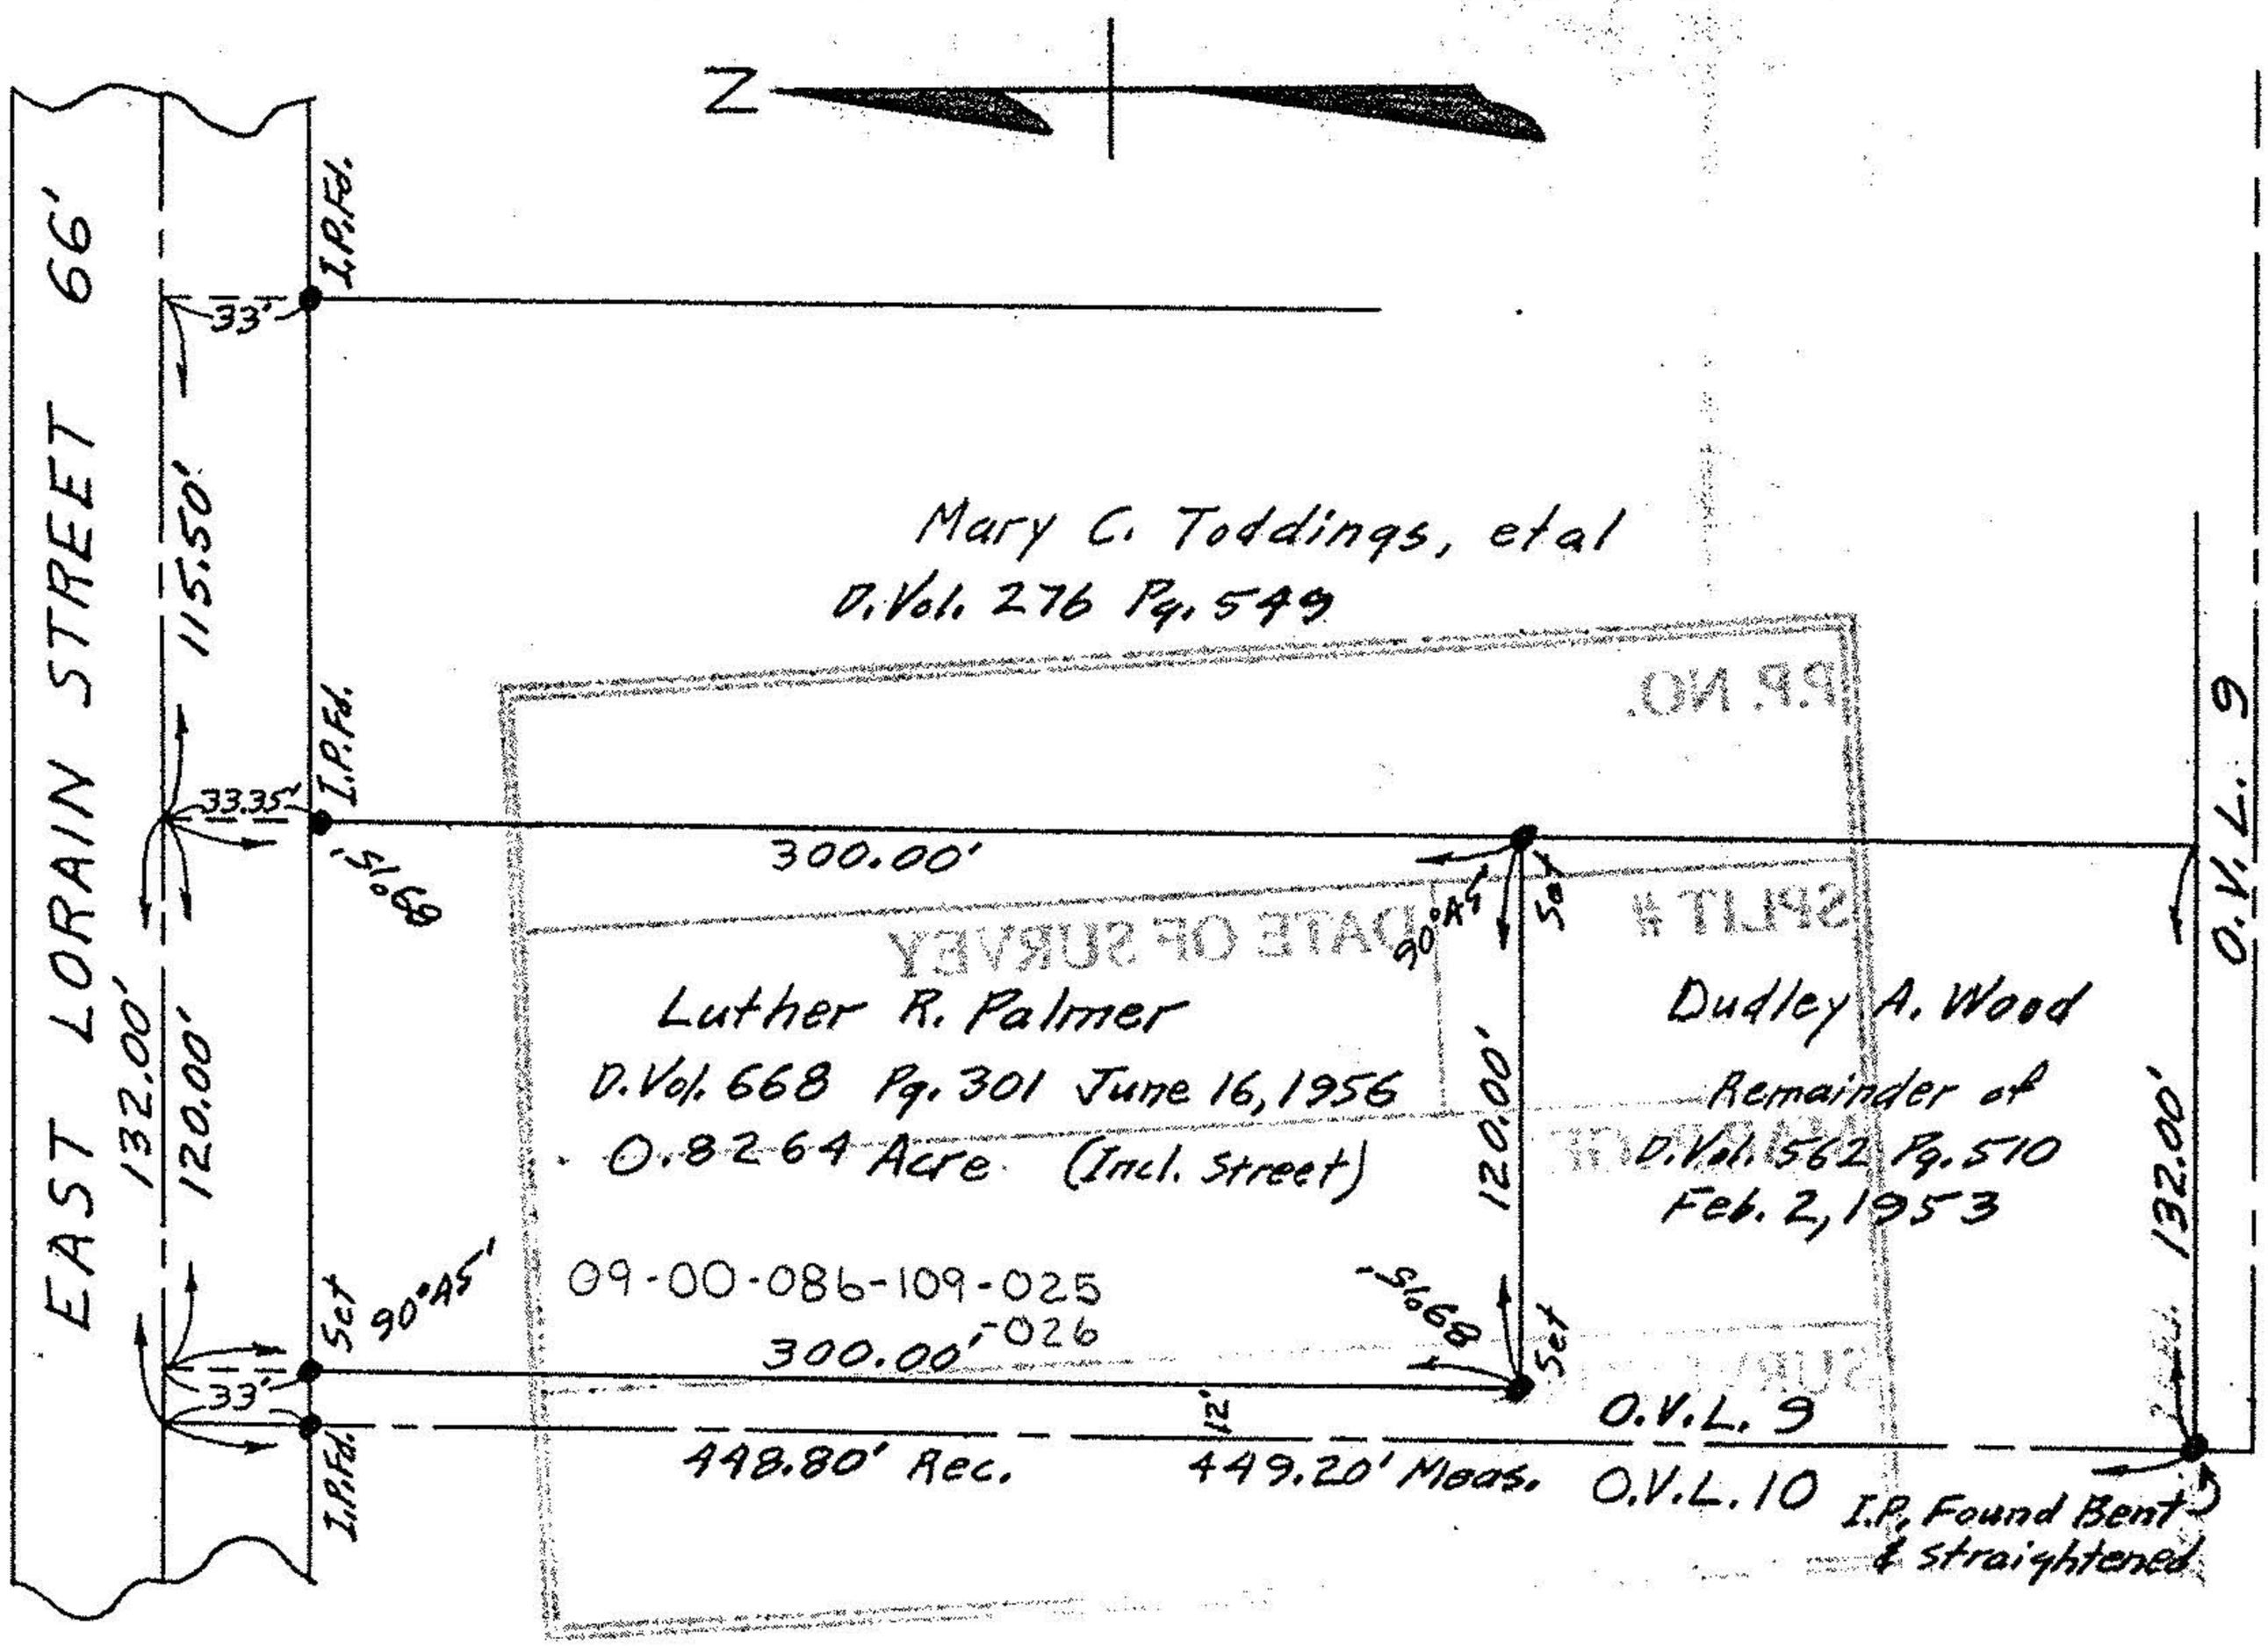

PLAT OF SURVEY FOR LUTHER R. PALMER

ORIGINAL VILLAGE LOT No. 9 - OBERLIN CITY

ORIGINAL LOT No. 86 - RUSSIA TOWNSHIP

LORAIN COUNTY - OHIO

SCALE: 1" = 60' MAY 3, 1957

C.E. Penfound Registered Surveyor

NOTE: Iron pins found or set shown thus: ●