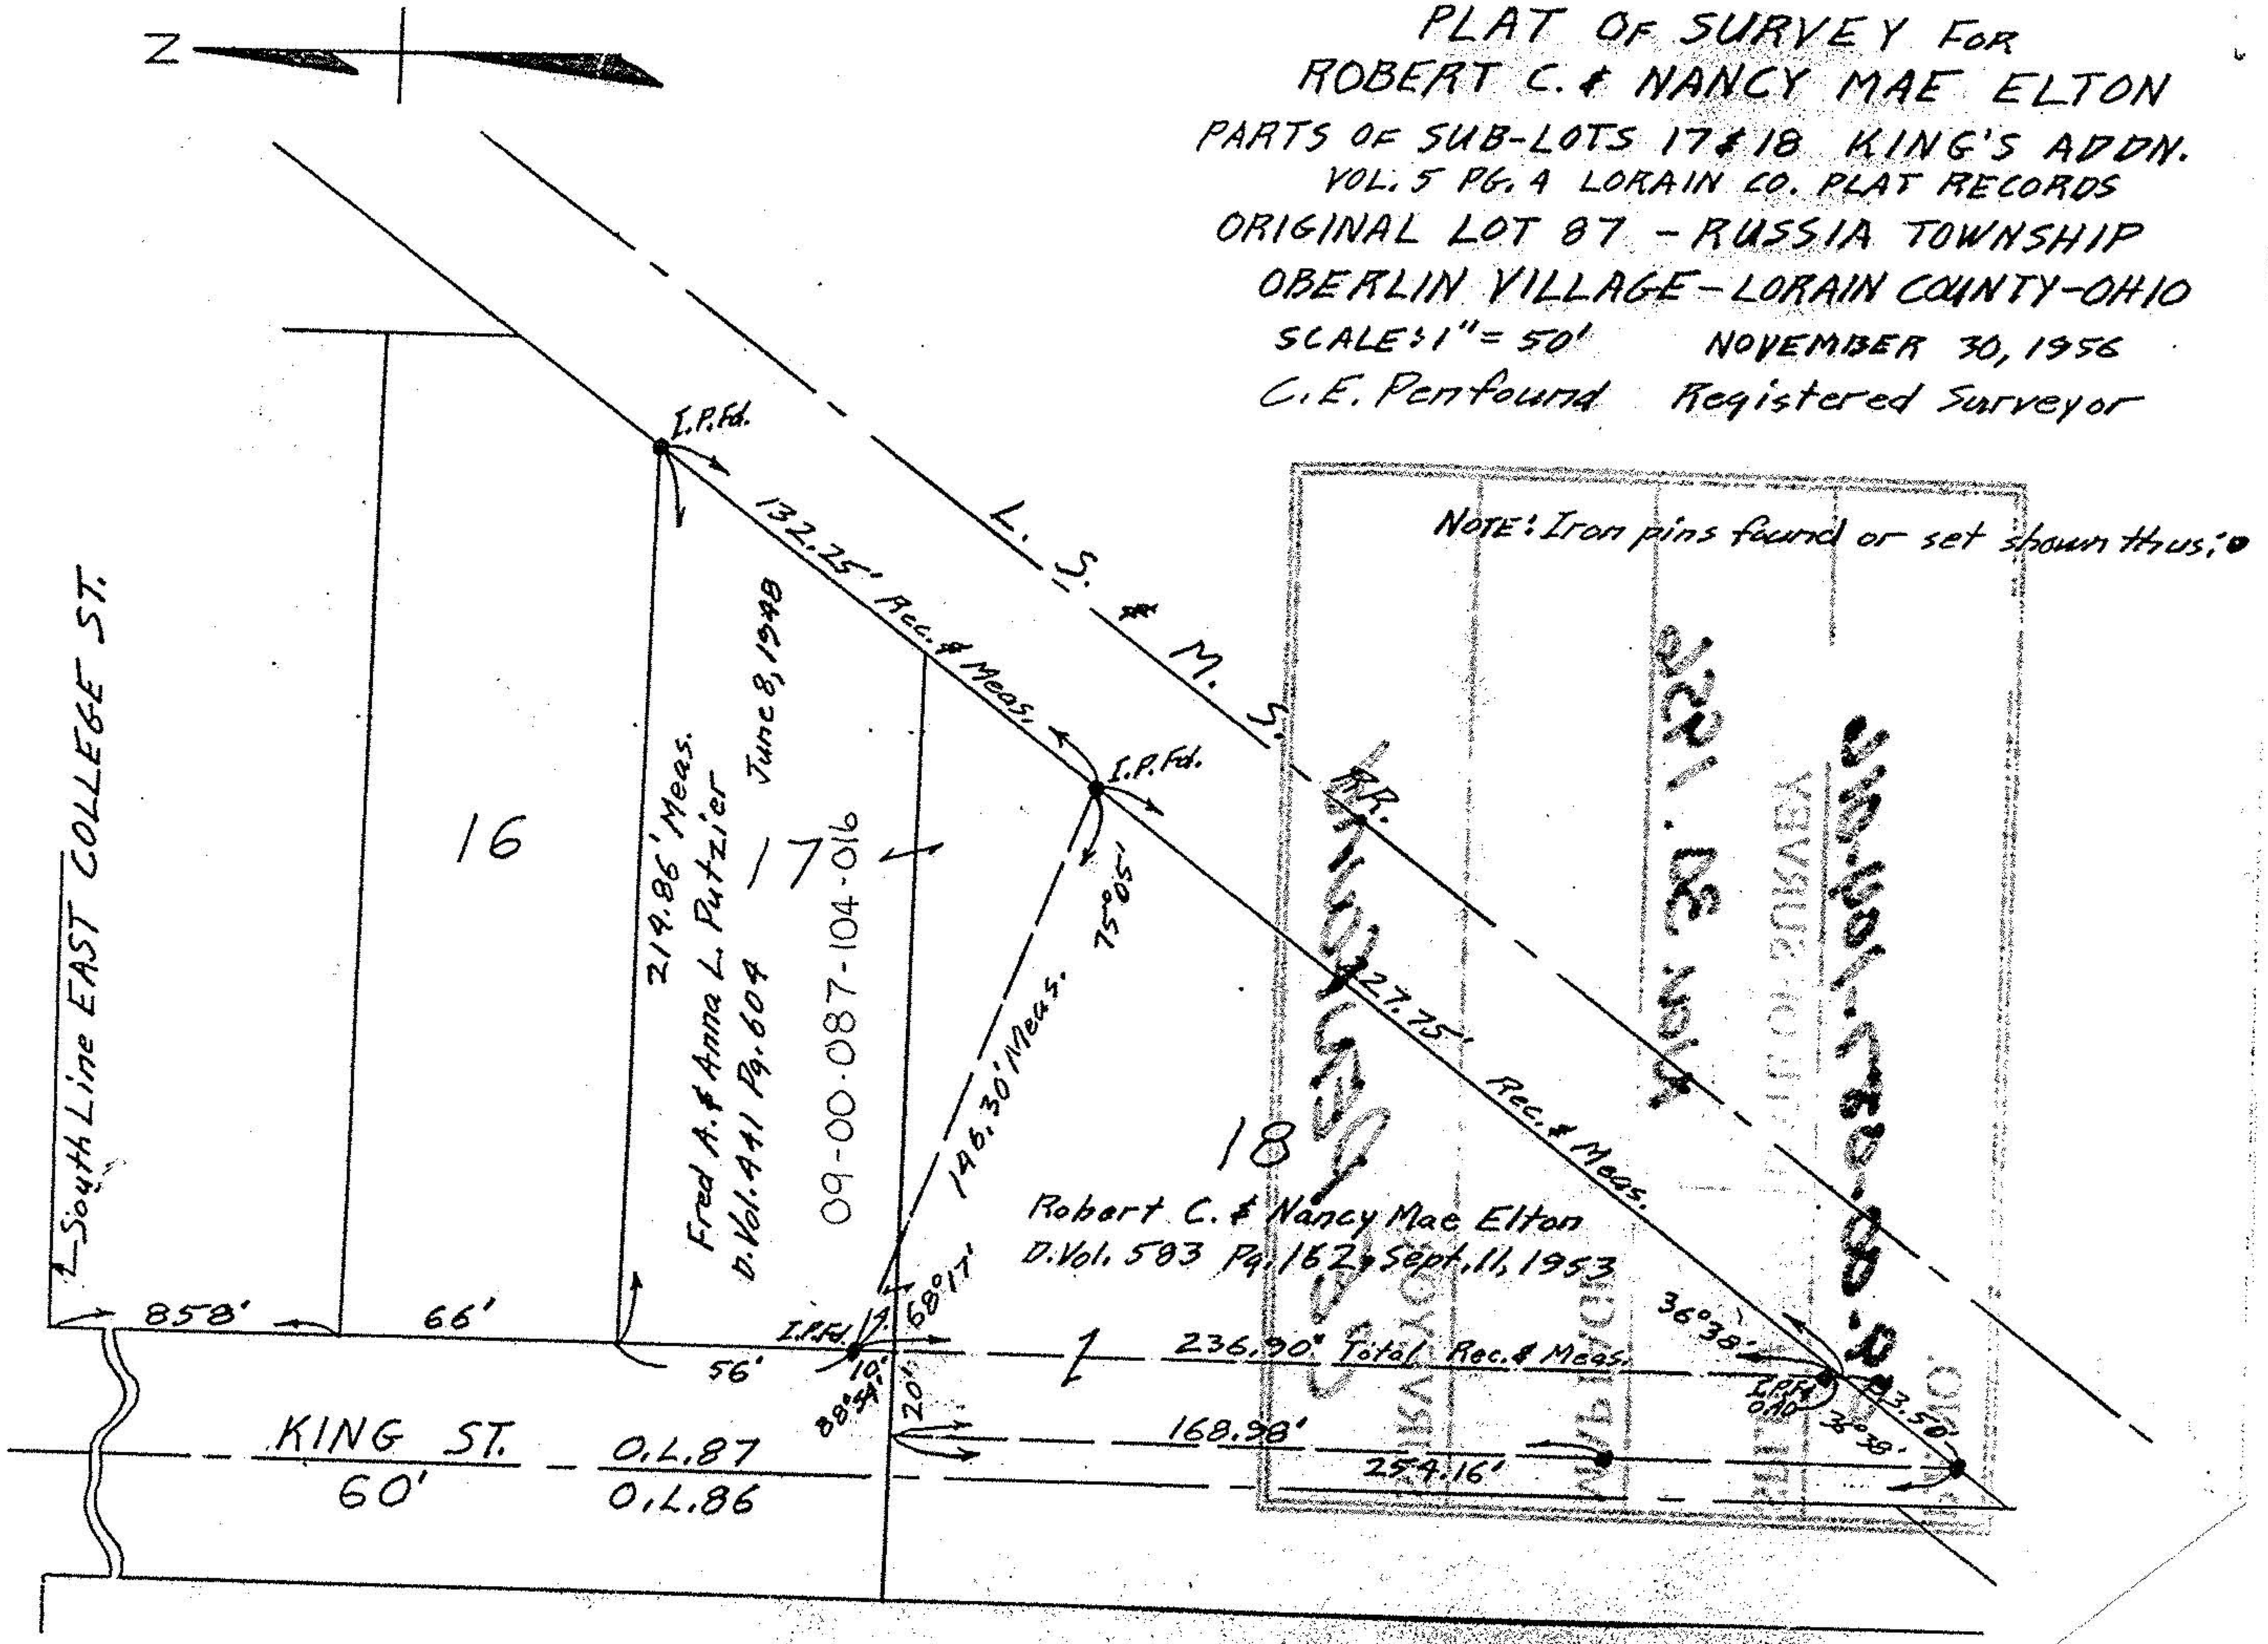PLAT OF SURVEY FOR
ROBERT C. & NANCY MAE ELTON
PARTS OF SUB-LOTS 17 & 18 KING'S ADDN.
VOL. 5 PG. 4 LORAIN CO. PLAT RECORDS
ORIGINAL LOT 87 - RUSSIA TOWNSHIP
OBERLIN VILLAGE - LORAIN COUNTY - OHIO
SCALE: 1" = 50' NOVEMBER 30, 1956
C. E. Penfound Registered Surveyor