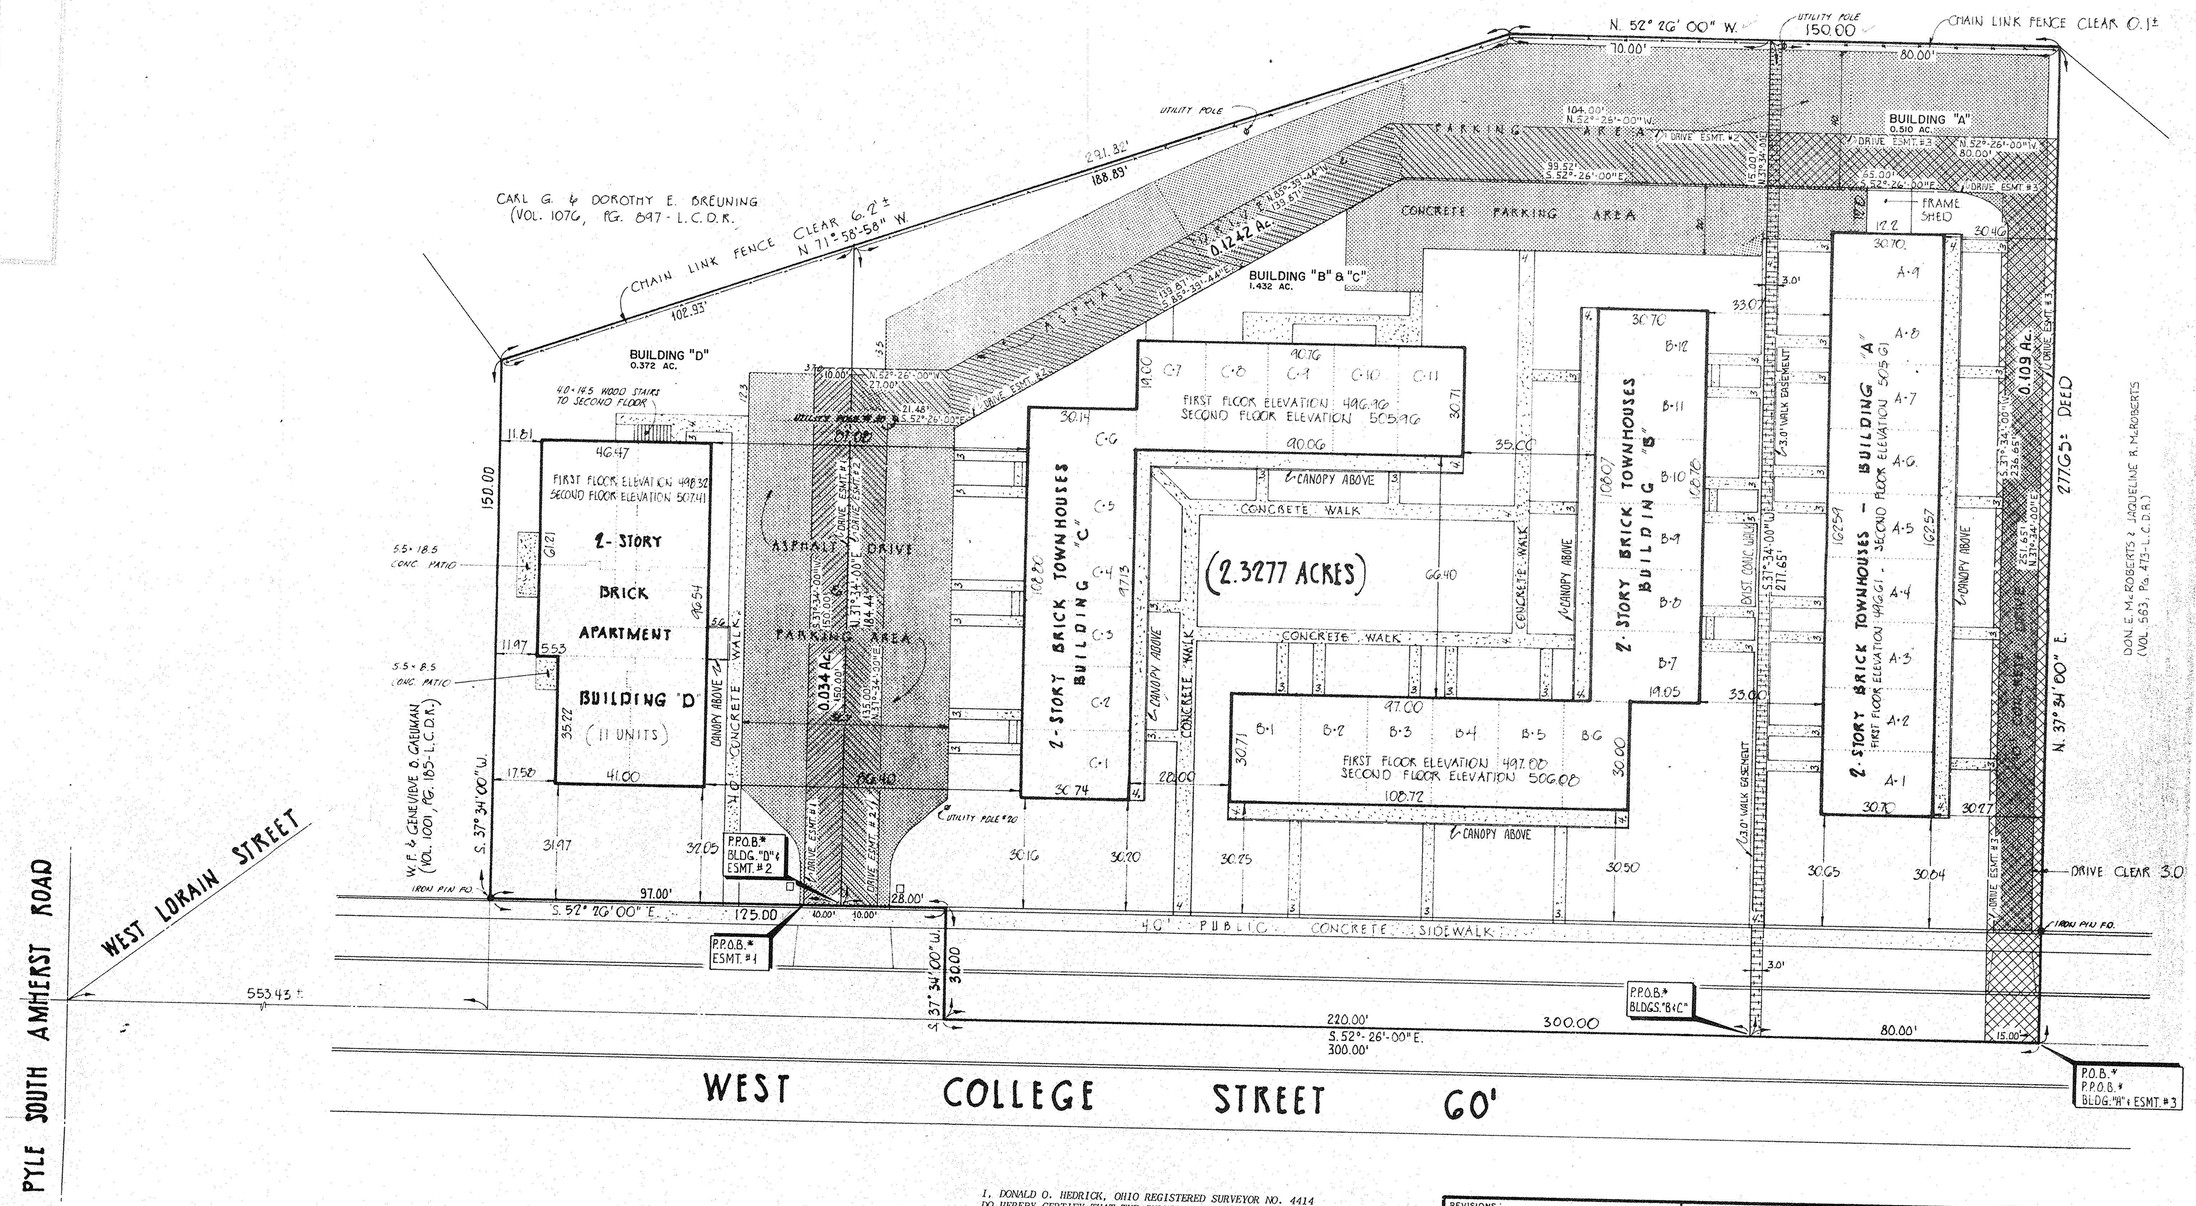

PRINTED

AUG 18 1989

I, DONALD O. HEDRICK, OHIO REGISTERED SURVEYOR NO. 4414 DO HEREBY CERTIFY THAT THE SURVEY SHOWN HEREON IS A TRUE AND ACCURATE REPRESENTATION OF THE PREMISES LOCATED AT WEST COLLEGE STREET, OBERLIN OHIO, THAT THERE ARE NO ENCROACHMENTS UPON OR OVER THE ESTABLISHED PROPERTY LINES EXCEPT AS NOTED. DIMENSIONS HEREON ARE EXPRESSED IN FEET AND DECIMAL PARTS THEREOF, ALL OF WHICH I CERTIFY TO BE CORRECT.

DONALD O. HEDRICK P.S. 4414 — DATE 8/17/89

REVISIONS:

SEAL: STATE OF OHIO — DONALD O. HEDRICK 4414 REGISTERED SURVEYOR

BOUNDARY & LOCATION SURVEY

P.P.N. 9-00-084-004, 055, & 065

BEING PART OF ORIGINAL TOWNSHIP OF RUSSIA, ORIGINAL LOT 84, CITY OF OBERLIN, COUNTY OF LORAIN, STATE OF OHIO.

FIELD: J.H.	DSGD.	DWN. J.B.	CHKD. D.O.H.	APP.	DWG. NO.	SHEET	OF
SCALE: 1" = 20'			DATE: AUGUST 1989		79829-8	1	1

HEDRICK & ASSOCIATES INC. ENGINEERS · SURVEYORS CHESTER TOWNSHIP, OHIO 44026 PH.: (216) · 423 - 0066