



KLEINOEDER-SCHMIDT

and ASSOCIATES

ENGINEERS — SURVEYORS — CONSULTANTS IN LAND PLANNING

ELYRIA - MORWALK - MEDINA

OHIO

SURVEY

Sublot(s) _____

Subd'n _____

Township RUSSIA

Tract _____


Orig. Lot(s) 106

Sec. _____

County of LORAIN

State of Ohio

Corporation _____

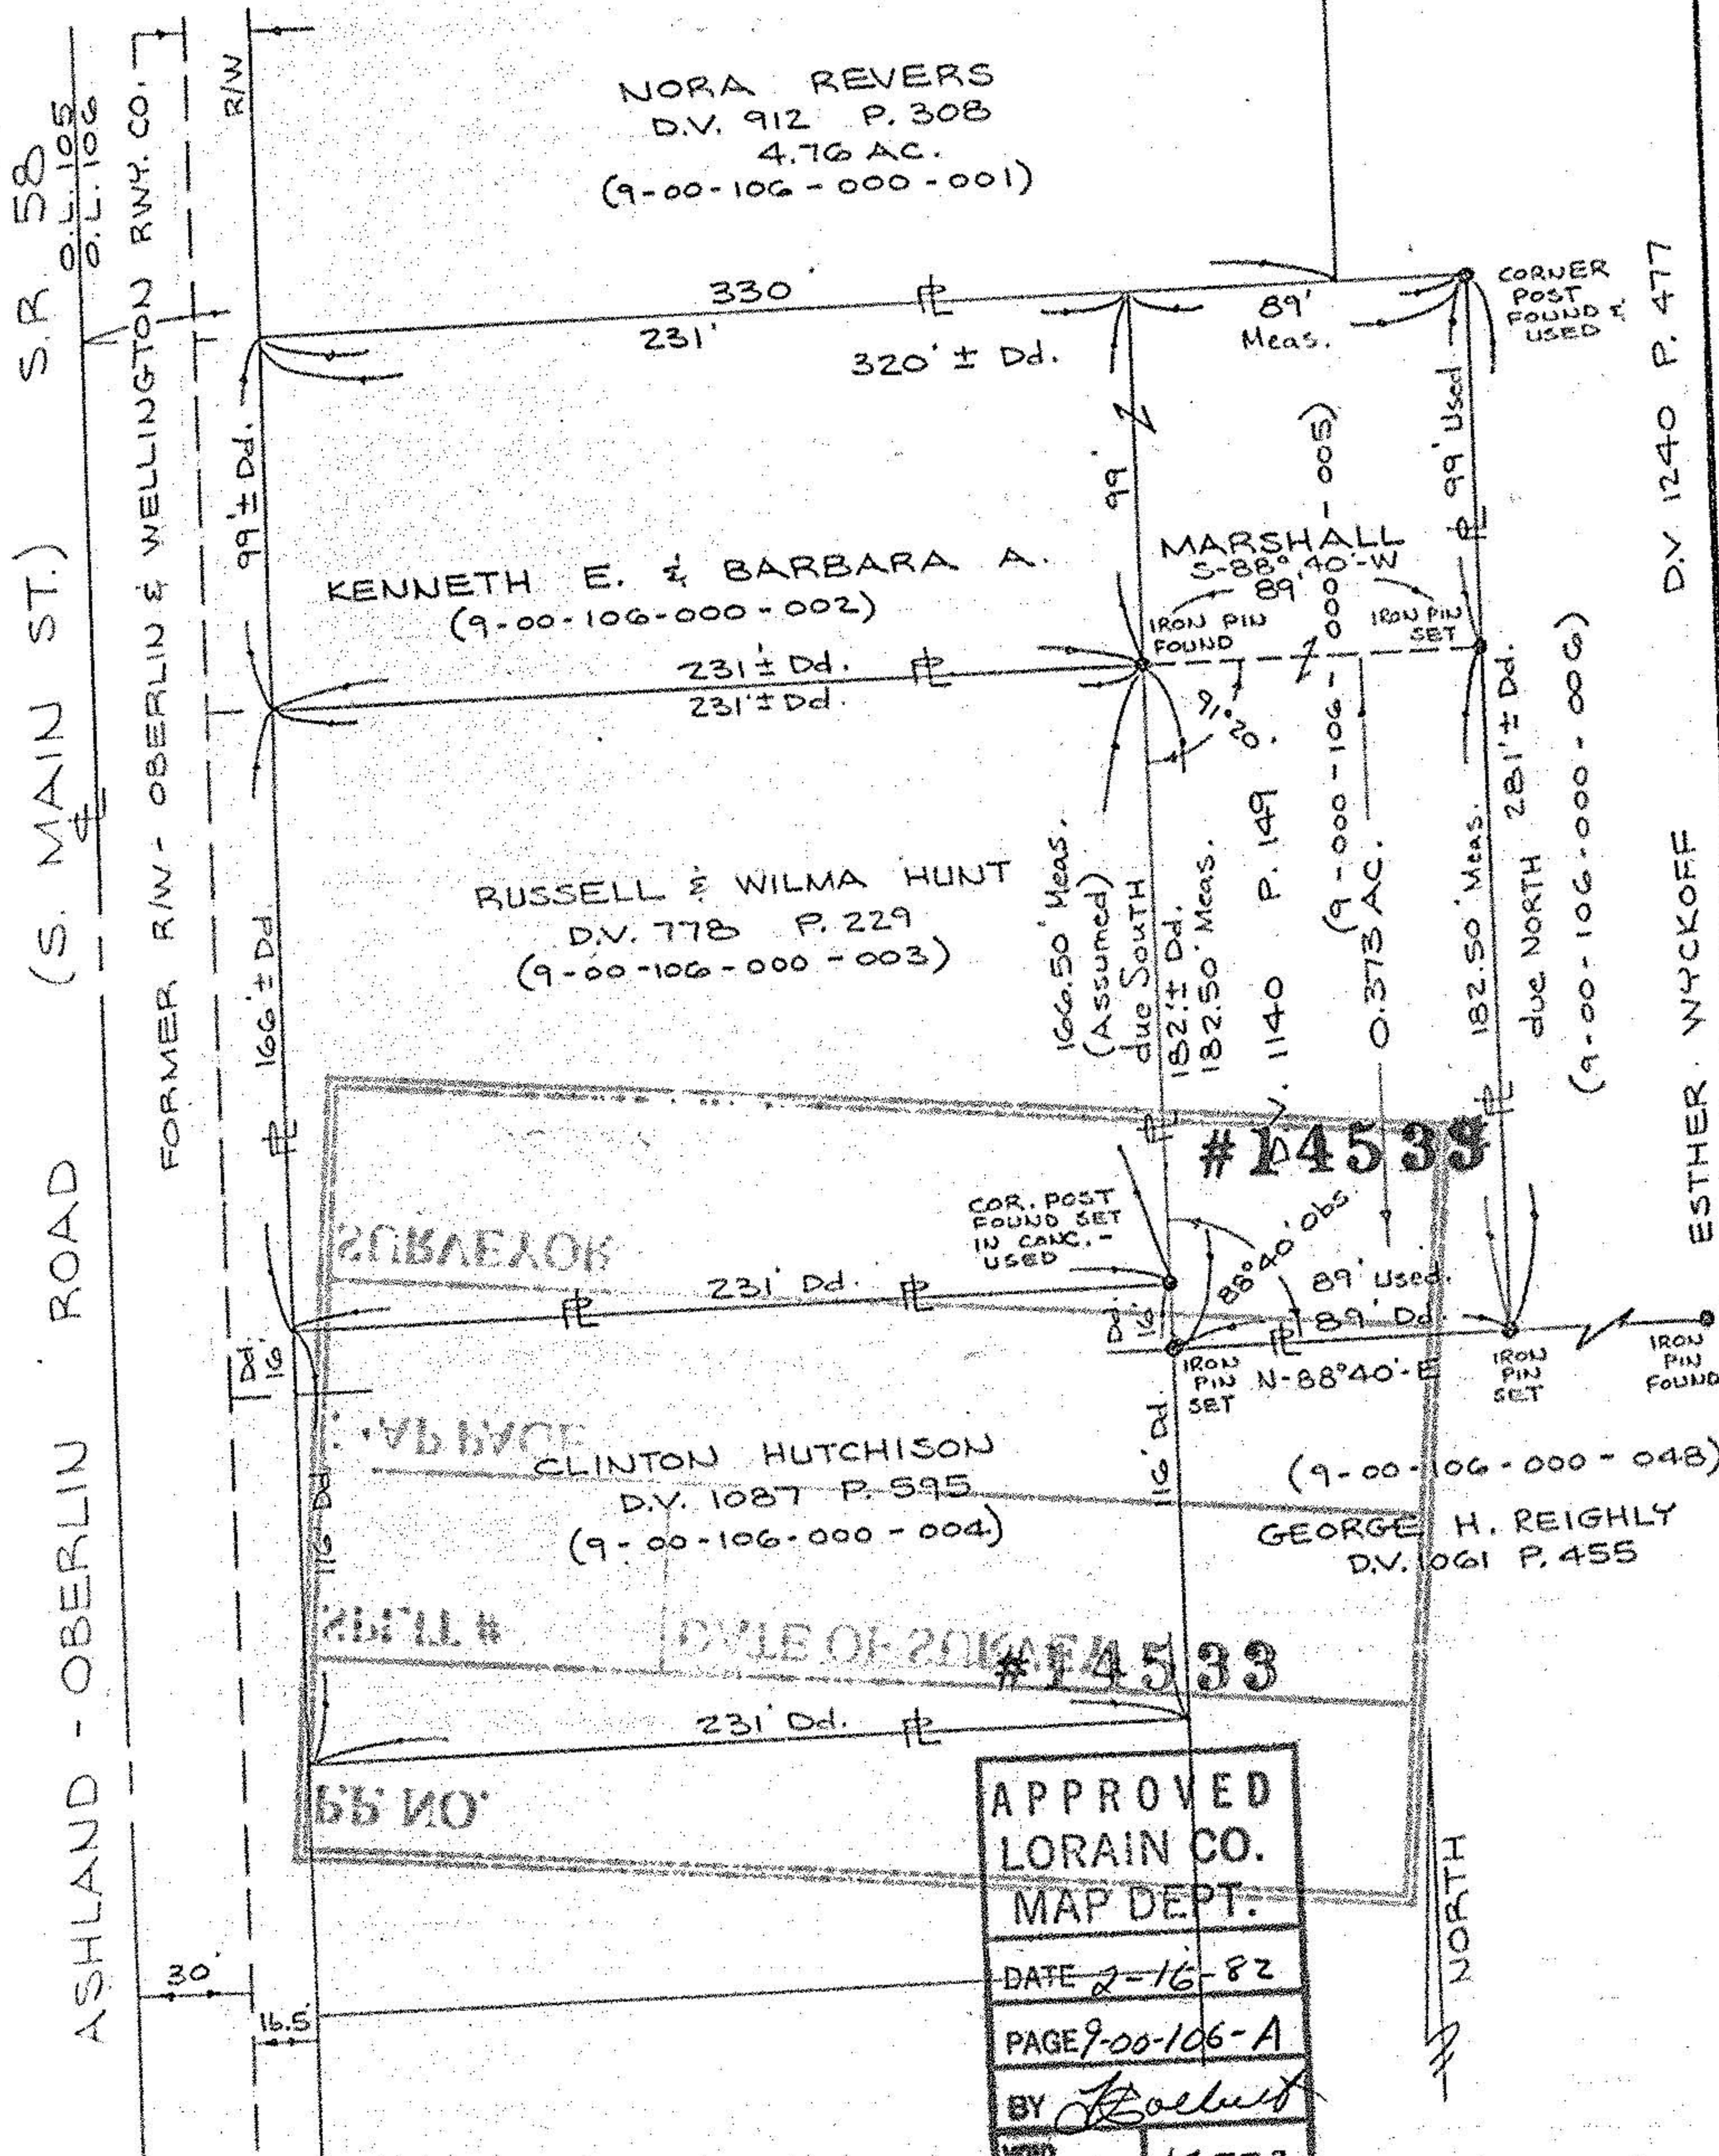

Prepared for:

RUSSELL HUNT
RTE. 58 S. OBERLIN, OHIO

Scale: 1" = 60'

Date: 7-2-81

Dr. by: *DE*

Job No 81-95