



LAUNDON . SIMON . CAHL & ASSOC. INC.  
CONSULTING ENGINEERS & SURVEYORS  
219 COURT ST. ELYRIA, OHIO 44035

SURVEY FOR THE:


CITY OF OBERLIN

Orig. Lot 95	City of OBERLIN	Date JULY 25, '86 Scale 1"=40'
Orig. Sec	Village of	Dwn. by R.G.S. Chkd. by C.J.
Tract	County of LORAIN	Job No. 86-1515 F.B.
Township of RUSSIA	State of OHIO	Printed AUG 05 1986

09-00-095-106

#17034

SOUTH PROFESSOR ST. 60'

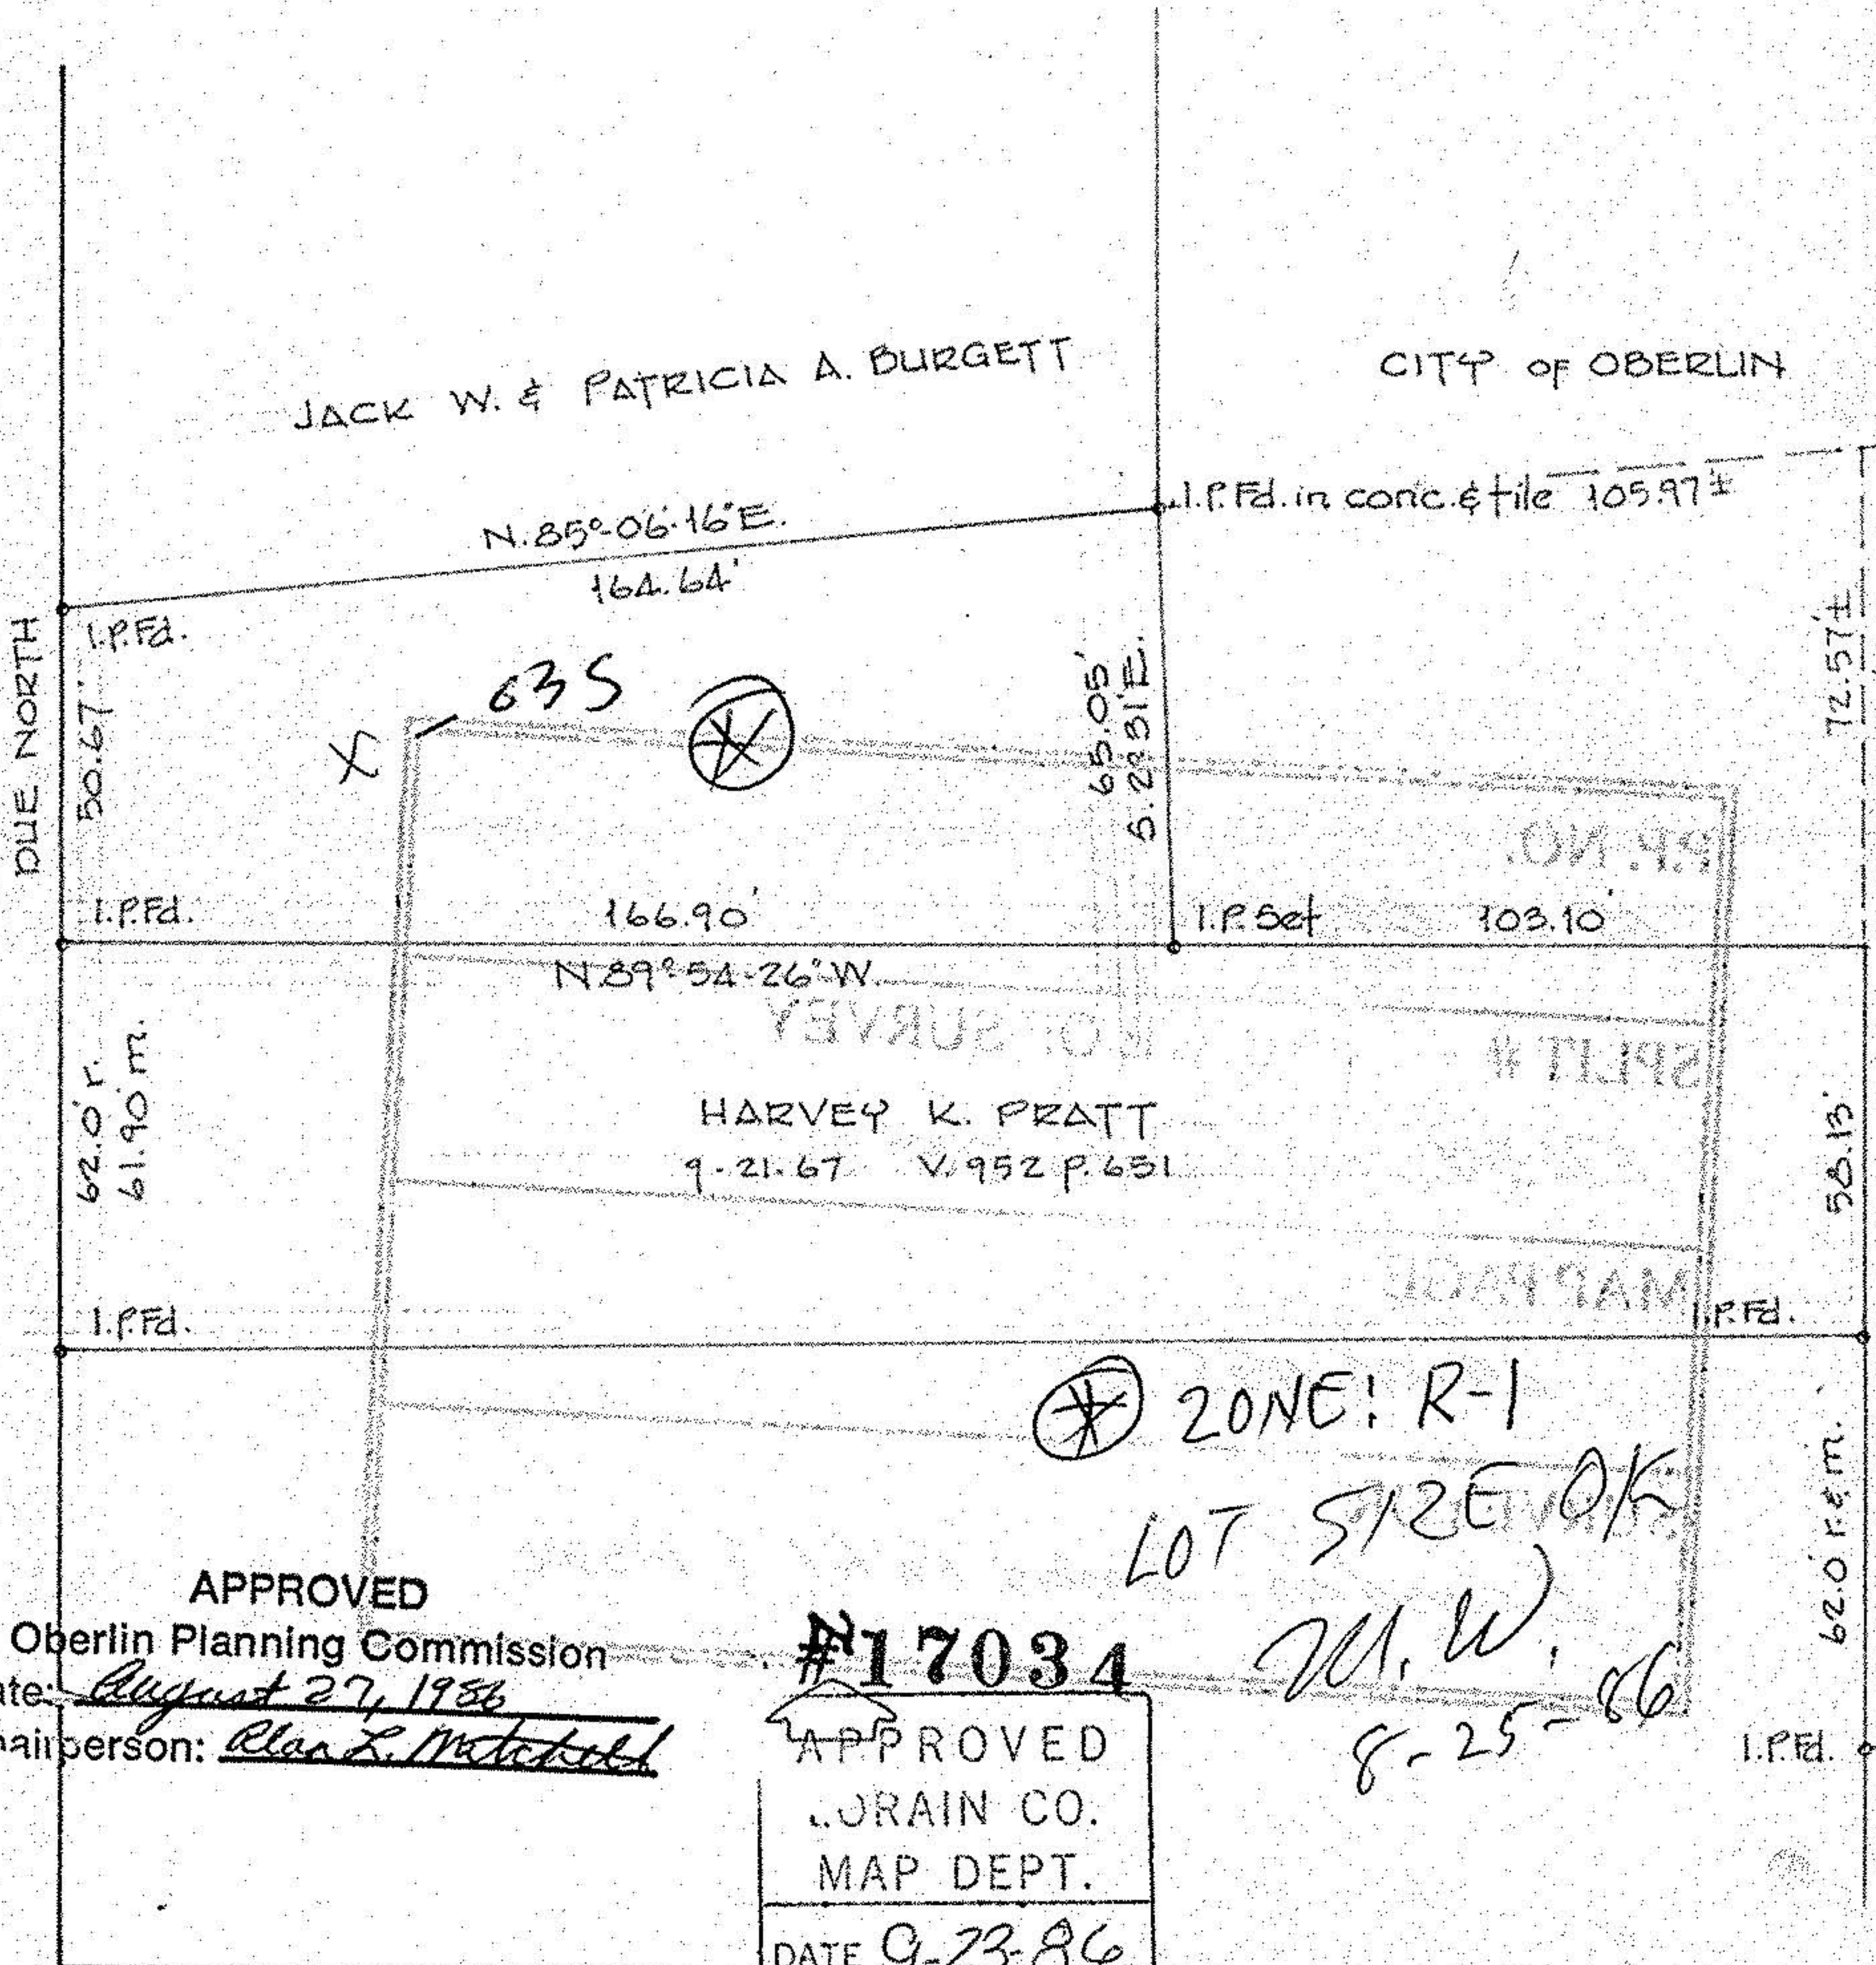

9-00-095-B

APPROVED

Oberlin Planning Commission

Date: August 27, 1986

Chairperson: Alan L. Mitchell

#17034

APPROVED  
LORAIN CO.  
MAP DEPT.

DATE 9-23-86

NOTE:

PAGE 9-00-095-B

BY C. FRANCES

VOID  
AFTER

17034

BEARINGS ARE ASSUMED AND  
USED TO DESCRIBE ANGLES  
ONLY.

LINCOLN ST. 40'